
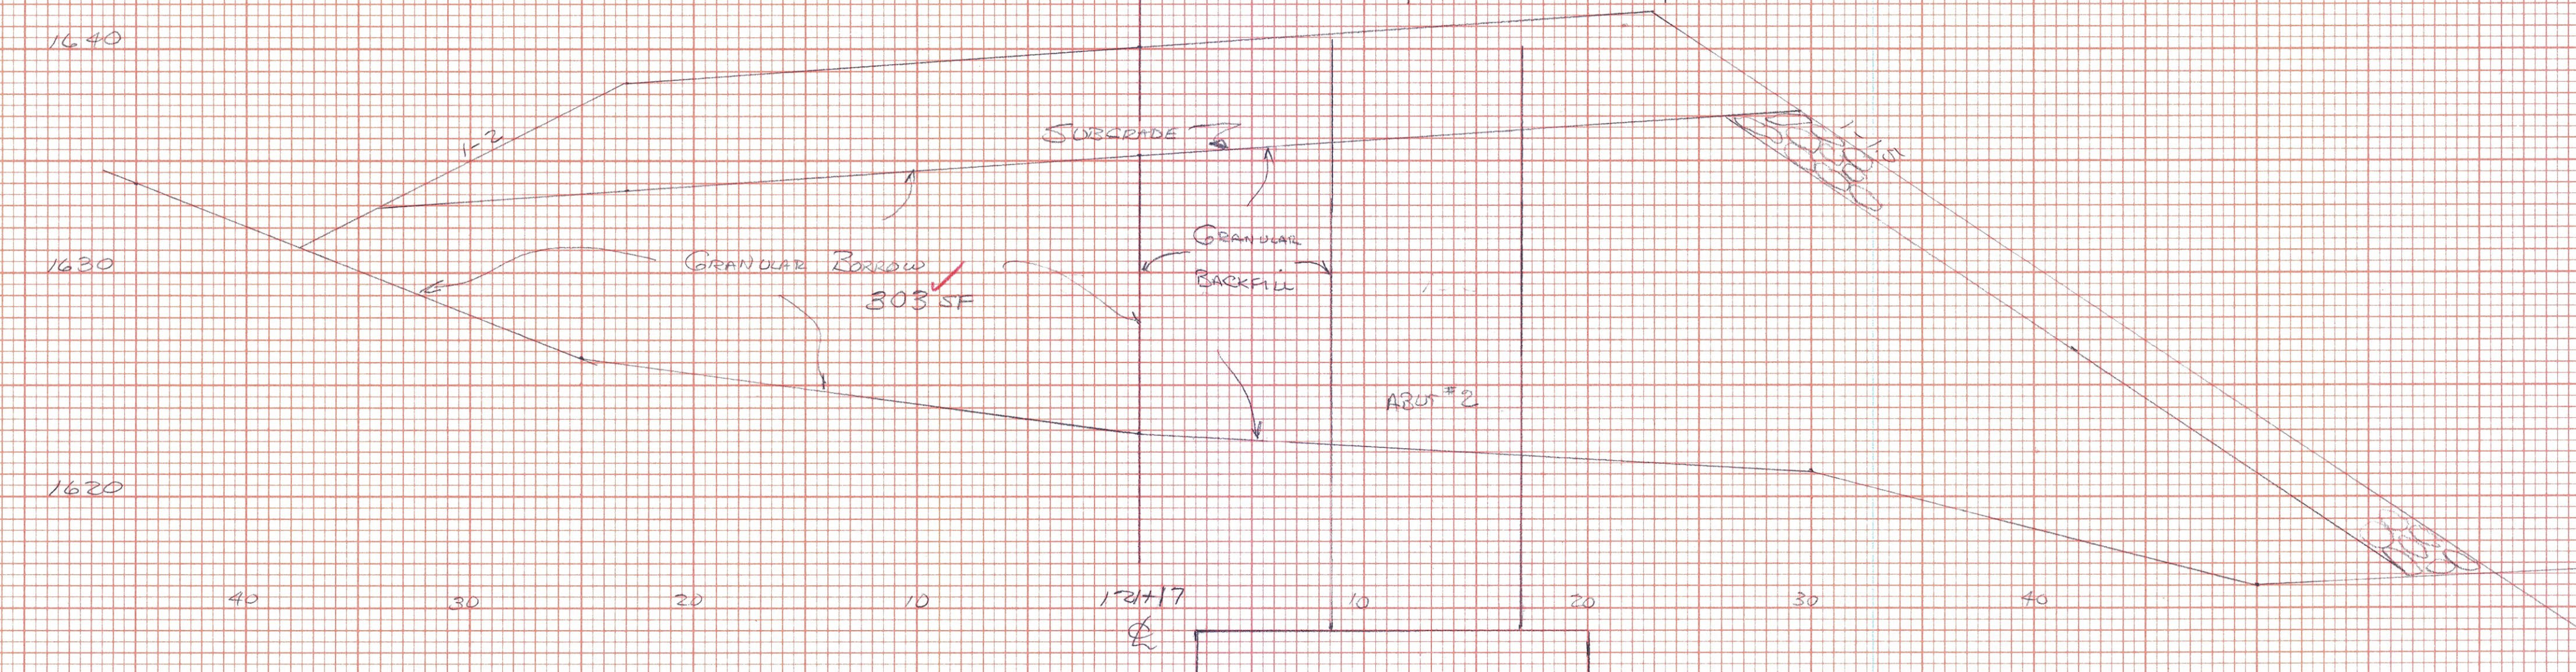
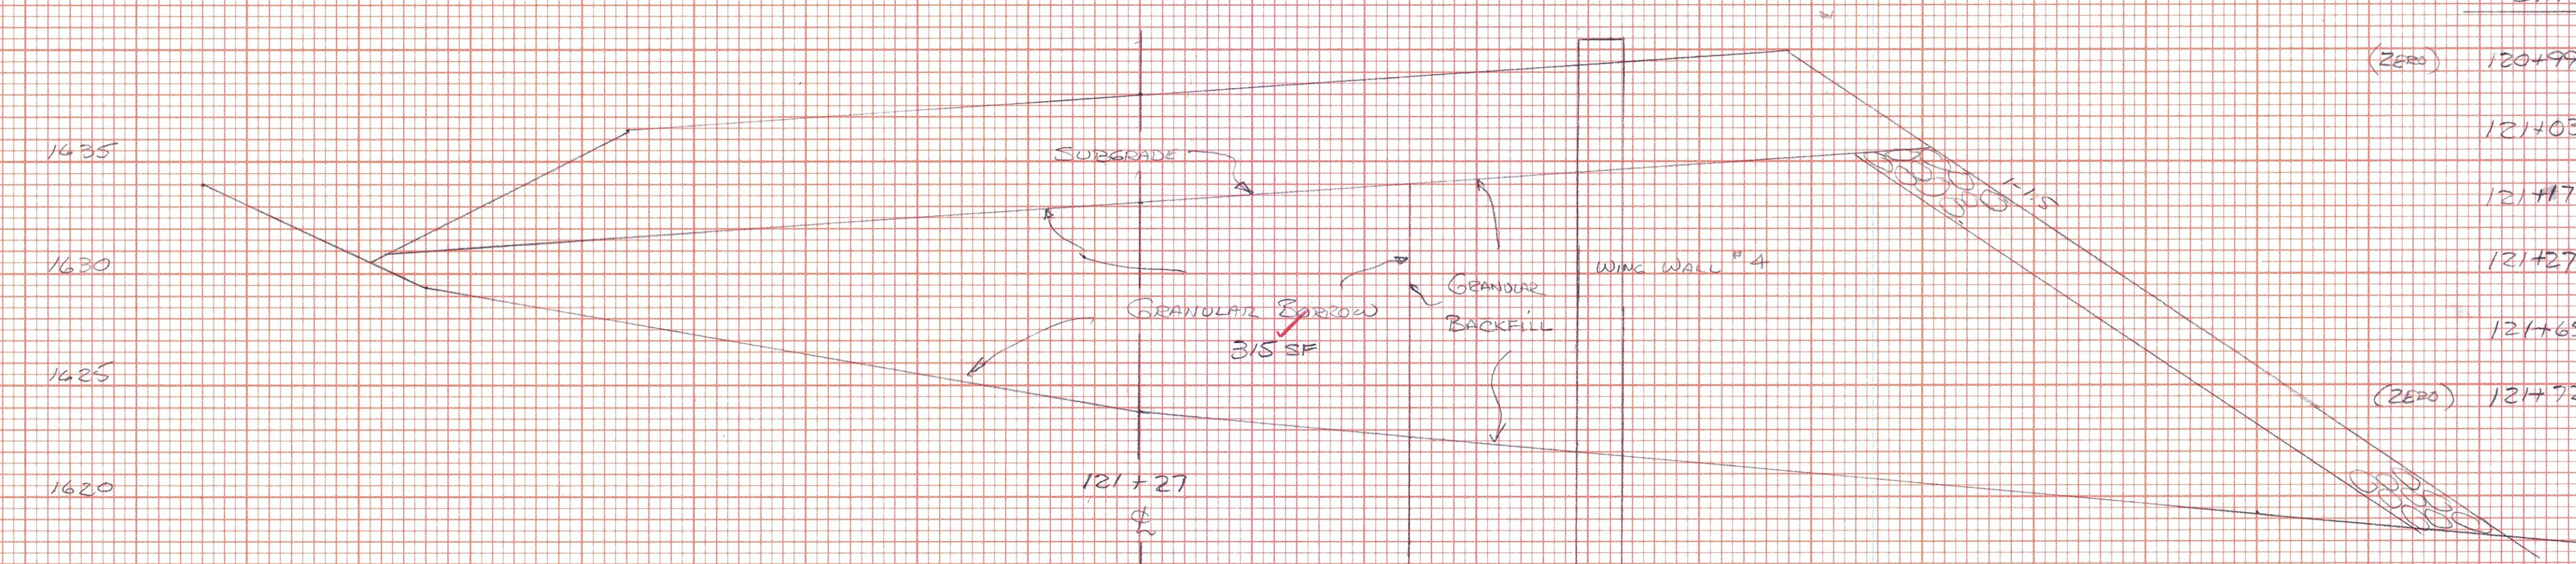


FINAL SURVEY
 SURVEYED
 PLOTTED
 NOTE BOOK
 NO. AREAS CHECKED

ORIGINAL SURVEY
 SURVEYED
 PLOTTED
 NOTE BOOK
 NO. AREAS CHECKED

121+72 - ZERO GRANULAR BORROW ✓

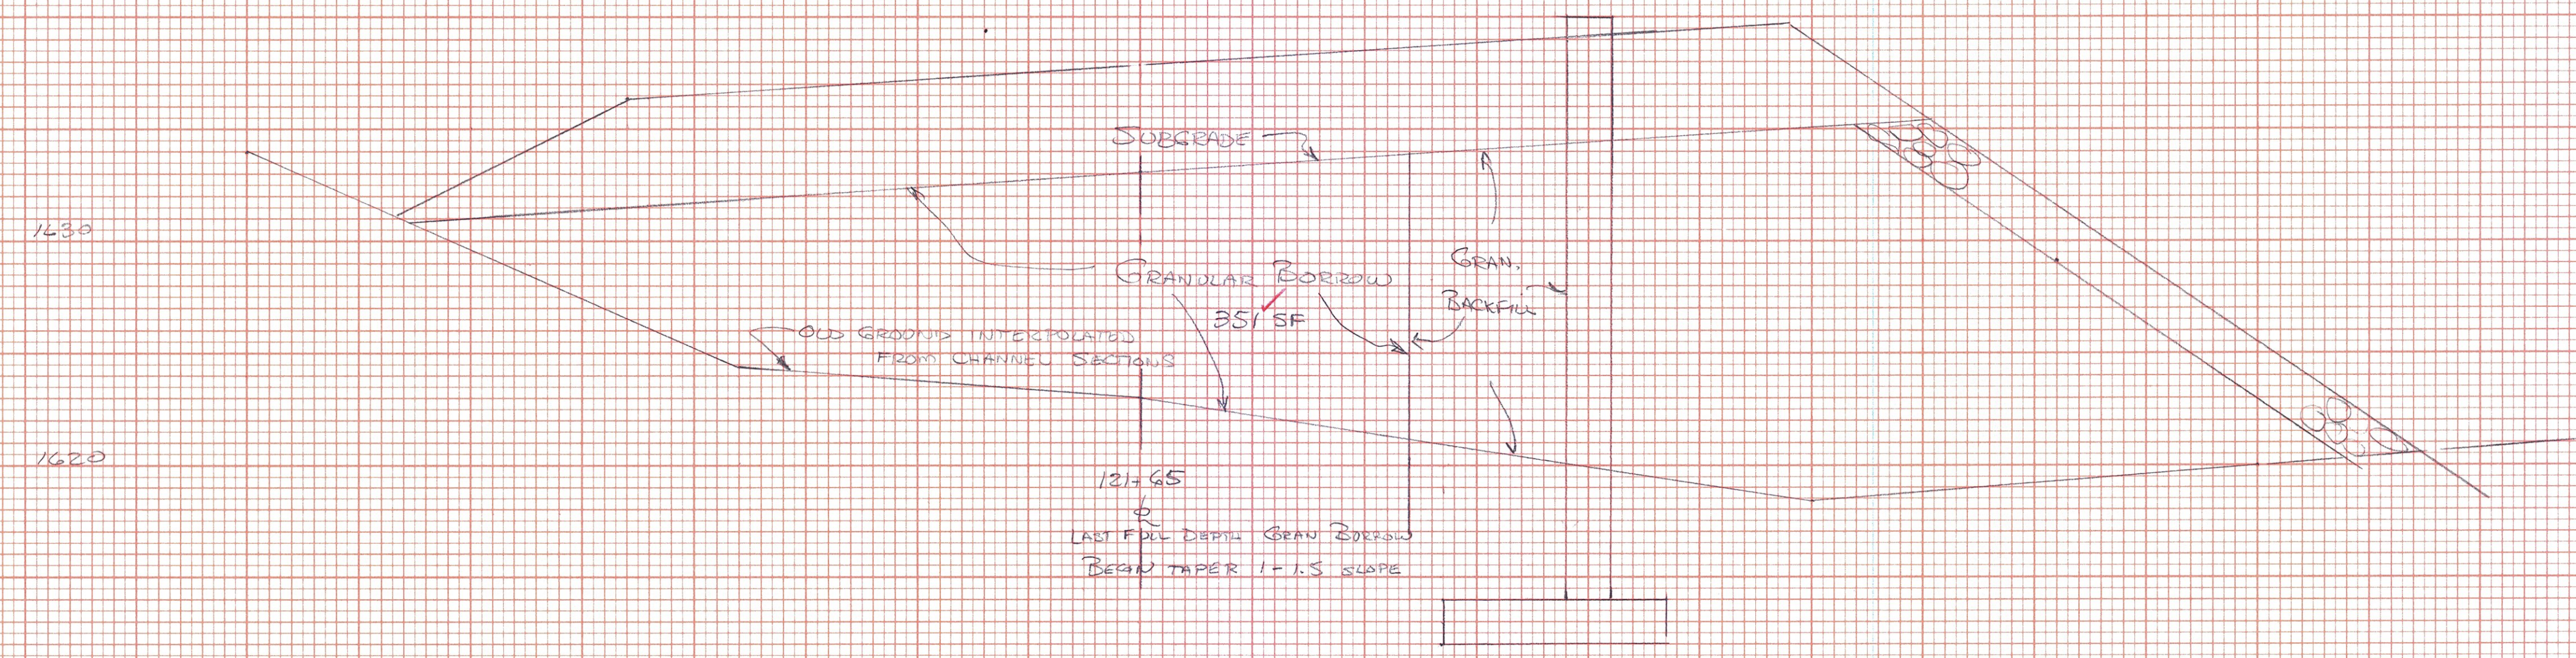

ABUT #2

STA	DIST	AREA	CY
(ZERO)	120+99	0	10.3
	121+03	189	114.6
	121+17	303	114.4
	121+27	315	468.7
	121+65	351	45.5
(ZERO)	121+72	0	
			<u>753.5 CY</u>

BOOK 1 PAGE 131

DC 2-15-05