


FINAL SURVEY
 SURVEYED, PLOTTED, NOTE BOOK, TEMPLATES, NO. AREAS CHECKED

ORIGINAL SURVEY
 SURVEYED, PLOTTED, NOTE BOOK, TEMPLATES, NO. AREAS CHECKED

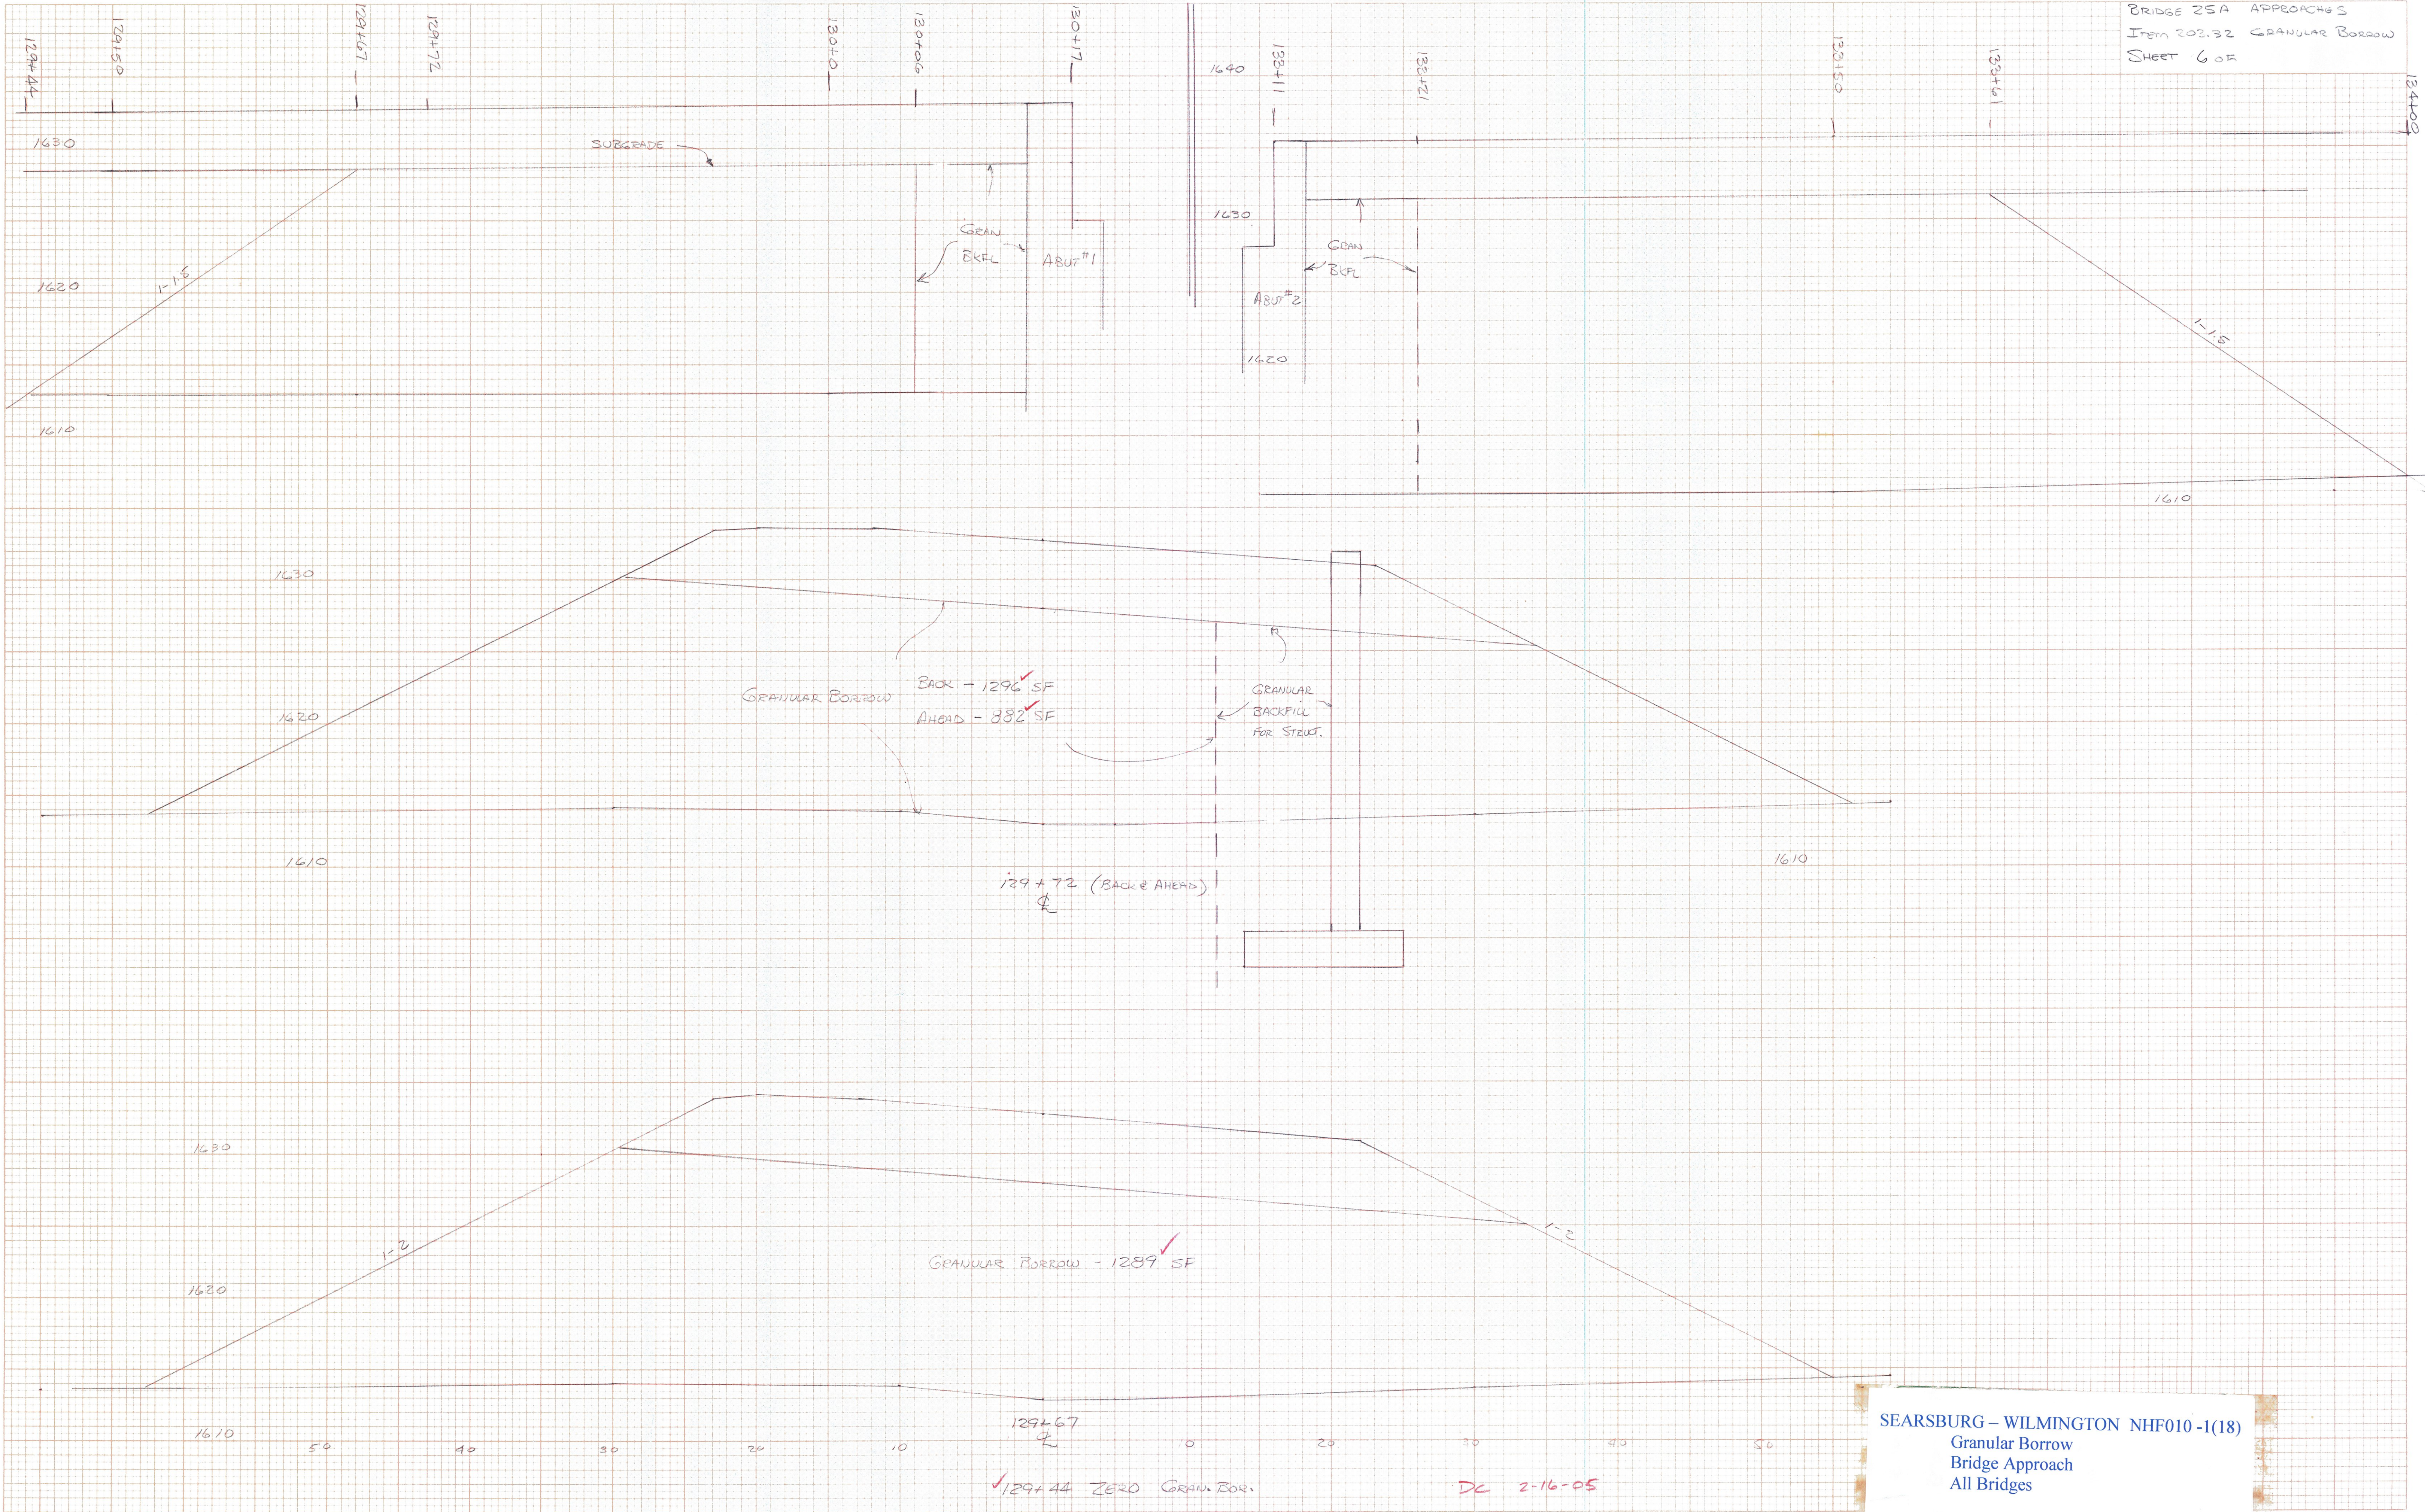

SEARSBURY - WILMINGTON NHF010-1(18)
 Granular Borrow
 Bridge Approach
 All Bridges

129+44 ZERO GRAN. BOR.

DC 2-16-05