


SEARSBURG - WILMINGTON  
 NHF 010-1(18)  
 BRIDGE 25A APPROACHES  
 Item 202.32 GRANULAR BORROW  
 SHEET 8 OF  
 ABUT #2

FINAL SURVEY SHOWN  
 SURVEY SHOWN  
 PLOTTED  
 TEMP. PLATE  
 NO. BOOK  
 NO. AREAS CHECKED


ORIGINAL SURVEY SHOWN  
 SURVEY SHOWN  
 PLOTTED  
 TEMP. PLATE  
 NO. BOOK  
 NO. AREAS CHECKED

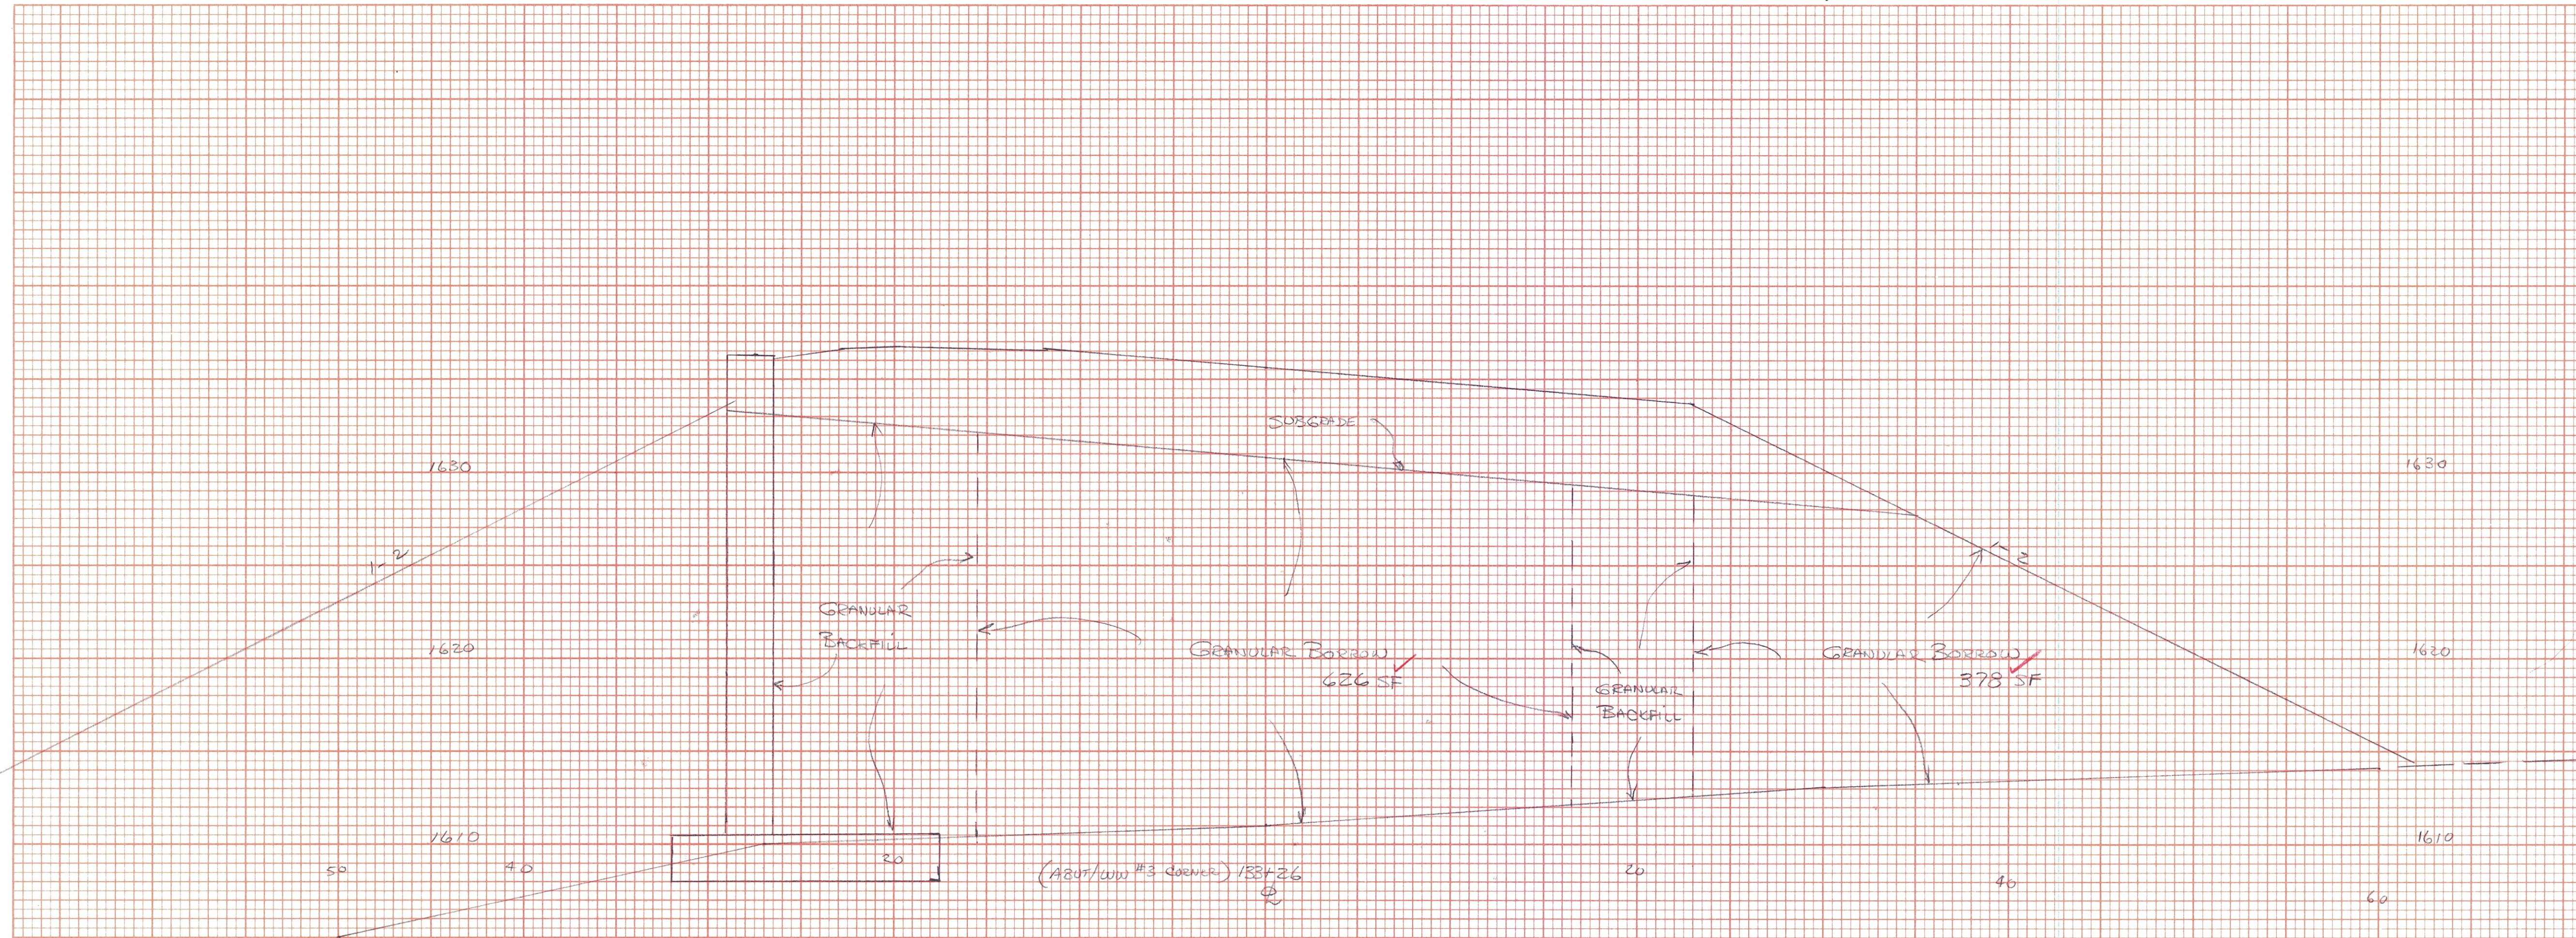

GRANULAR BORROW BR 25A - ABUT #2

STA	Dist	Area	CY
(ZERO) 133+16	5	0	26
133+21	5	278	119
133+26	2	1004	42
(BL) 133+28	0	677	0
(AMB) 133+28	22	1220	1116
(GR) 133+50	0	1520	0
(AMB) 133+50	11	2060	835
133+61	29	2039	1473
(ZERO) 134+0	0	0	
			<u>3621 CY</u>

Book 1 Pg 131

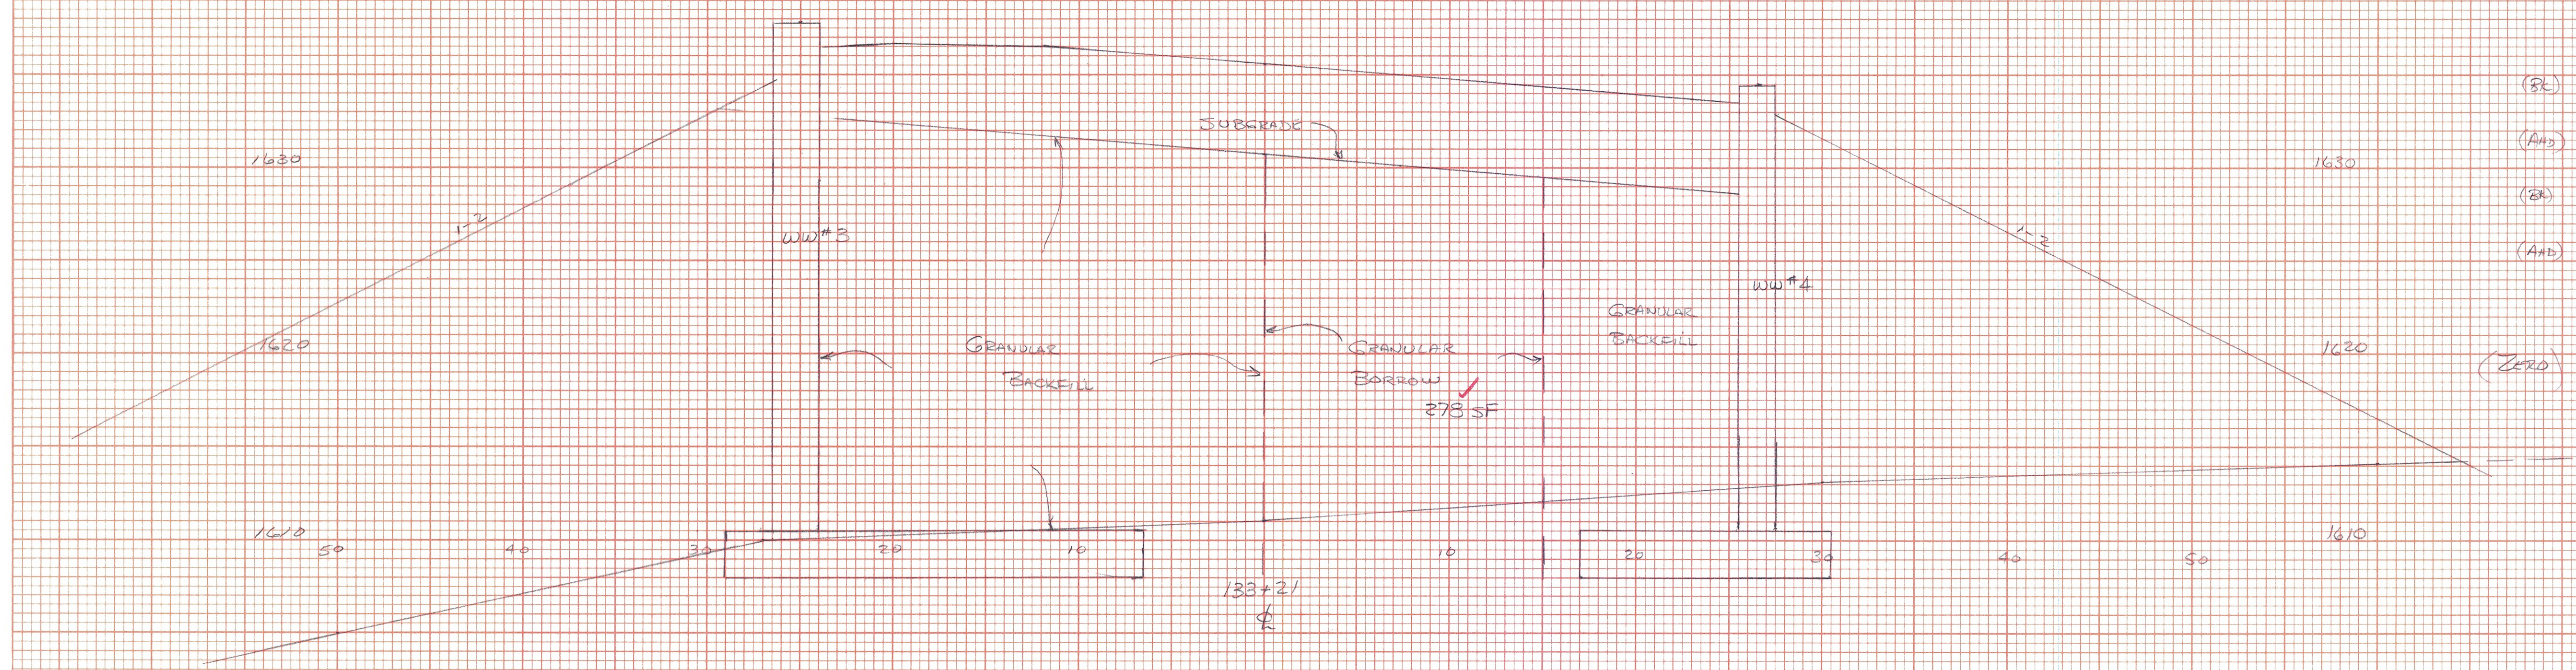

133+16 (ww #4 / Abut)  
 ZERO END AREA

DC 2-17-05