


SEARSBURG - WILMINGTON
 NHF 010 - (18)
 BR 25 B - APPROACHES
 Item 203.32 - GRANULAR BORROW
 SHEET 11 OF

ABUT 1

FINAL SURVEY
 SURVEYED
 PLOTTED
 NOTE BOOK
 NO. AREAS CHECKED

ORIGINAL SURVEY
 SURVEYED
 PLOTTED
 NOTE BOOK
 NO. AREAS CHECKED

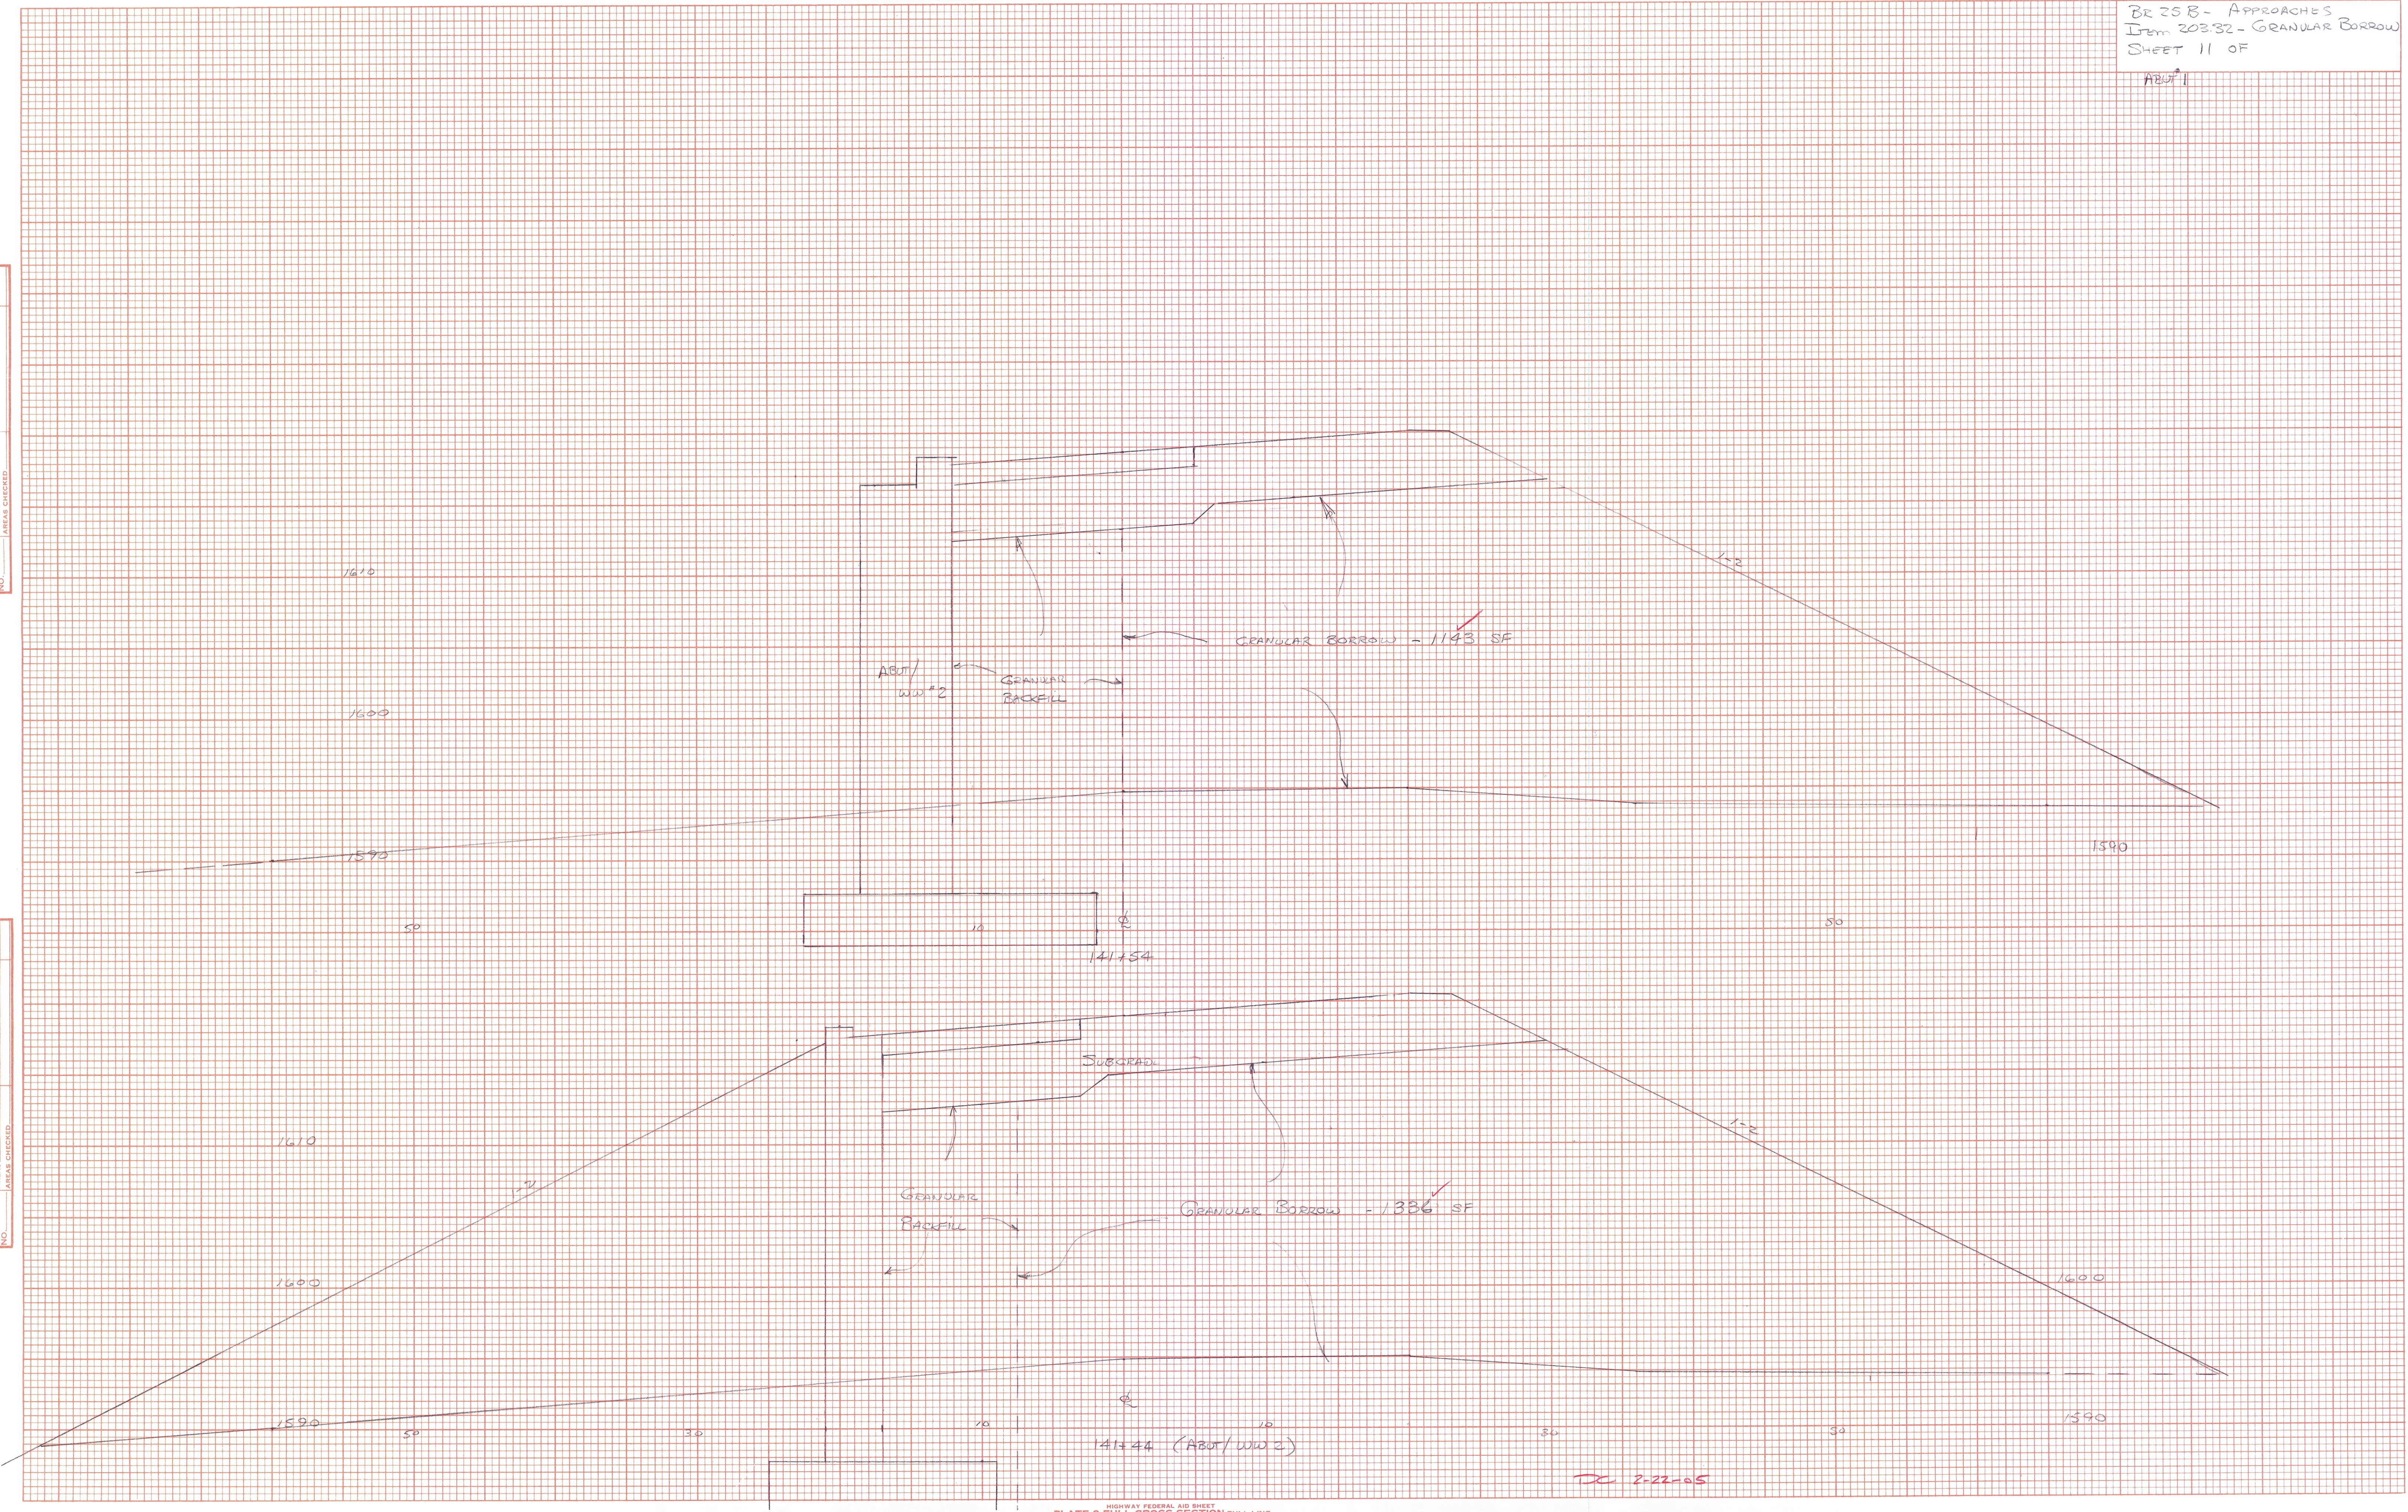

2-22-05