

FINAL SURVEY BY DATE  
 SURVEYED BY DATE  
 PLOTTED BY DATE  
 NOTE BOOK NO. TEMPLATE NO. AREAS CHECKED


ORIGINAL SURVEY BY DATE  
 SURVEYED BY DATE  
 PLOTTED BY DATE  
 NOTE BOOK NO. TEMPLATE NO. AREAS CHECKED

GRANULAR BORROW - ABUT 1 APPROACH

STA	Dist	AREA	CY
140+94		0	
141+24	30	1329	738
141+44	20	1336	987
141+54	10	1143	459
141+61 B	7	1056	285
141+61 A	0	92	0
141+66	5	0	9

2478 CY Book 1 Page 131

141+66  
 ZERO GRANULAR BORROW

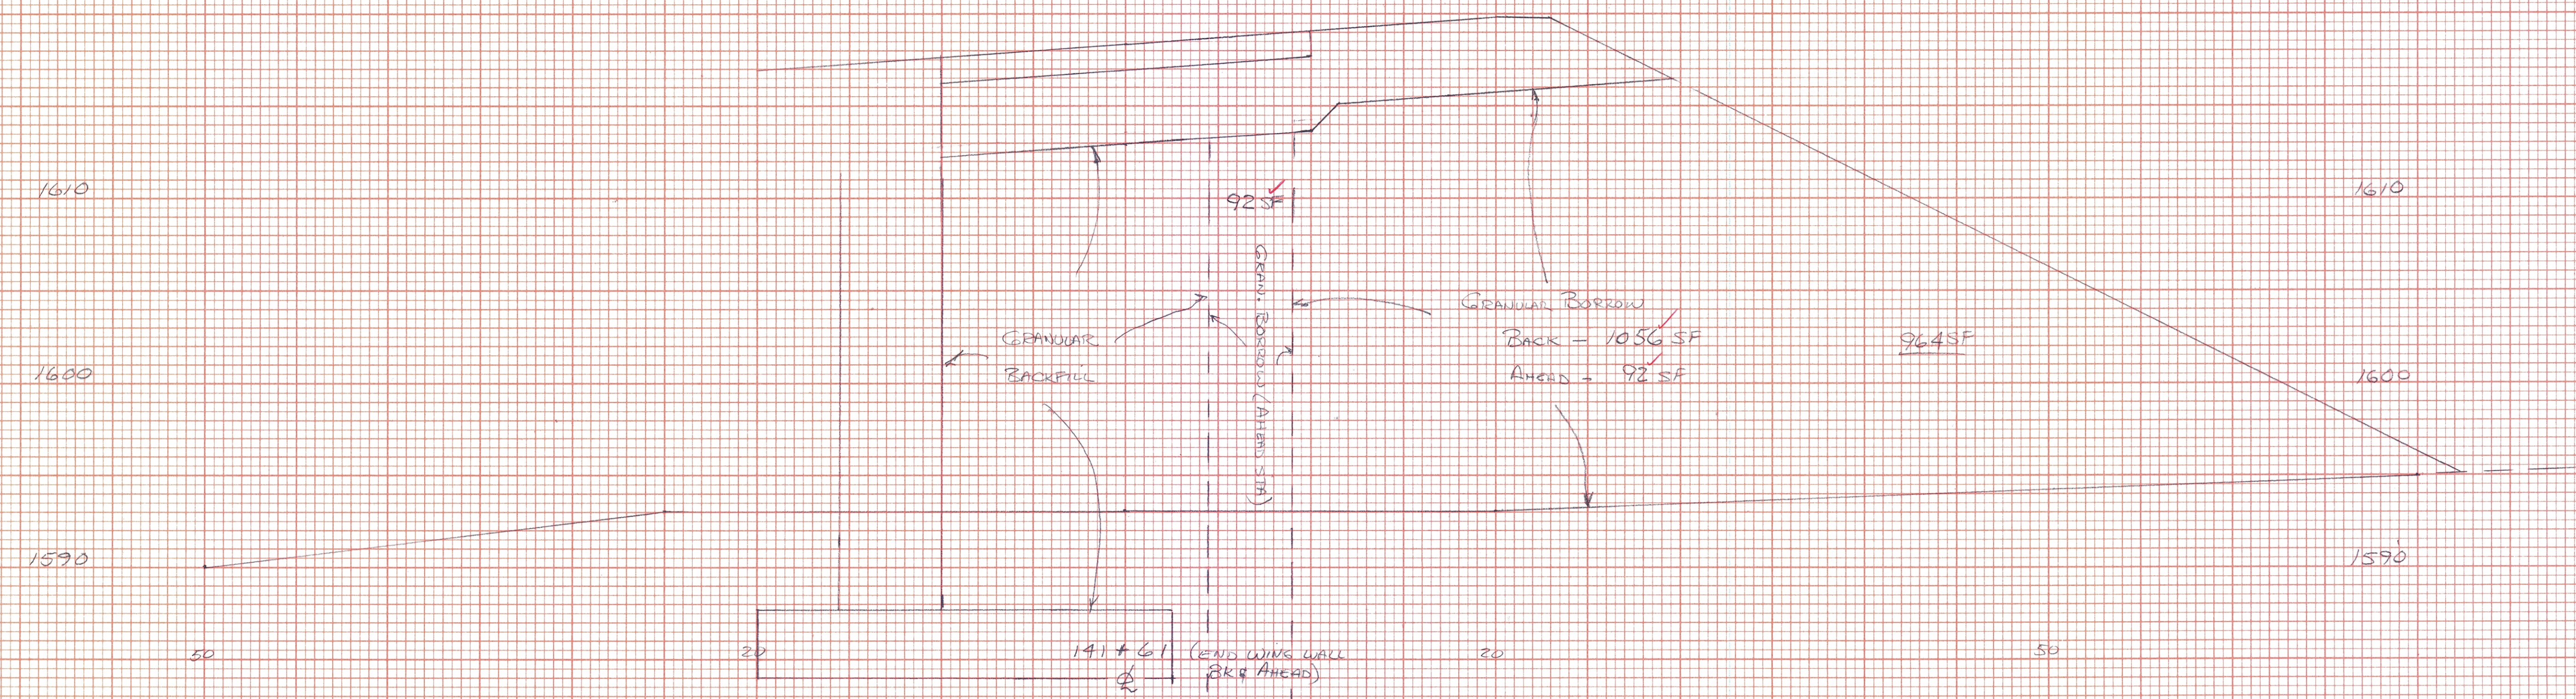

DC 2-22-05