


FINAL SURVEY
 SURVEYED, PLOTTED, RECALCULATED, NOTE BOOK, TAPES, NO. AREAS CHECKED.



ORIGINAL SURVEY
 SURVEYED, PLOTTED, RECALCULATED, NOTE BOOK, TAPES, NO. AREAS CHECKED.

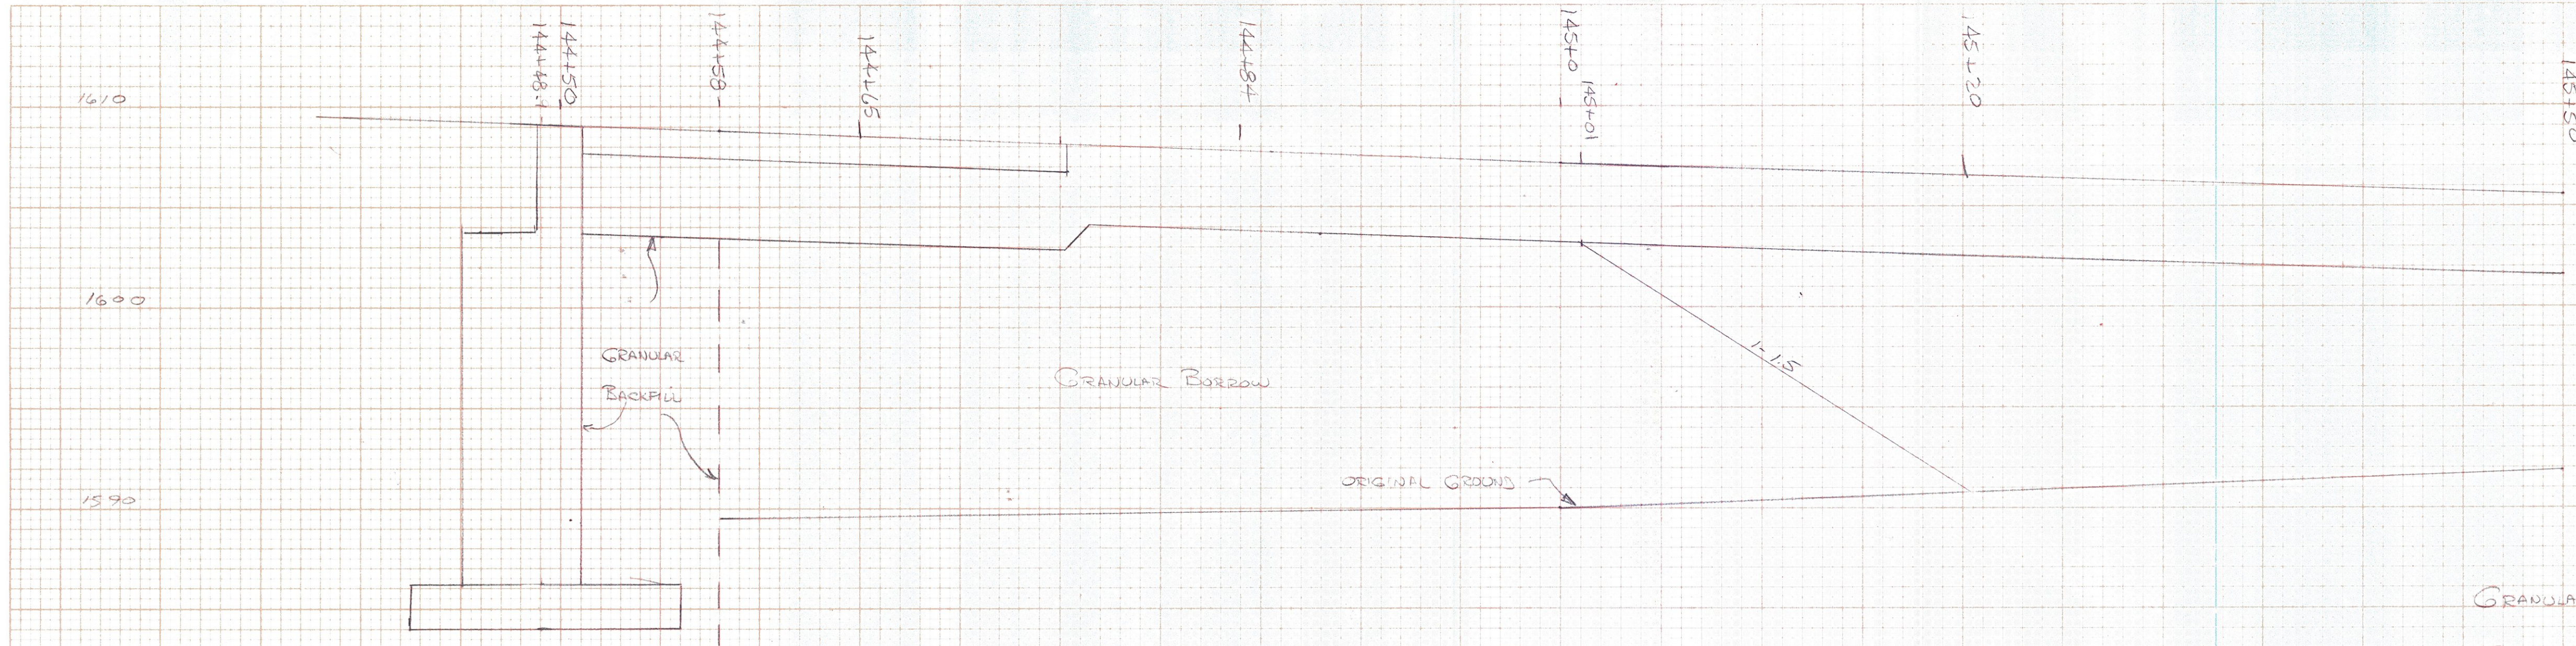

GRANULAR BORROW - ABUT #2 APPROACH

STA	Dist	Area	CY
(Butt)	144+51	206	68
	144+58	321	96
	144+65	420	296
	144+84 (BA)	421	0
	144+84 (AMB)	850	534
	145+01	345	297
(Zero)	145+20	0	
			<u>1291 CY</u>

Ex. 1 Page 131

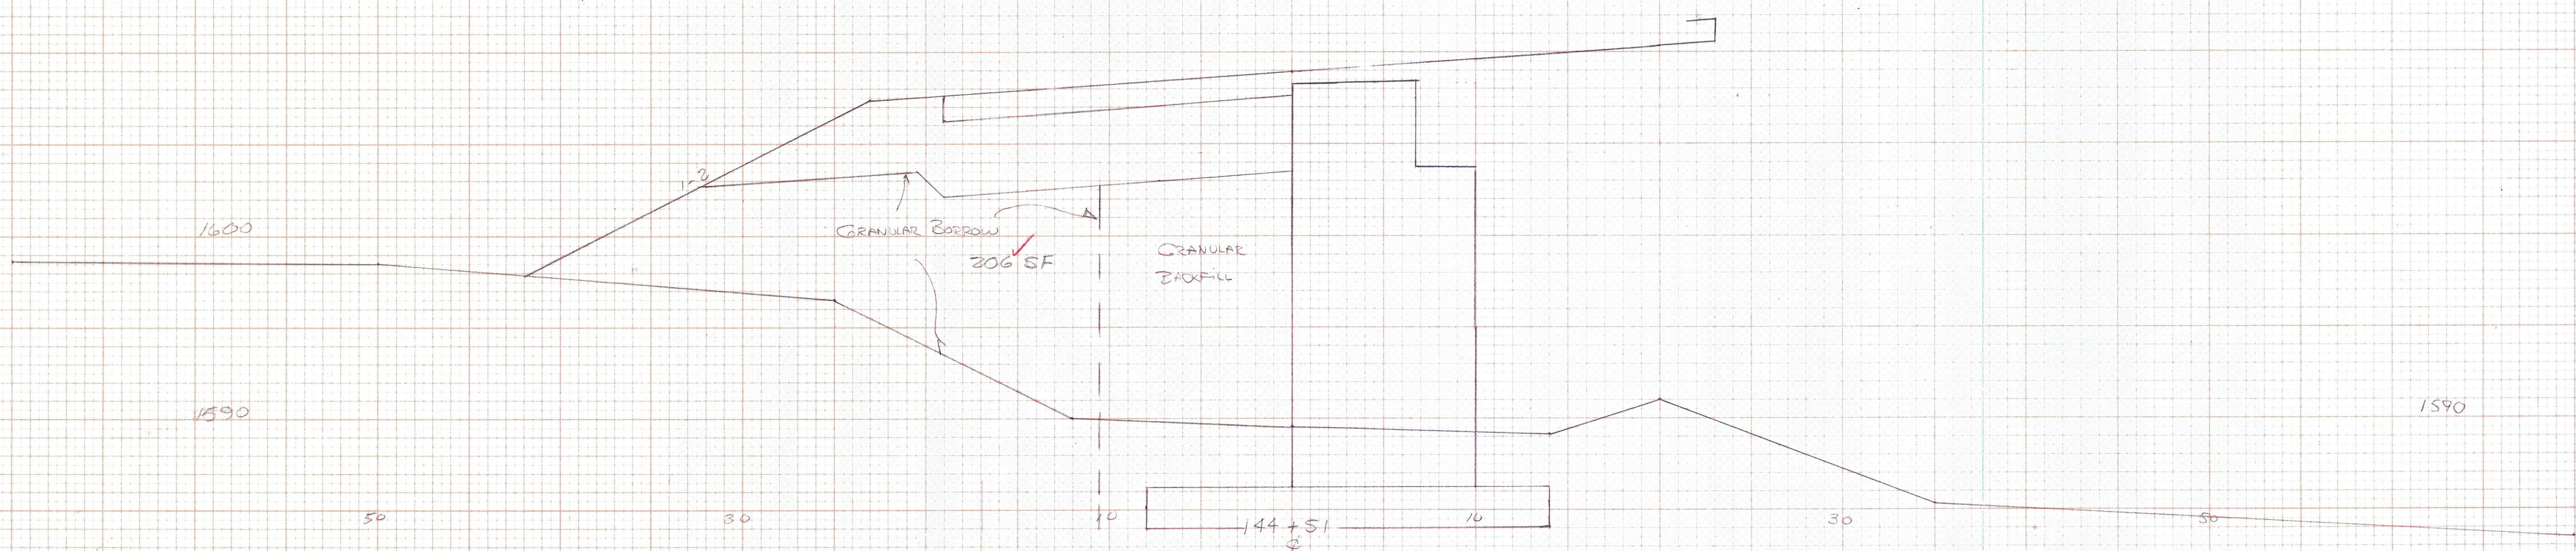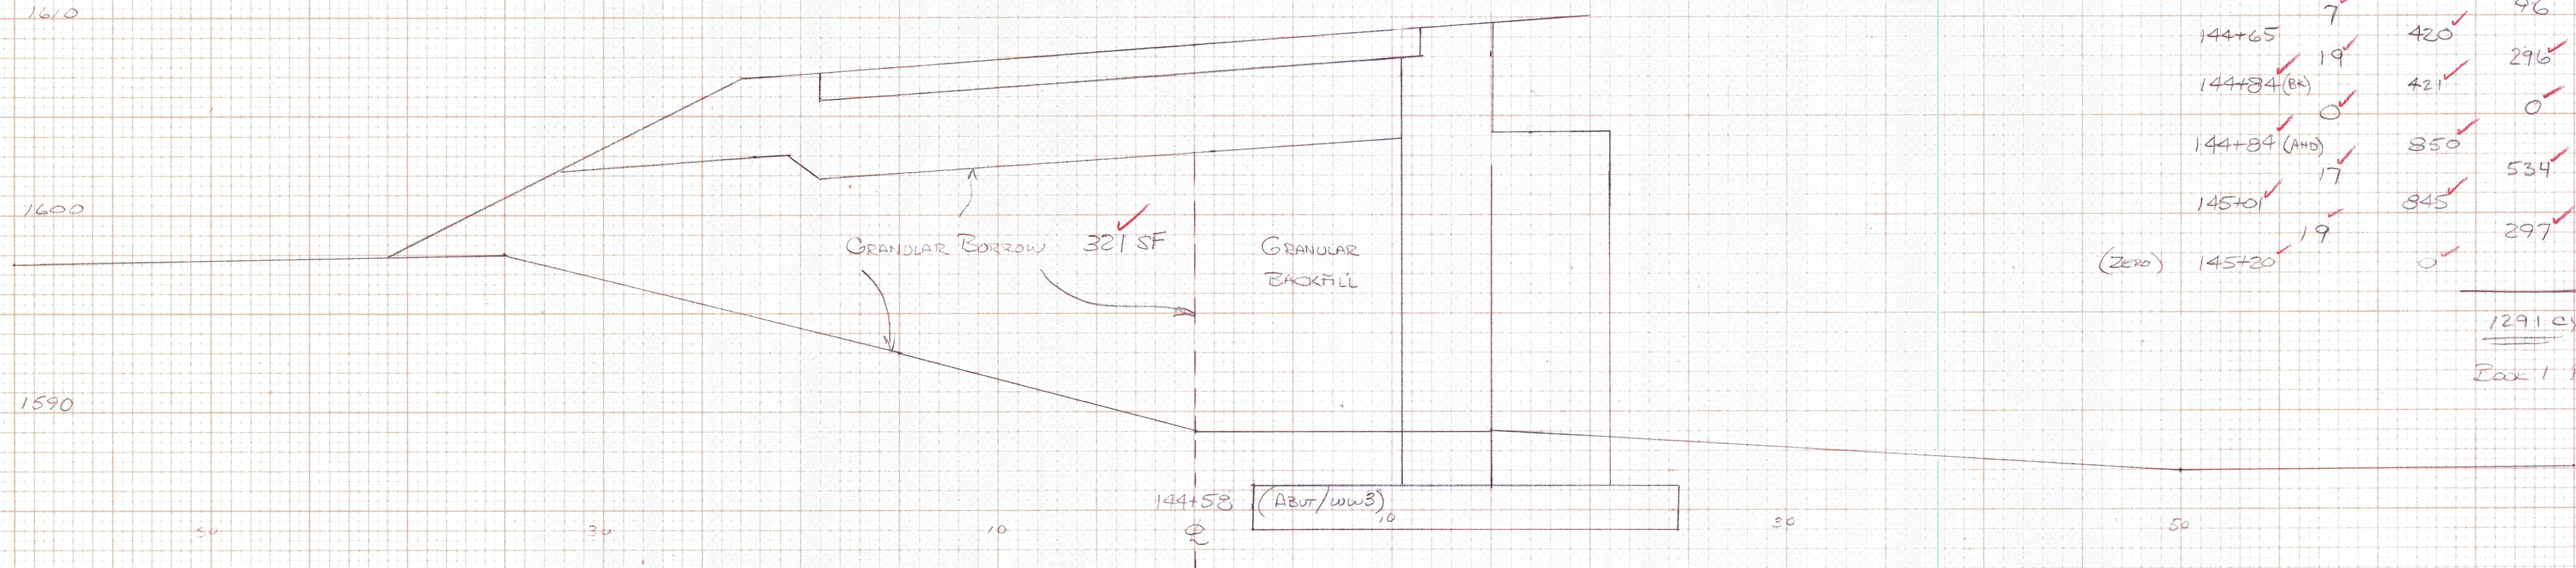

DC 2-22-85