


FINAL SURVEY BY DATE
 SURVEYED BY DATE
 NOTE BOOK, PART NO.
 AREA CHECKED

ORIGINAL SURVEY BY DATE
 SURVEYED BY DATE
 NOTE BOOK, PART NO.
 AREA CHECKED

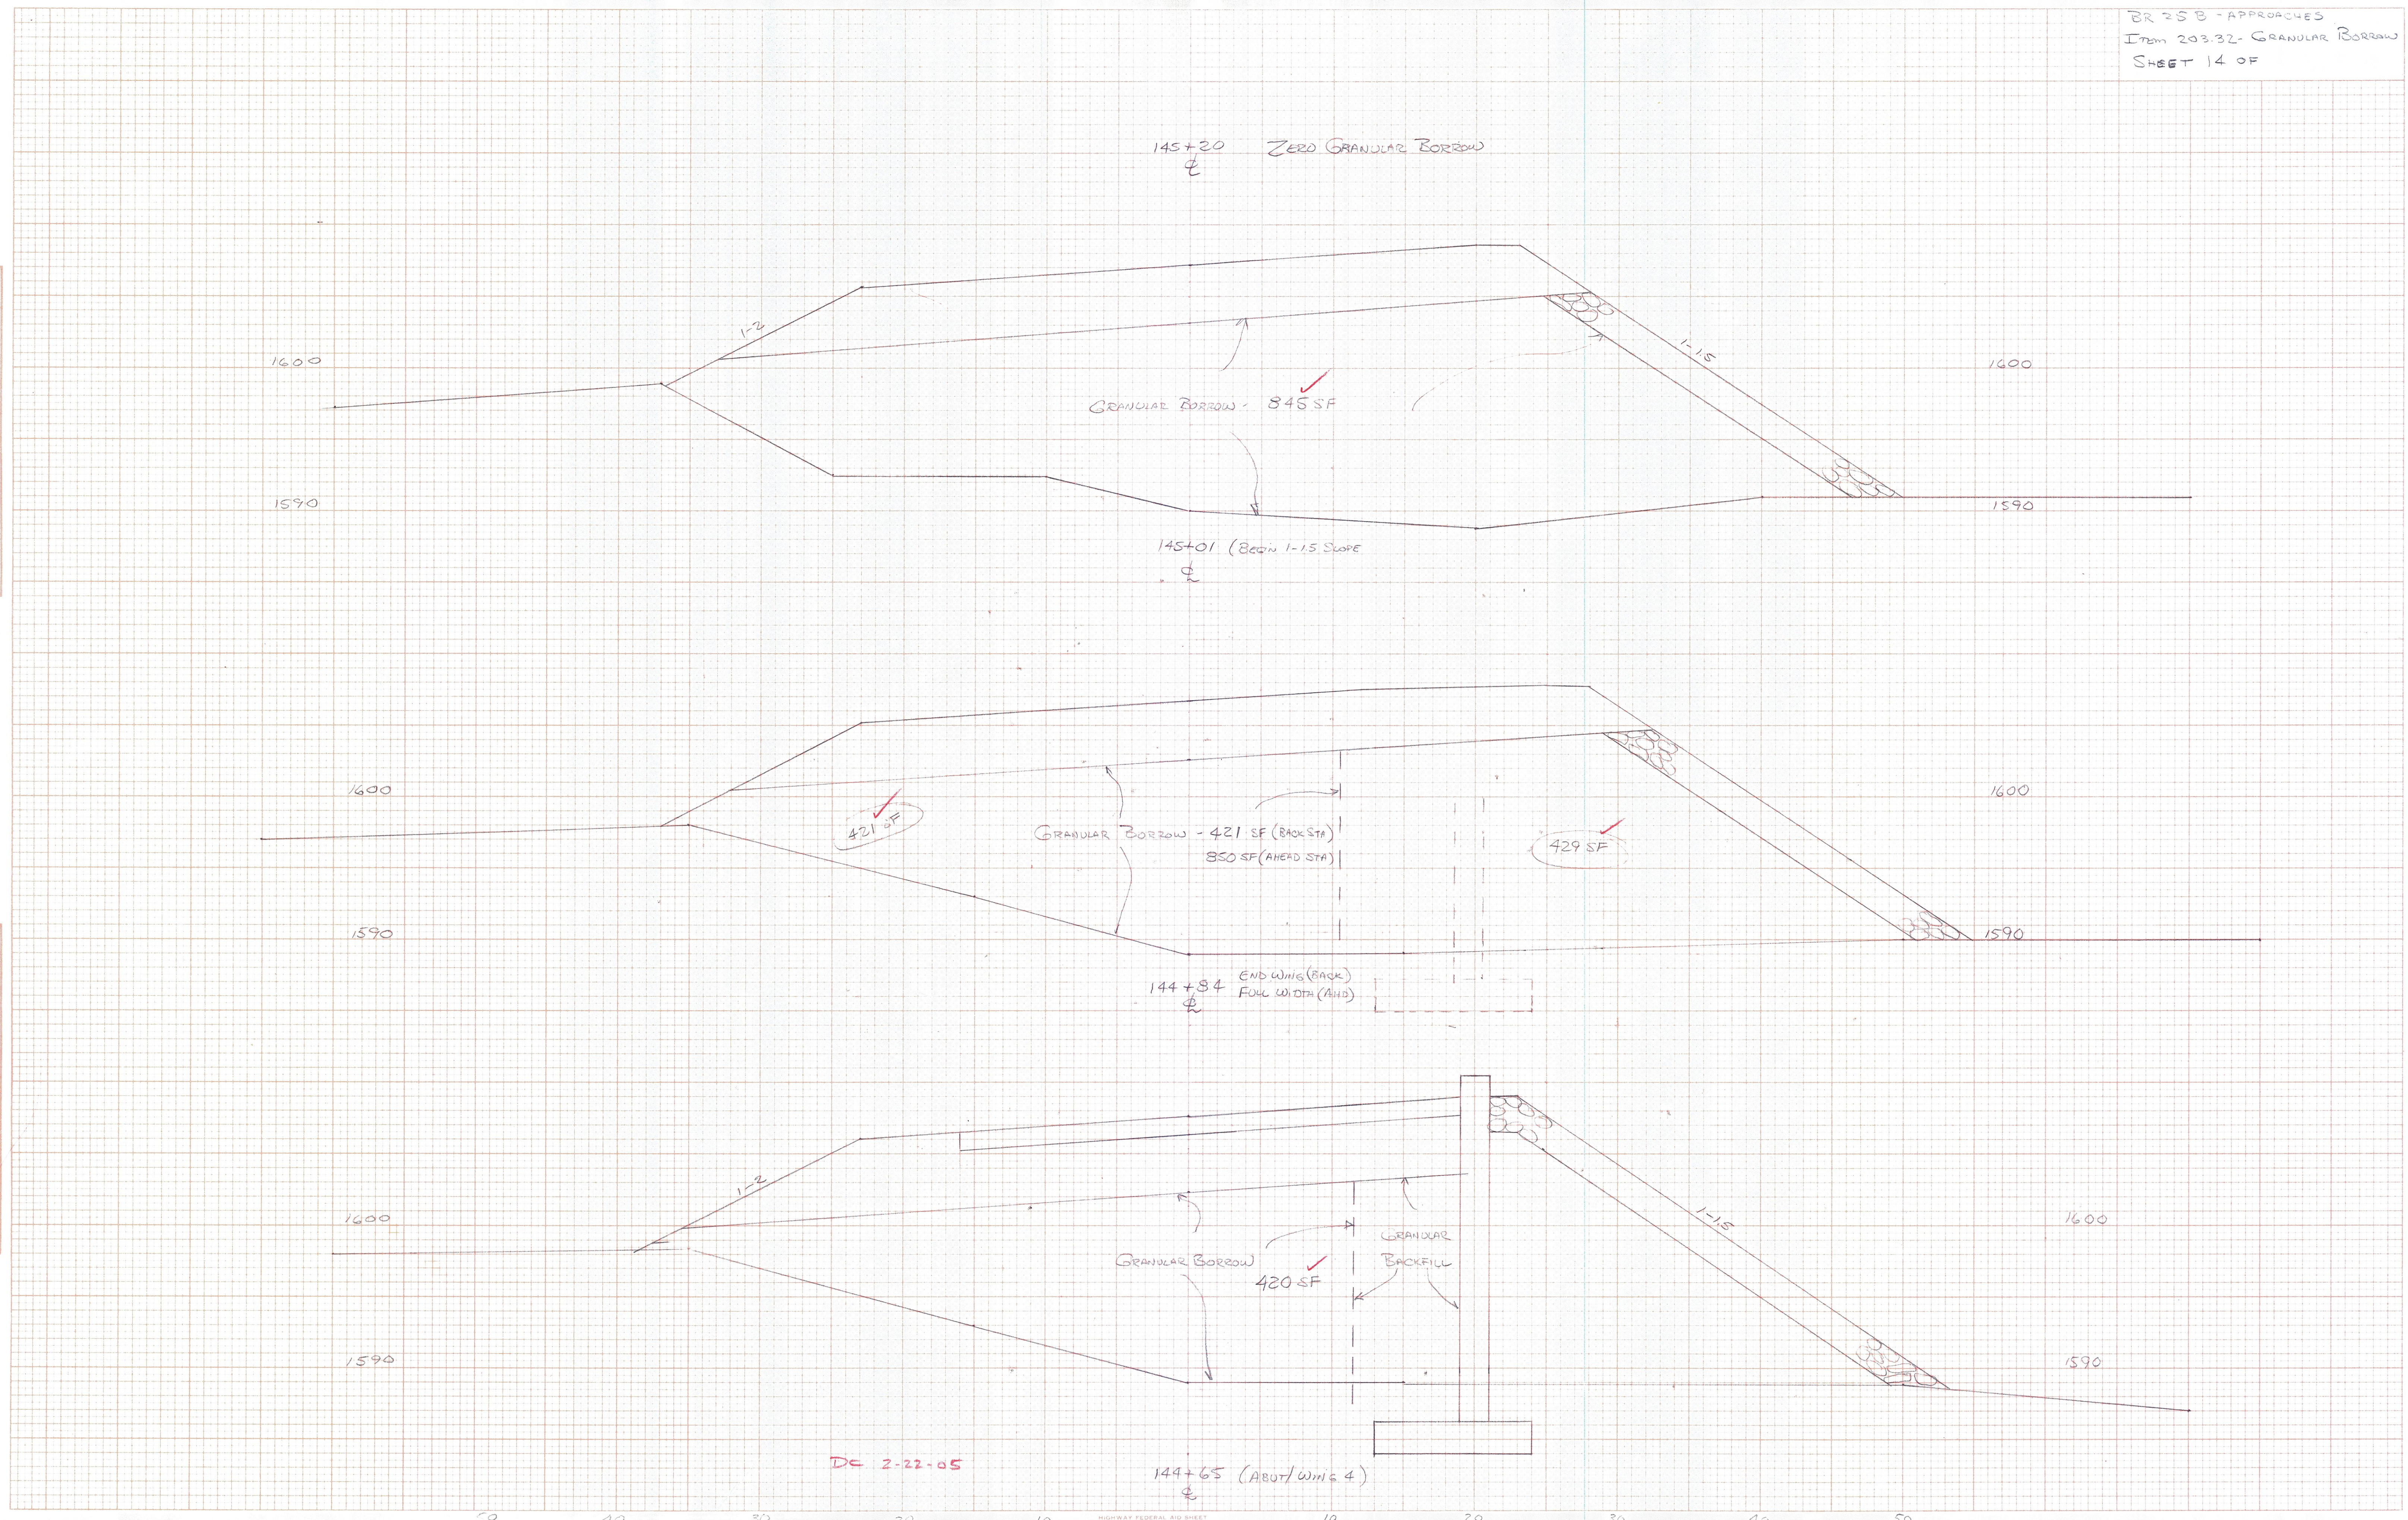

DC 2-22-05