


FINAL SURVEY NO. _____
 BY _____ DATE _____
 QUANTITY PLOTTED _____
 TEMPLATE _____
 NOTE BOOK _____
 AREAS CHECKED _____
 INDEX CHECKED _____

ORIGINAL SURVEY NO. _____
 BY _____ DATE _____
 QUANTITY PLOTTED _____
 TEMPLATE _____
 NOTE BOOK _____
 AREAS CHECKED _____
 INDEX CHECKED _____

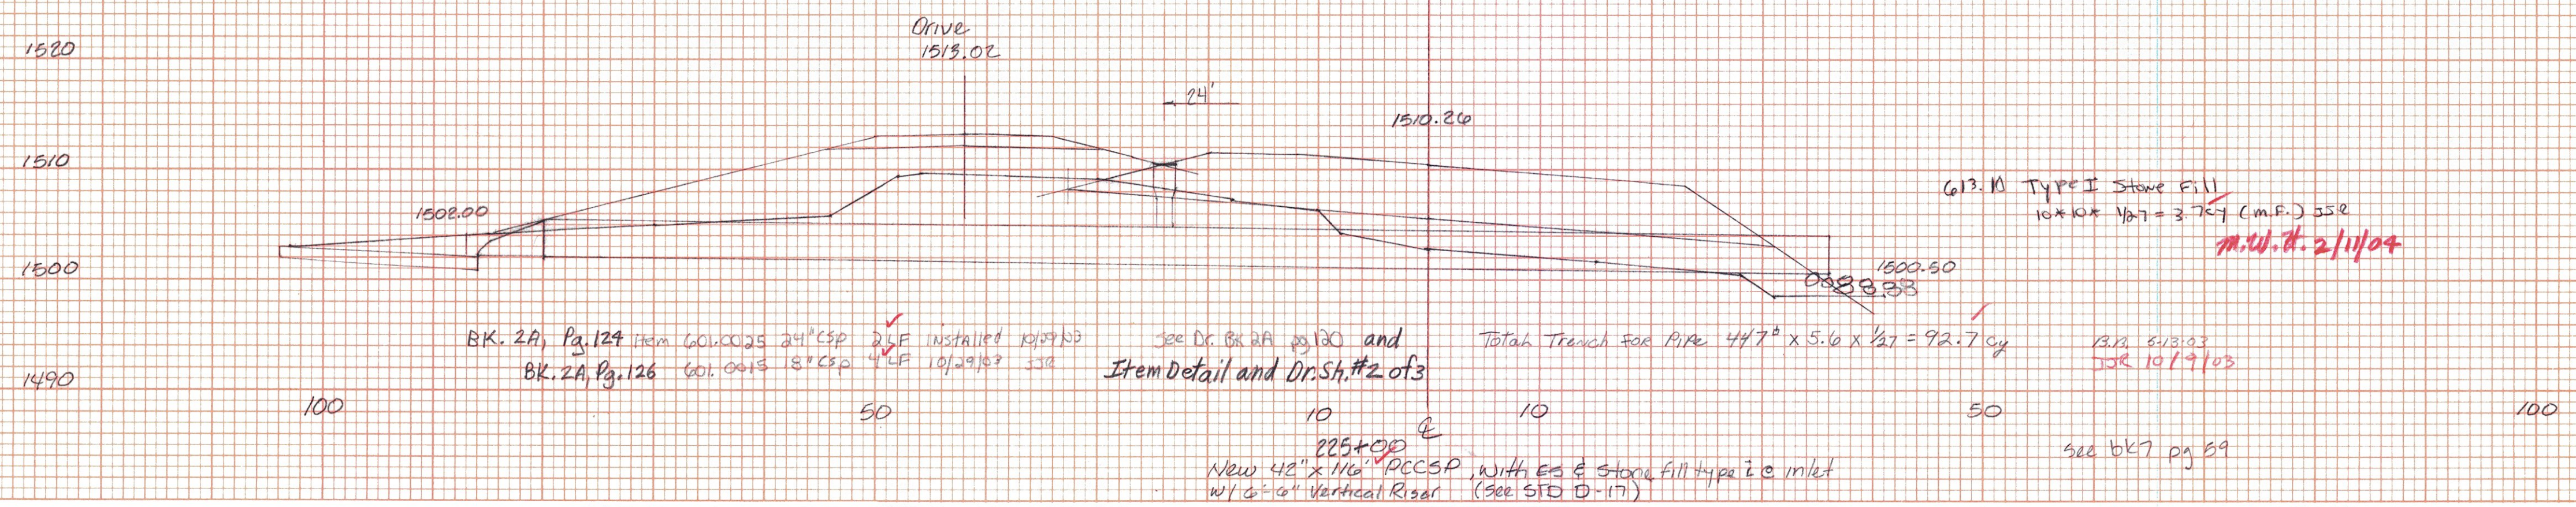

Searsburg - Wilmington
 Drainage Sheet 13 of 27
 New 42" 225+00 E and LT

SEARSBURG - WILMINGTON
 (NH) FORM 100