

FINAL SURVEY
 SURVEYED
 PLOTTED
 NOTE BOOK
 NO. _____
 AREA CHECKED


ORIGINAL SURVEY
 SURVEYED
 PLOTTED
 NOTE BOOK
 NO. _____
 AREA CHECKED

BY _____

BY _____


DATE _____

DATE _____

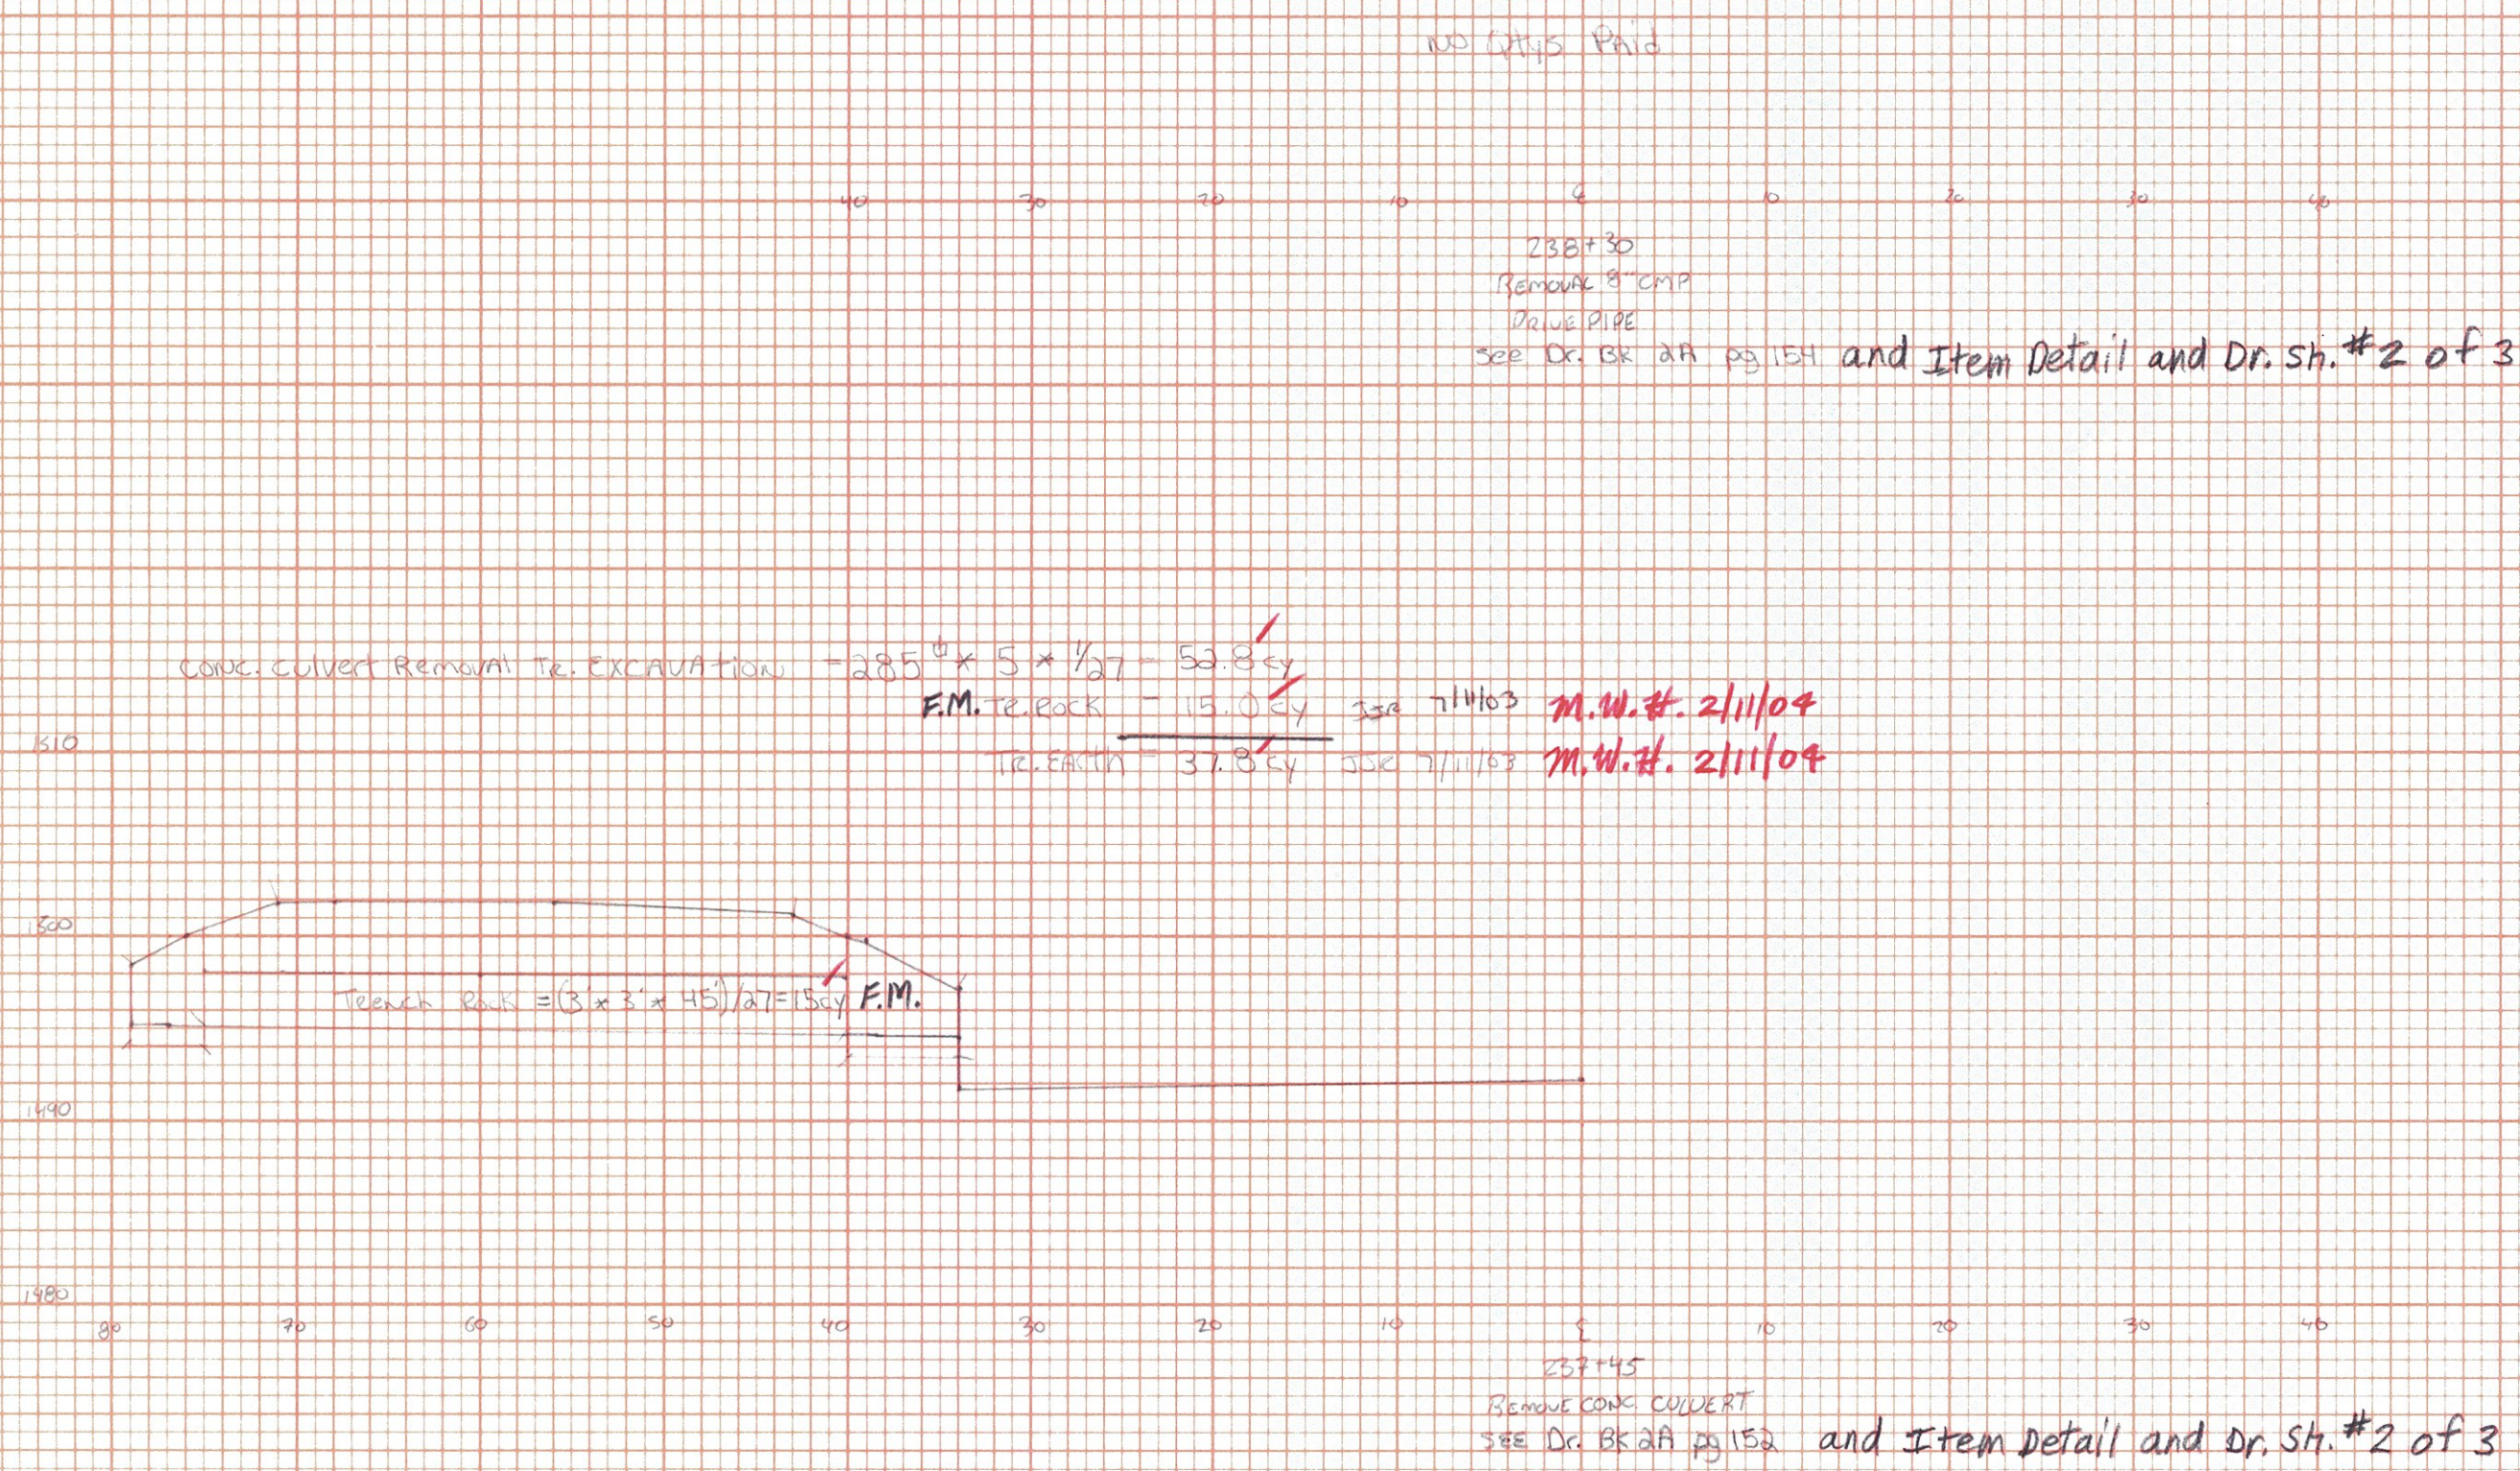

System All in EIL
 231+10
 NEW 18\"/>

NO CURB PAID
 237+45
 Remove 8\"/>

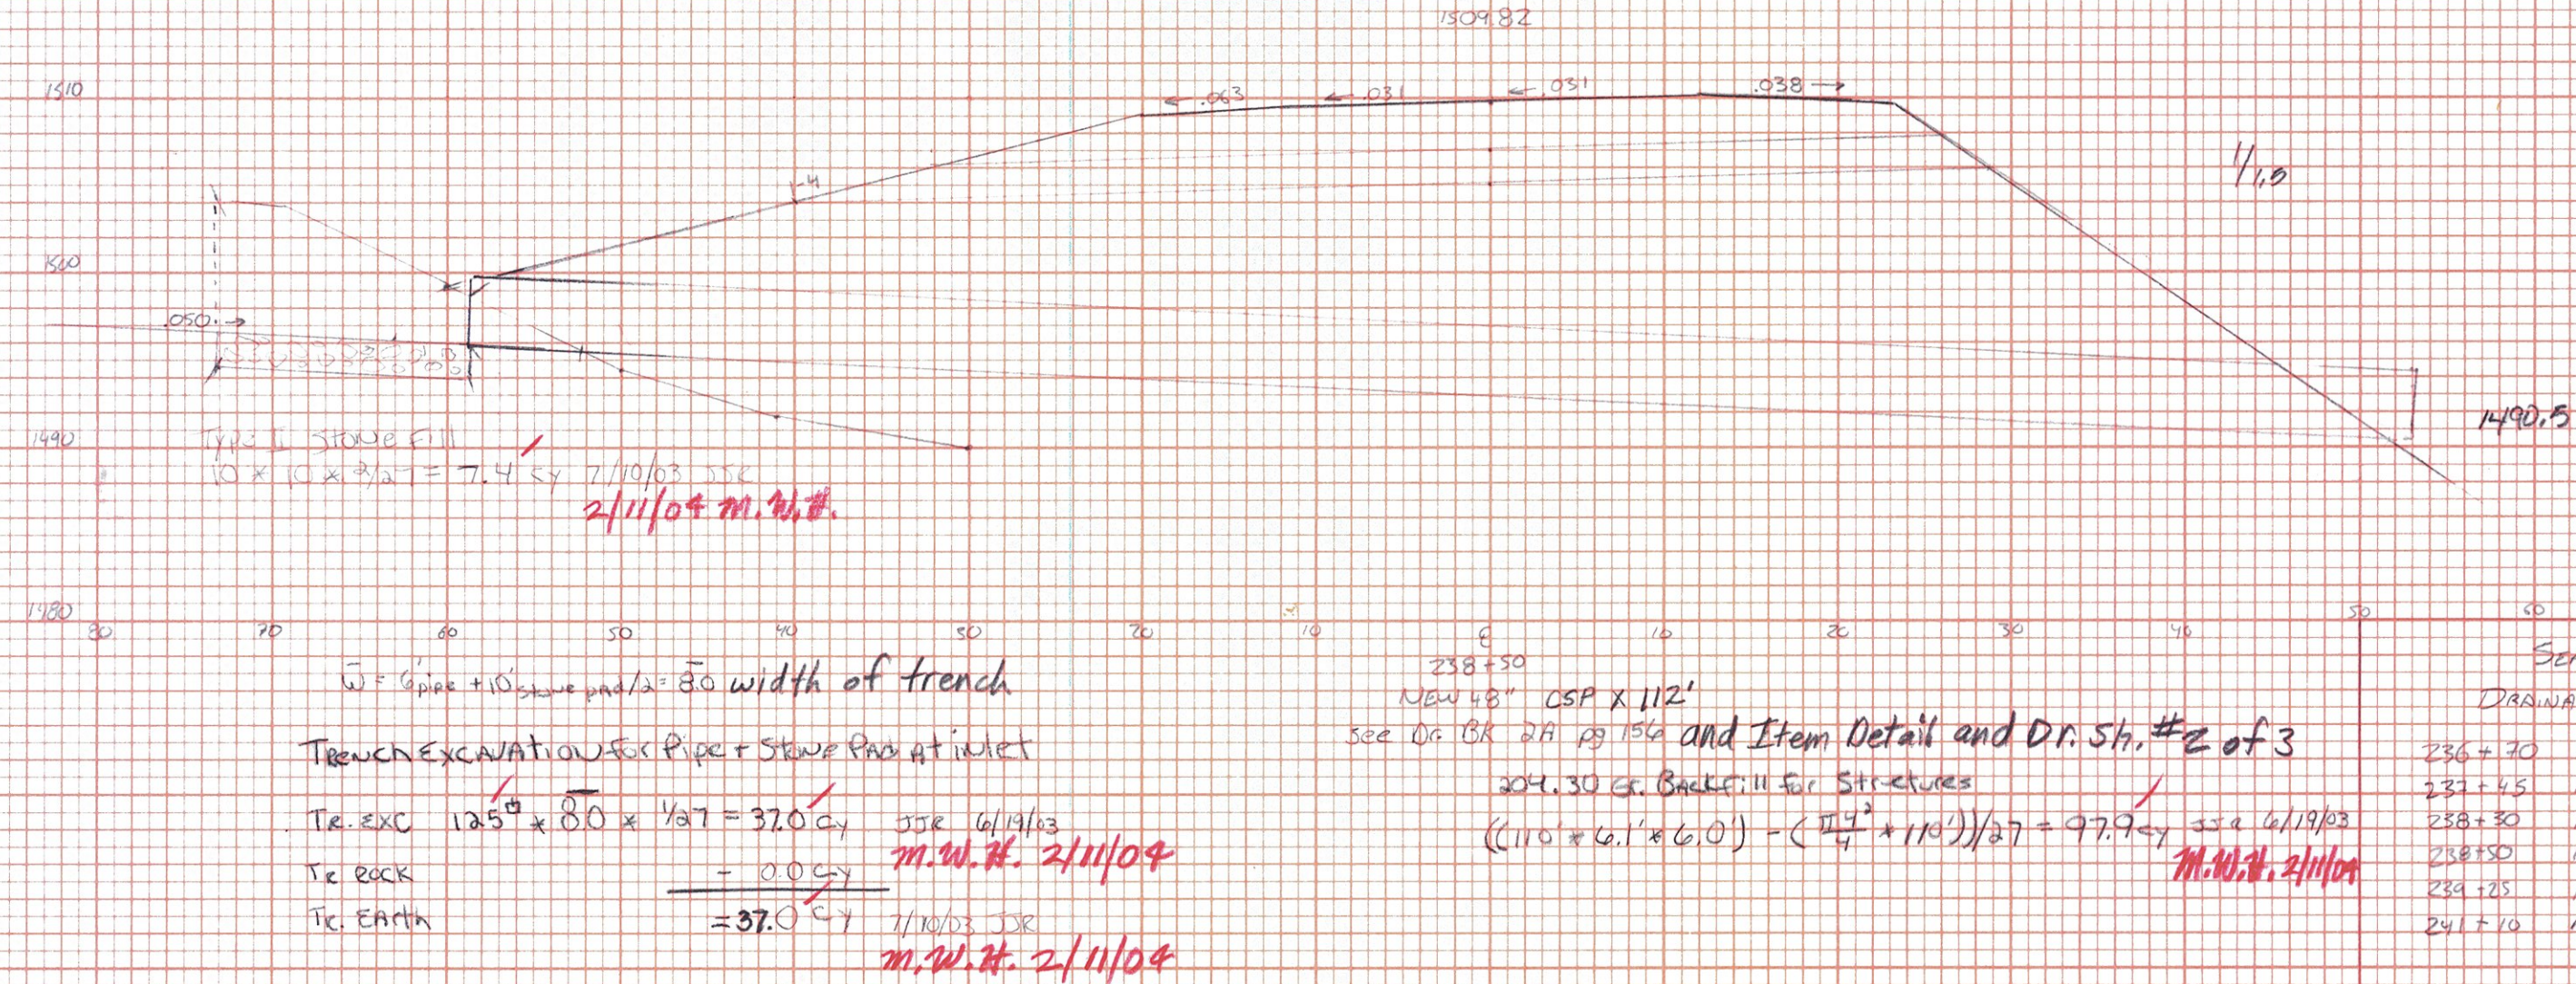

236+10
 Remove 15\"/>

W = 9' pipe + 10' slope and 1/2' = 30' width of trench
 TRENCH EXCAVATION FOR PIPE & SLOPE PAID AT INLET
 TR. EXC 125' x 80' x 1/2' = 320 CY
 TR. EARTH = 37.0 CY

238+50
 NEW 18\"/>

SEARSBURG - WILMINGTON
 DRAWING SHEET 16 OF 27
 236+20 Remove 15\"/>