
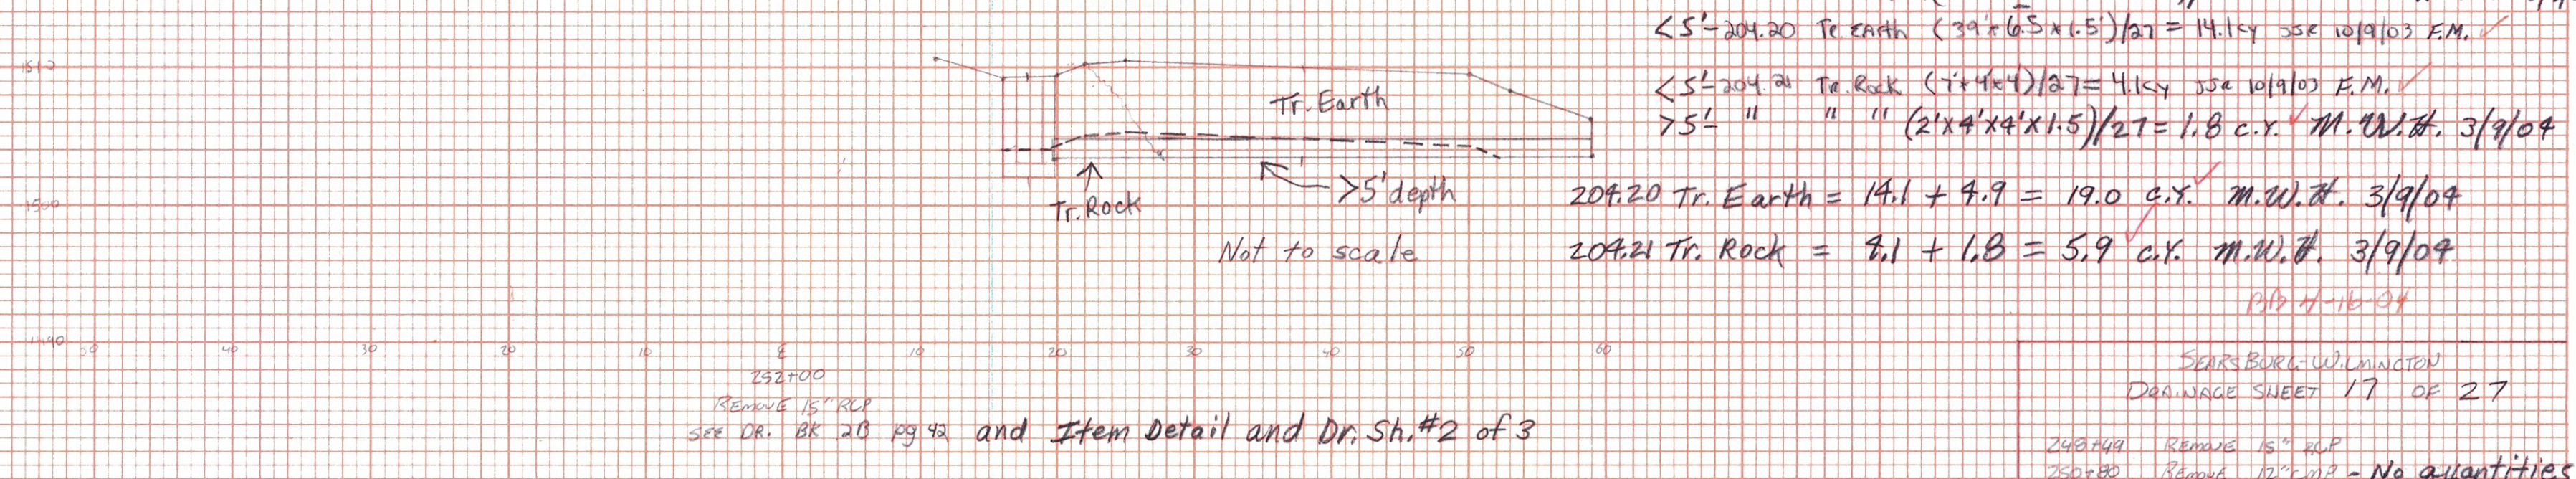
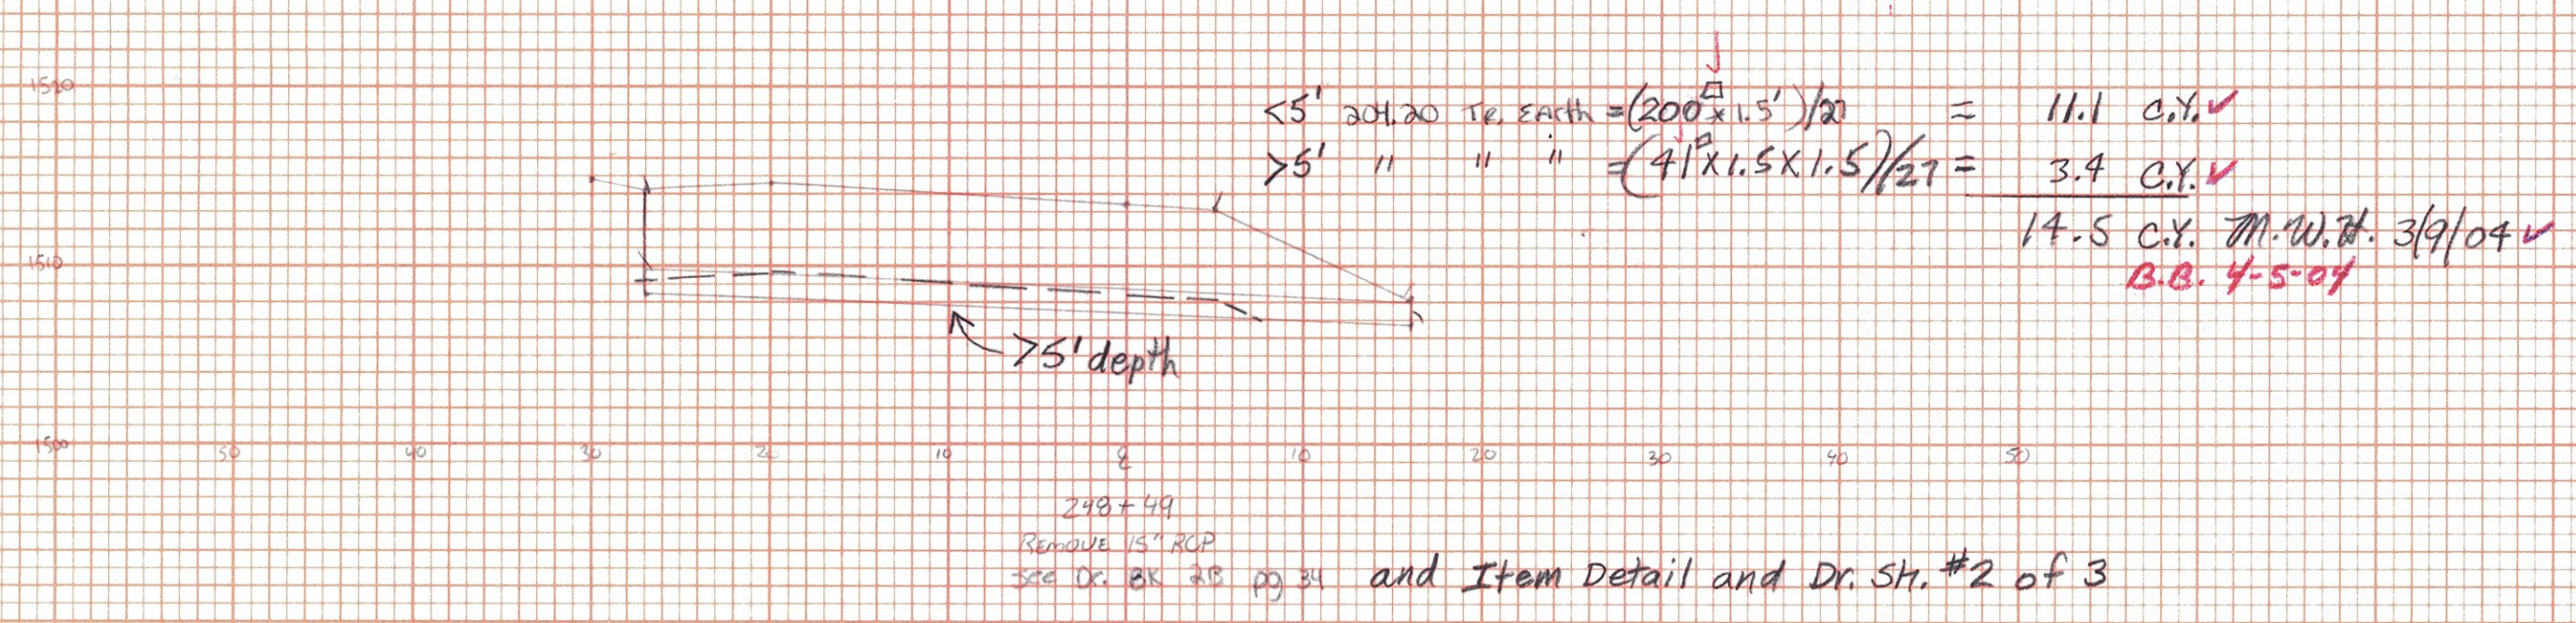
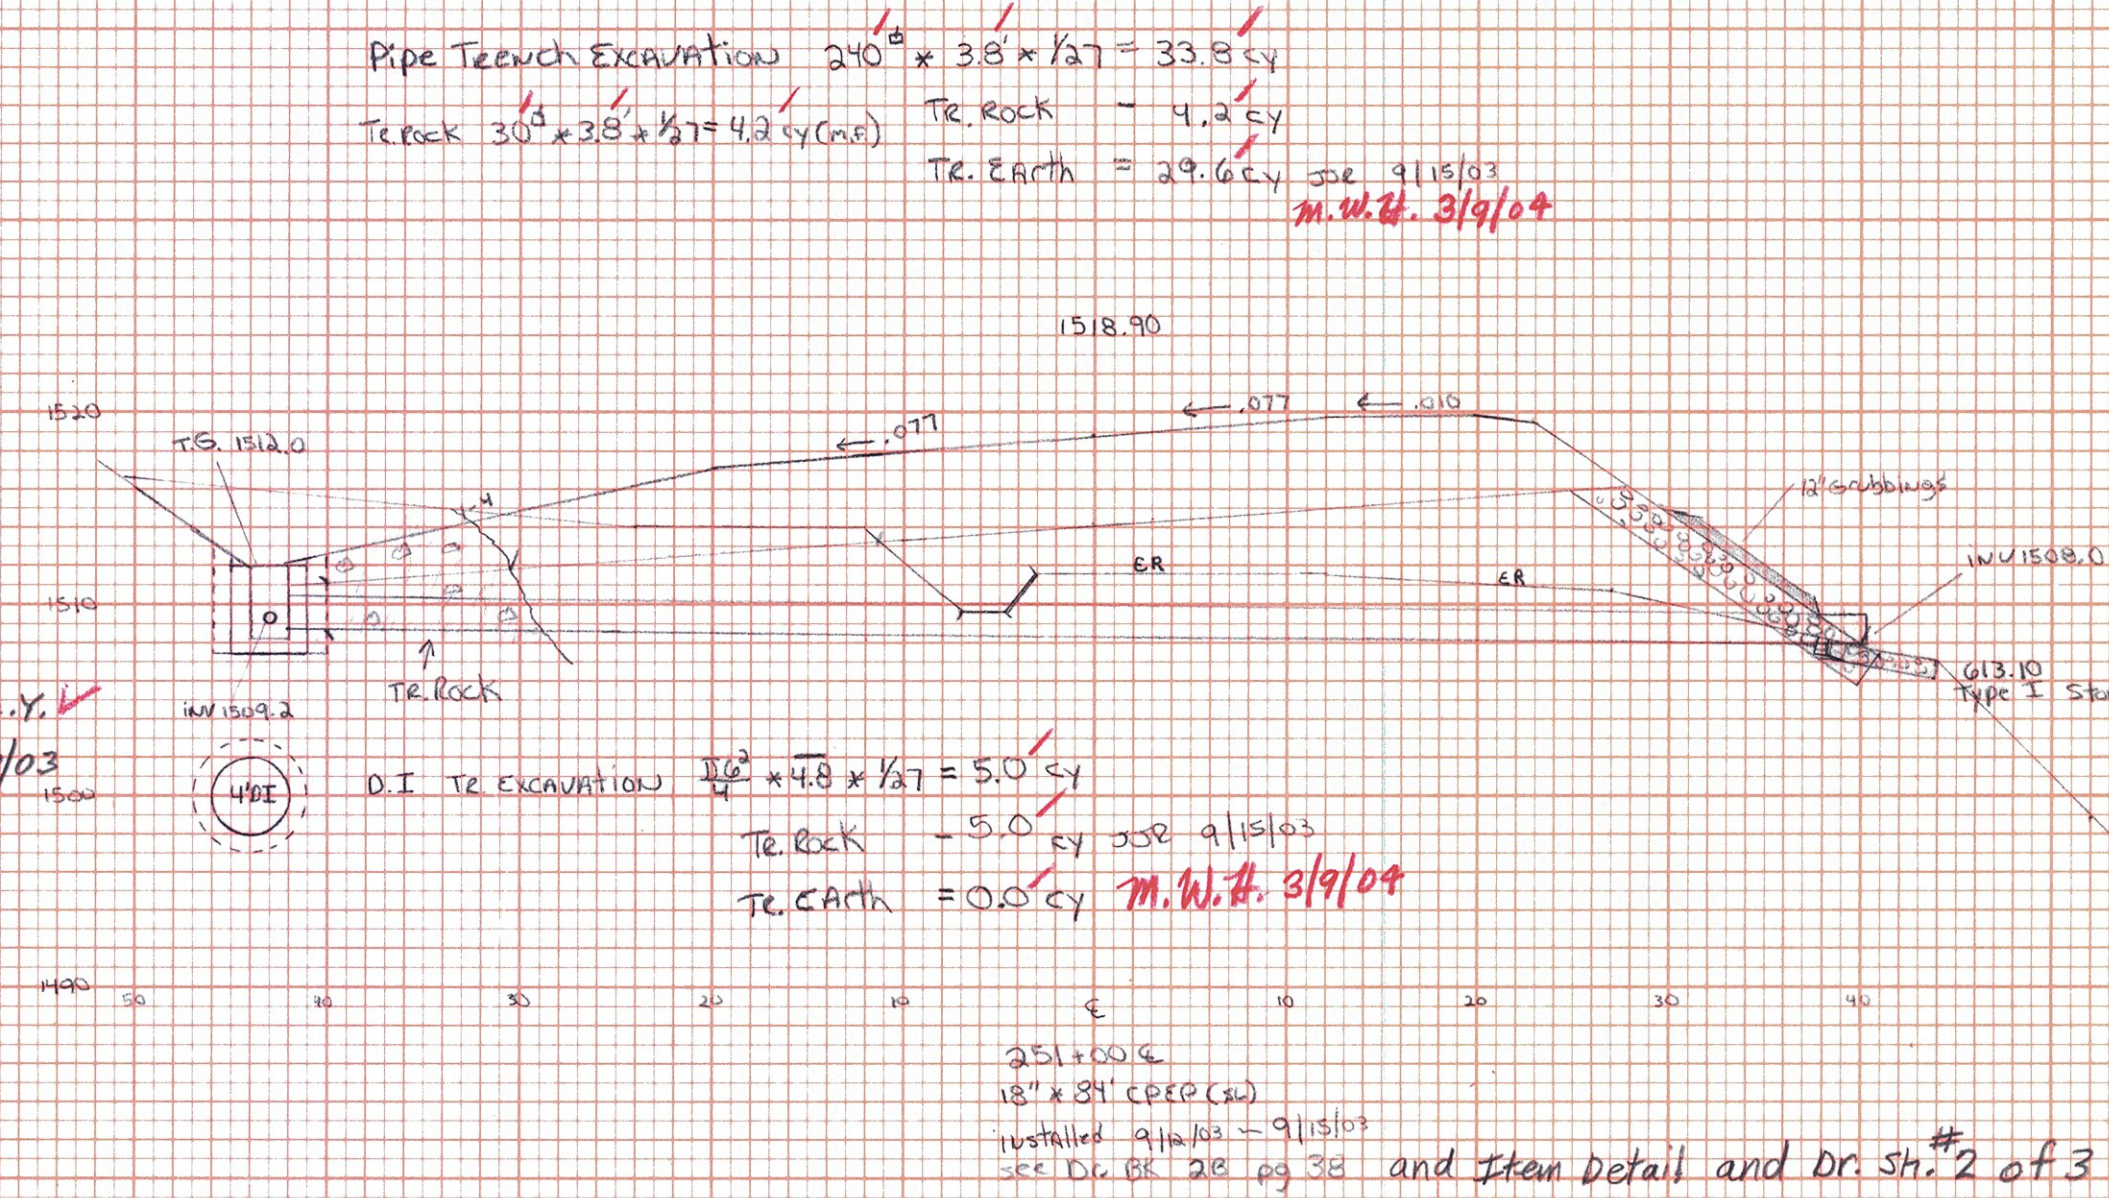
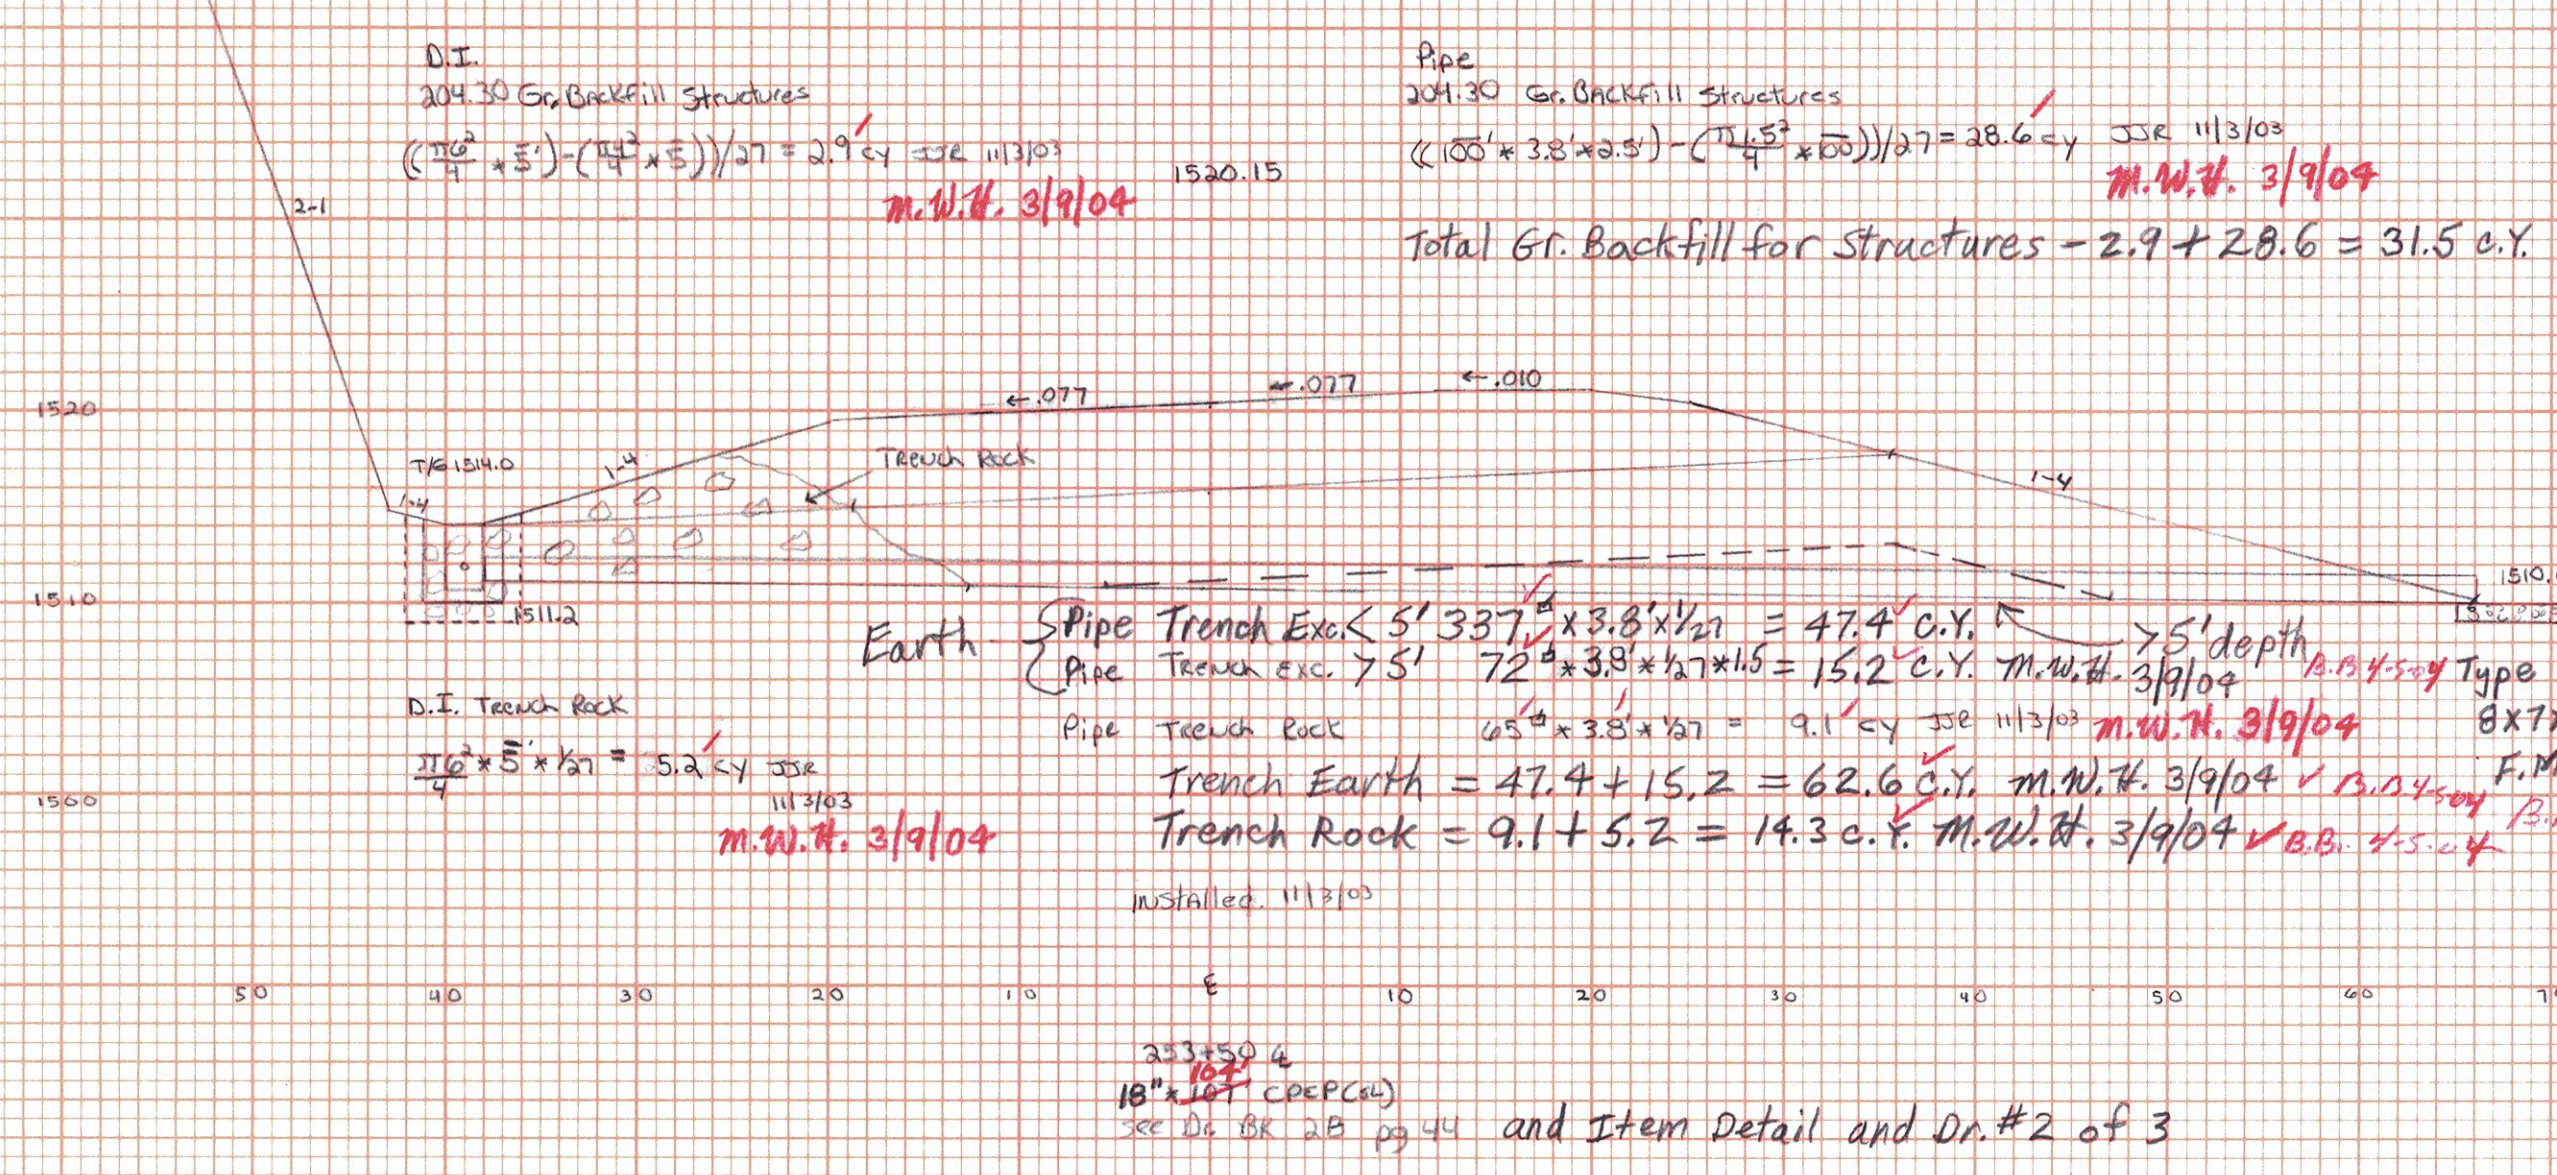


FINAL SURVEY BY DATE  
 SURVEYED BY DATE  
 TEMPLATE NO. DATE  
 NOTE BOOK NO. DATE  
 AREAS CHECKED

ORIGINAL SURVEY BY DATE  
 SURVEYED BY DATE  
 TEMPLATE NO. DATE  
 NOTE BOOK NO. DATE  
 AREAS CHECKED

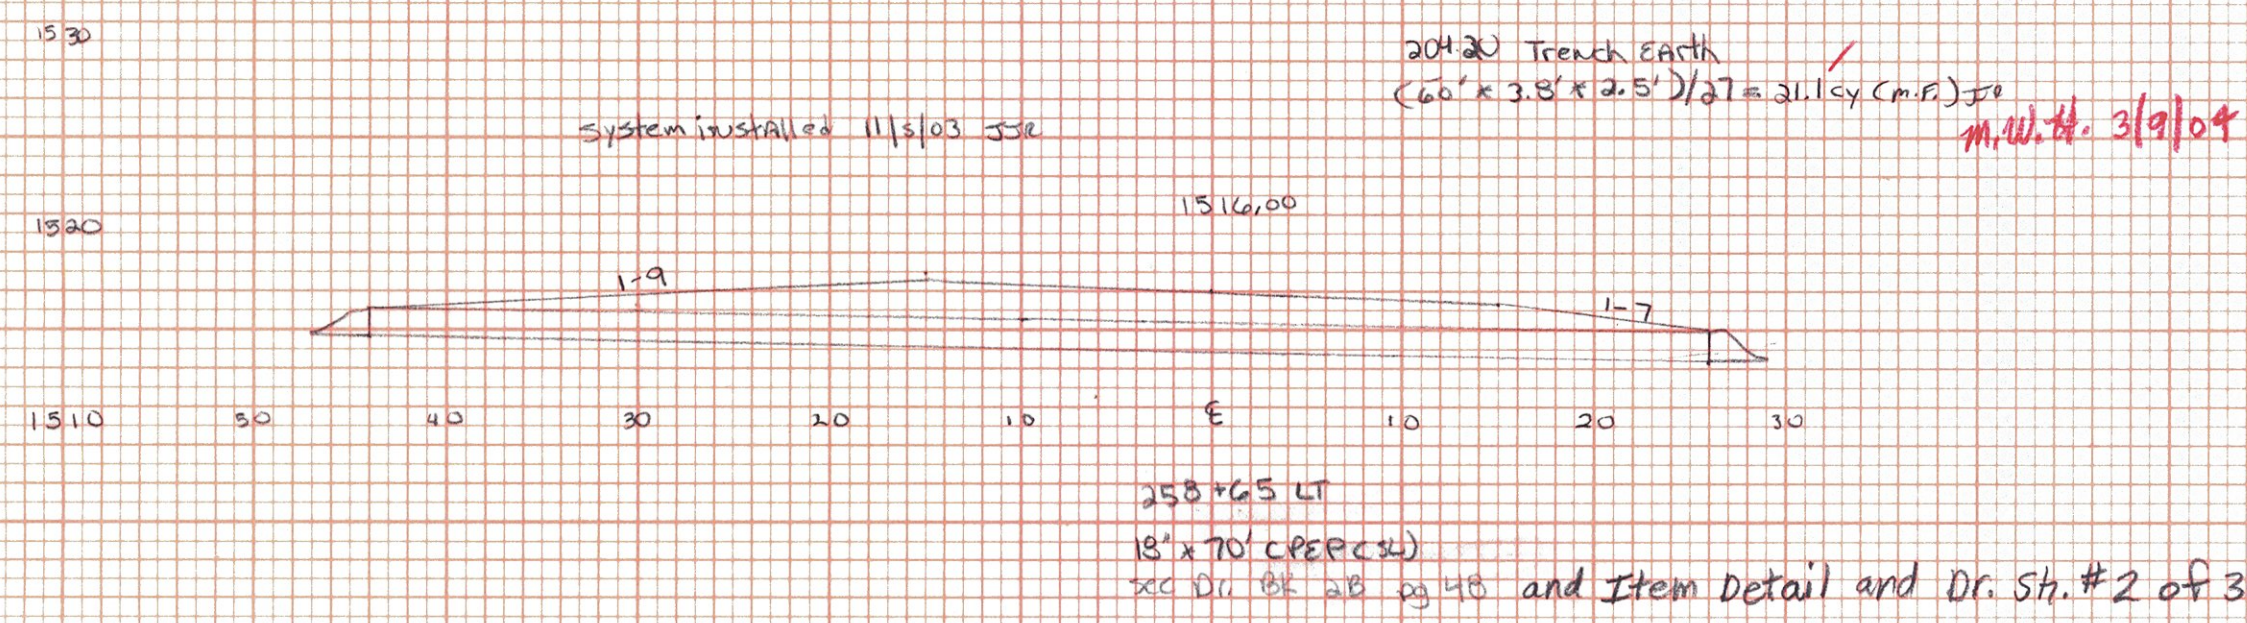

DEARSBURY WILMINGTON  
 DRAINAGE SHEET 17 OF 27

248 x 49	REMOVE 15" RCP
250 x 80	REMOVE 12" RCP - No quantities (Not shown)
251 x 70	REMOVE 12" RCP
251 x 60	REMOVE 15" RCP
251 x 50	REMOVE 18" CPEP
258 x 65	REMOVE 15" CPEP

SEARCHED BY: JSE 11/3/03  
 88-11010-1(11)