


FINAL SURVEY
 NOTE BOOK NO.
 BY
 DATE
 BUCKETED
 PLOTTED
 CHECKED
 AREAS

ORIGINAL SURVEY
 NOTE BOOK NO.
 BY
 DATE
 BUCKETED
 PLOTTED
 CHECKED
 AREAS


1520
 1510
 1500
 1520
 1510
 1500

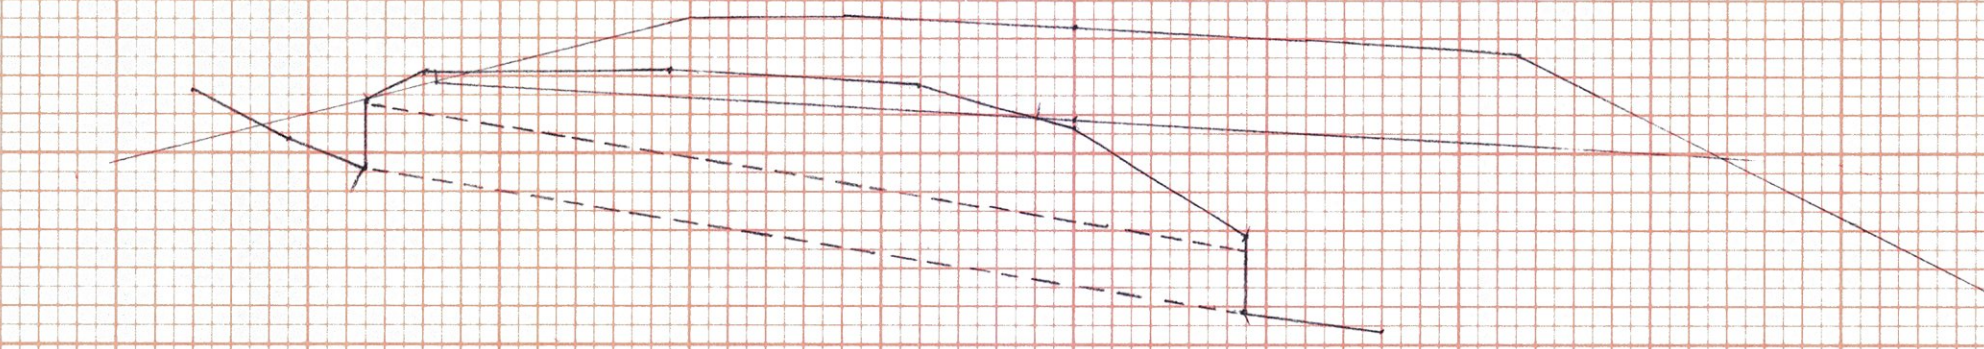

274+29
 Removal 24" Box
 see Dr. BK 2B pg 90
 see Item Detail and Dr. Sh. #2 of 3

Trench Excavation
 Trench Rock
 Trench Earth

295' x 2.0' x 1/2' = 22.8 Cy
 - 0.0 Cy
 = 22.8 Cy
 21.9 M.W. # 3/12/04
 P.C. 4-5-cy

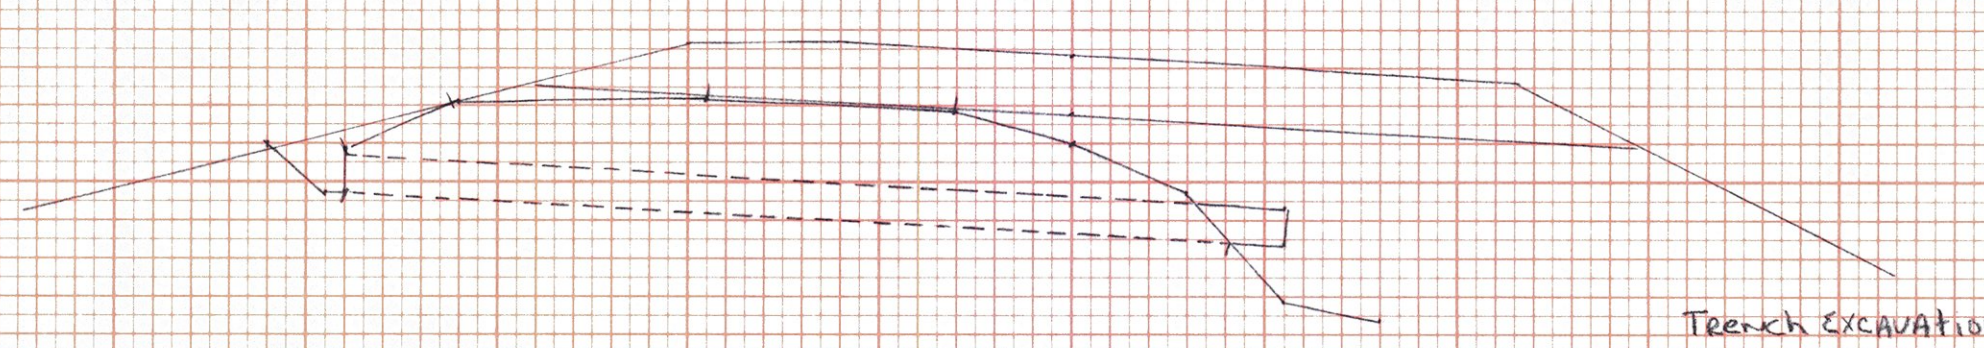

274+30
 Removal 24" ACCM.P
 see Dr. BK 2B pg 92 and Item Detail and Dr. Sh. #2 of 3

Trench Excavation
 Trench Rock
 Trench Earth

255' x 2.0' x 1/2' = 17.4 cy
 - 0.0 cy
 = 17.4 cy
 17.4 M.W. # 3/12/04

50 10 E 10 50

Searsburg - Wilmington
 Drainage sheet 20 of 27
 Removal 274+30
 Removal 274+29
 New/Remove 272+18 / 272-25
 see also Sh. #19