


FINAL SURVEY
 SURVEYED BY: _____
 DATE: _____
 NOTE BOOK NO. _____
 TEMPLATE NO. _____
 AREAS CHECKED: _____

ORIGINAL SURVEY
 SURVEYED BY: _____
 DATE: _____
 NOTE BOOK NO. _____
 TEMPLATE NO. _____
 AREAS CHECKED: _____

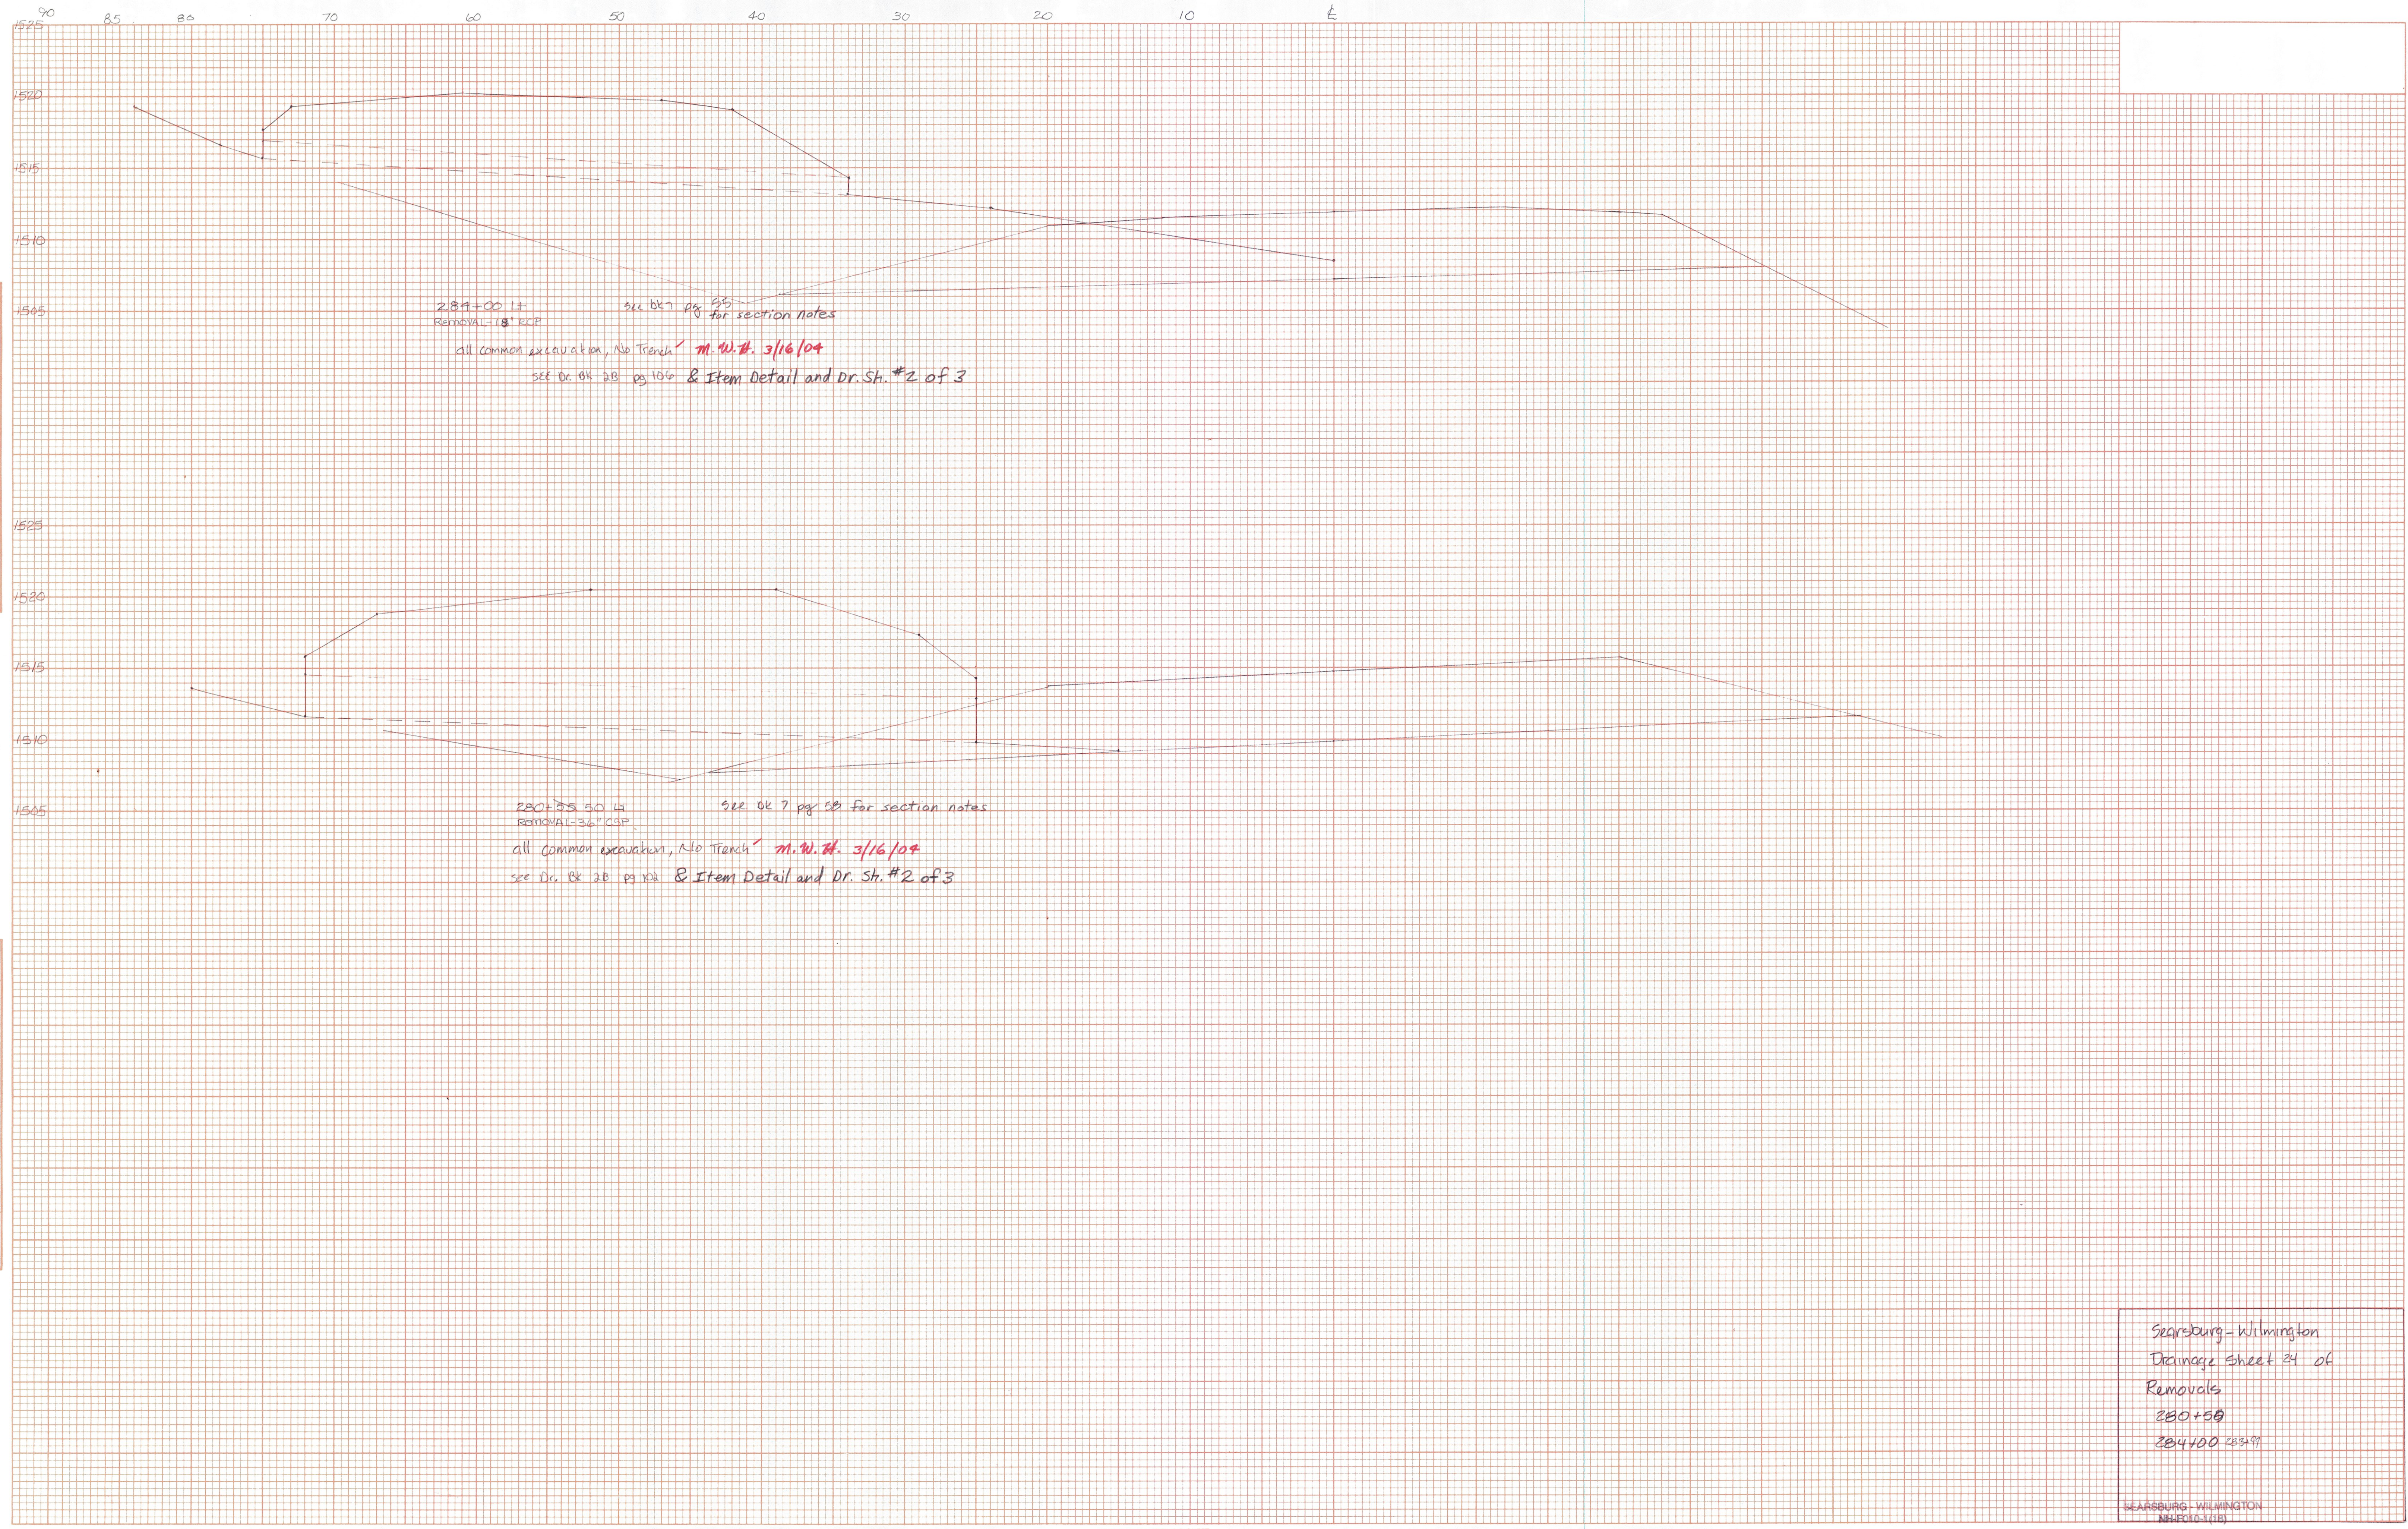

Searsburg - Wilmington
 Drainage Sheet 24 of
 Removals
 280+50
 284+00 283+99 ✓