


FINAL SURVEY SURVEYED, PLOTTED, NOTE BOOK NO. BY DATE AREAS CHECKED

ORIGINAL SURVEY SURVEYED, PLOTTED, NOTE BOOK NO. BY DATE AREAS CHECKED

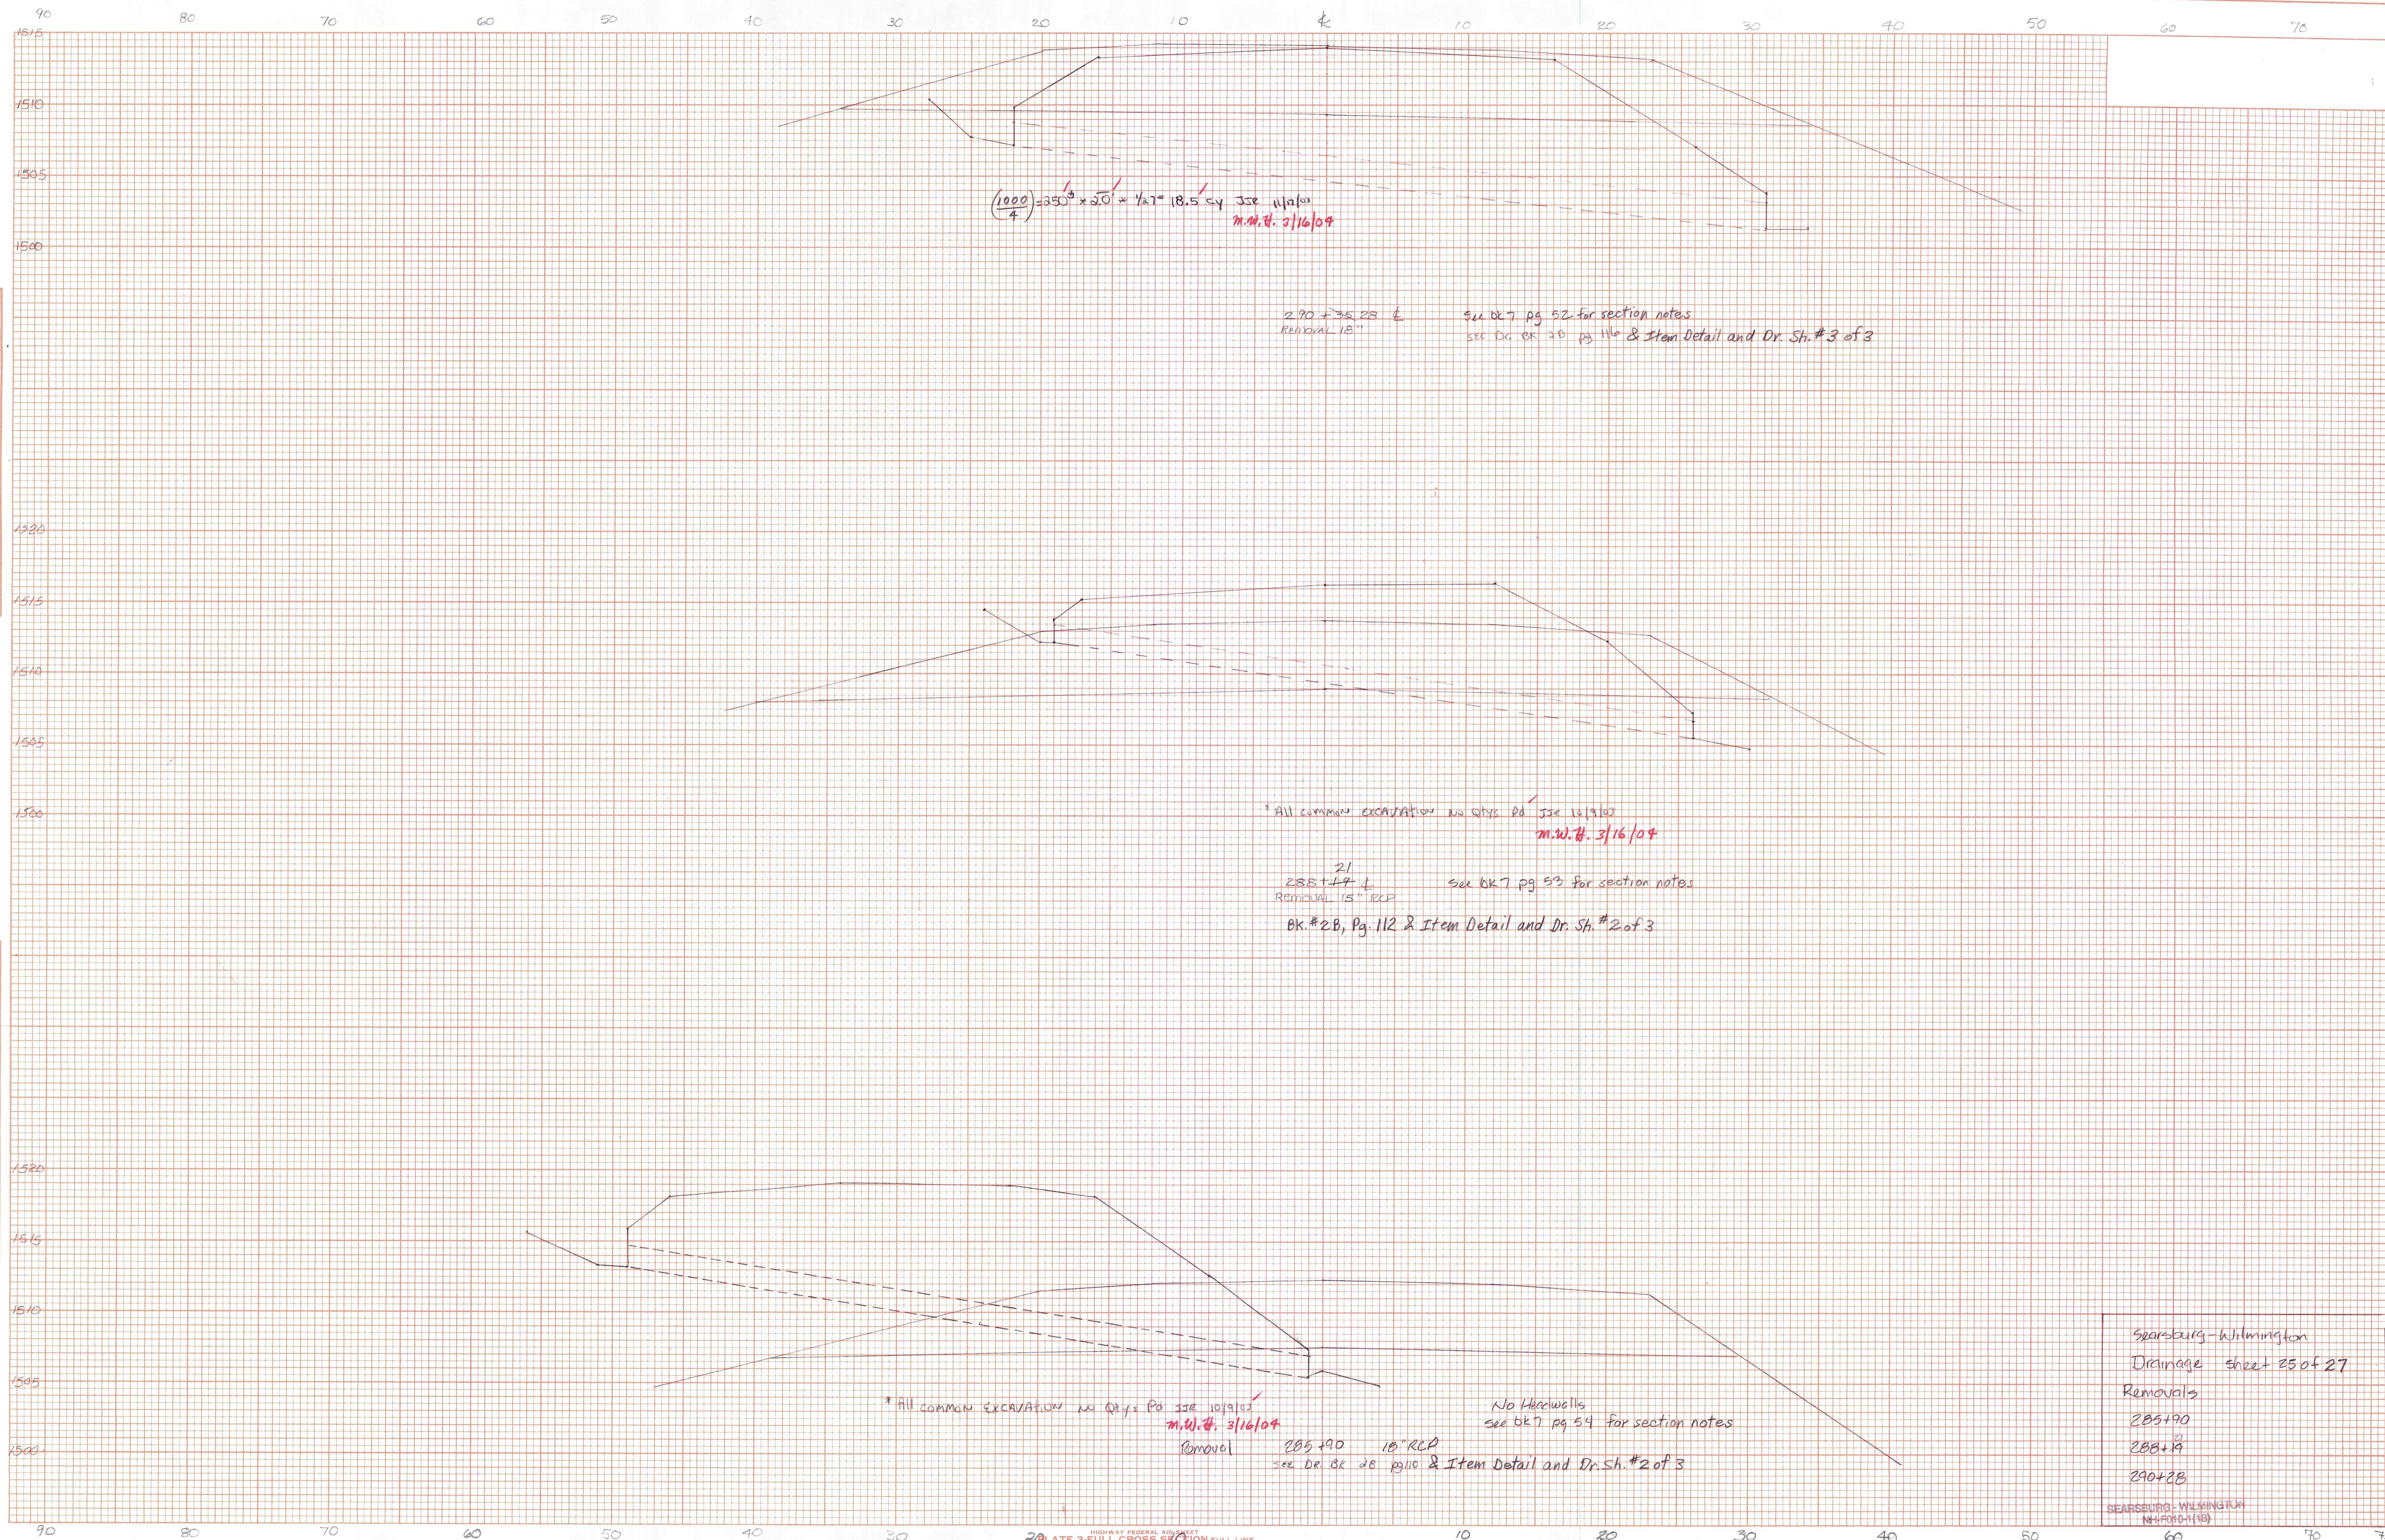

Searsburg-Wilmington
 Drainage sheet 25 of 27
 Removals
 285+90
 288+19
 290+28
 SEARSBURG-WILMINGTON
 (N410104-10)