


FINAL SURVEY BY DATE
 SURVEYED BY
 TEMPLATE NO.
 NOTE BOOK NO.
 AREAS CHECKED

ORIGINAL SURVEY BY DATE
 SURVEYED BY
 TEMPLATE NO.
 NOTE BOOK NO.
 AREAS CHECKED

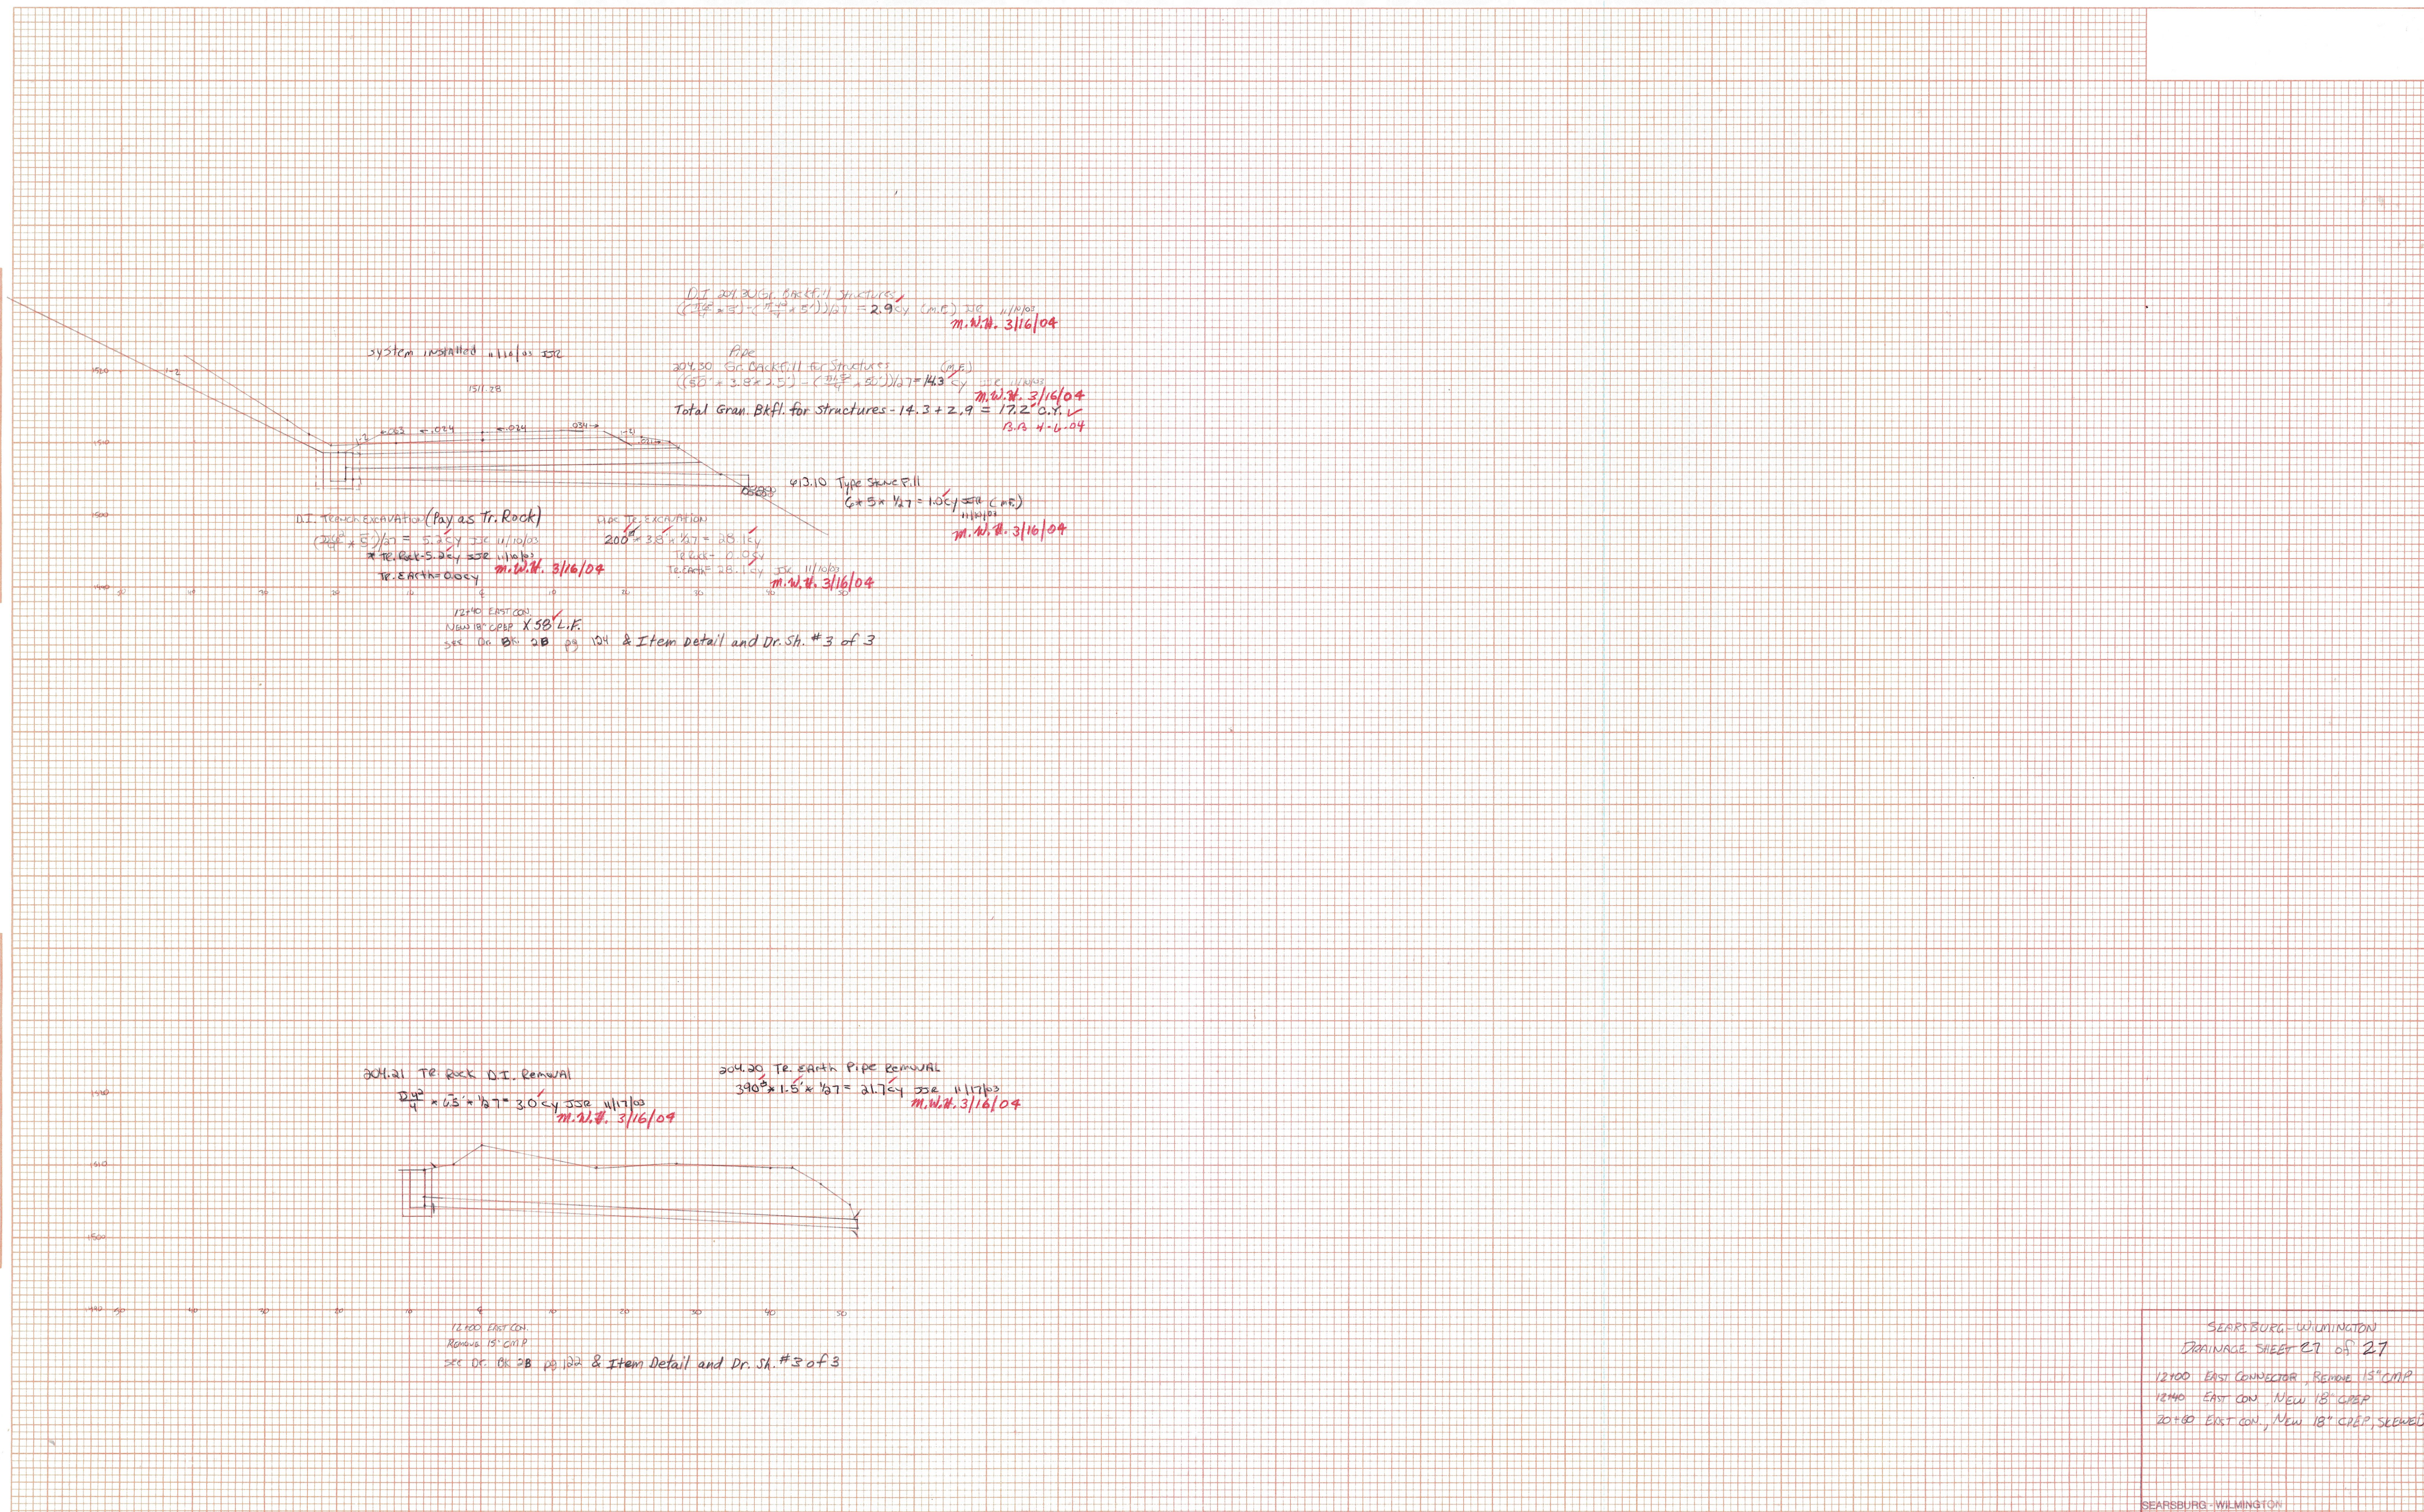

SEARSBURG-WILMINGTON
 DRAINAGE SHEET 27 OF 27
 12+00 EAST CONNECTOR, REMOVE 15" CRP
 12+40 EAST CON, NEW 18" CRP
 20+00 EAST CON, NEW 18" CRP, SLOPED ✓