


VIEWING TRAFFICE FACE OF EAST RAIL
VT. ROUTE 9 OVER DEERFIELD RIVER
BRIDGE No. 25

GRARD ENGINEERING DEPT.
ISSUED
JAN 15 2003
TRINITY INDUSTRIES, INC.
1170 N. STATE STREET
GRARD, OHIO 44420

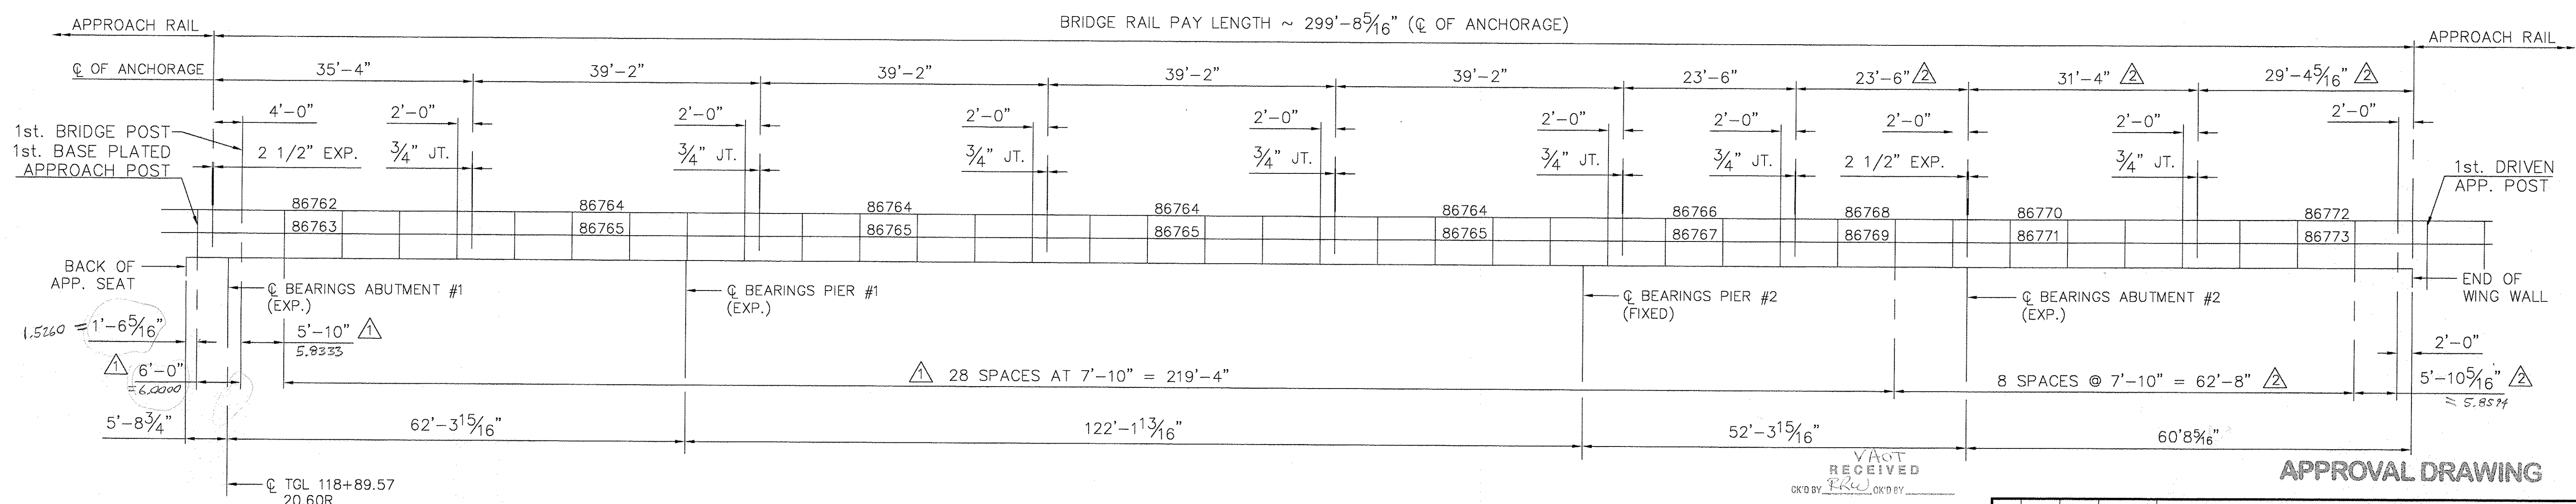

VIEWING NON-TRAFFICE FACE OF WEST RAIL
VT. ROUTE 9 OVER DEERFIELD RIVER
BRIDGE No. 25

VAOT RECEIVED
JAN 29 2003
RESUBMIT APPROVED
BY RRW DATE 1-30-03

APPROVAL DRAWING

- NOTES:
- ALL POSTS ARE P.C. 32878. (U.N.)
 - RAIL SPLICES:
FOR T.S. 8" x 4" ~ STD. P.C. 35107
FOR T.S. 4" x 4" ~ STD. P.C. 35103
 - FINISH: GALV. A123
HWD.: GALV. A153
 - PAY LENGTH THIS SHEET:
ITEM 525.33 ~ 574'-11 11/16"

NOTE:
1. DIMENSIONS SHOWN ARE
AT C OF RAIL ANCHORAGE.

REV.	CHK'D	BY	DATE	REMARKS
2			SAR 1/02/03	REVISED PER FIELD CHANGE
1			SAR 11/12/02	REVISED POST SPACING & PIER #2 TO FIXED JOINT

PAY ITEM NUMBER 525.33 BR. RAIL 2 BAR NETC

STATE OF VERMONT AGENCY OF TRANSPORTATION VT. ROUTE 9 - TOWNS OF SEARSBURGH & WILMINGTON COUNTIES OF BENNINGTON & WINDHAM STATE PROJECT NO. NHF 010-1(18) BRIDGE No. 25	DRAWN SAR CHECKED S.H. SCALE: N.T.S. DATE 7/9/02
CUSTOMER NORTHLAND SPECIALITES P.O. No. VERBAL	ENG. FILE # 22-1006277-E2
TRINITY INDUSTRIES, INC. HIGHWAY SAFETY PRODUCTS 2525 STEMMONS FREEWAY, DALLAS, TX 75207	SHT.No. E2 OF 4 TRINITY SALES ORDER NO. (22) 1006227 REV. 2

This drawing and the information shown thereon is the sole property of TRINITY INDUSTRIES, INC. Neither the drawing nor such information is to be used for any purpose other than that for which it was specifically furnished by TRINITY INDUSTRIES, INC., nor is any reproduction authorized without written permission.

F:\R\Share\Engineering\WIP\VT 1006227\22-1006227-E2.dwg 1/14/03 16:39:24