



F:\R\Share\Engineering\WIP\VT1006227\22-1006227-E3.dwg 1/14/03 16:39:20

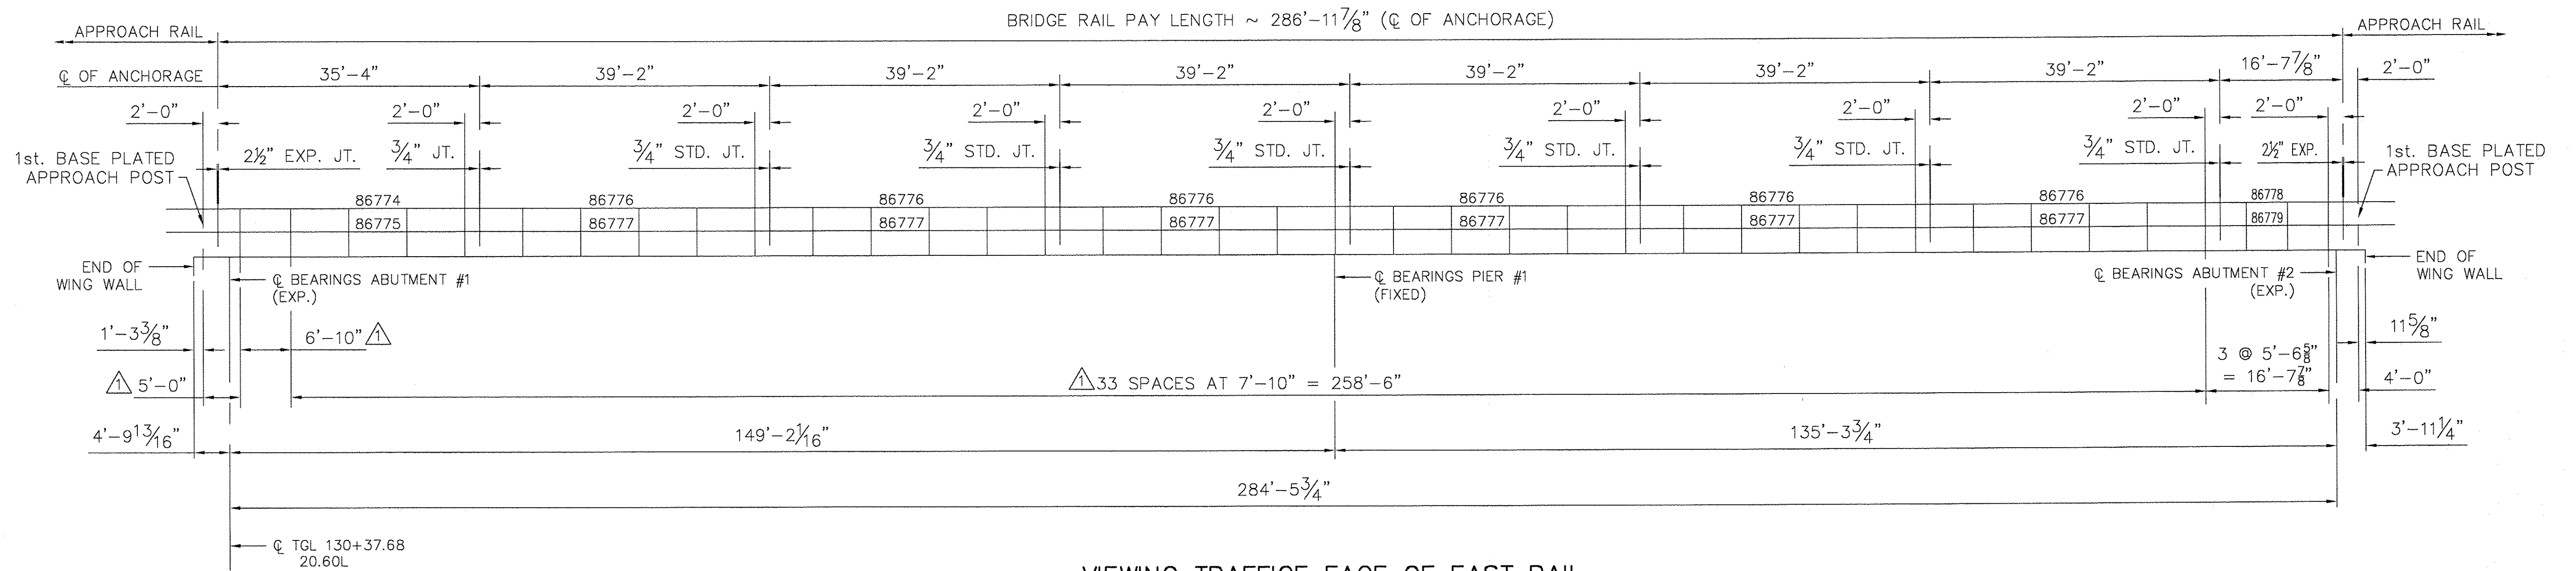

VIEWING TRAFFIC FACE OF EAST RAIL
VT. ROUTE 9 OVER DEERFIELD RIVER
BRIDGE No. 25A

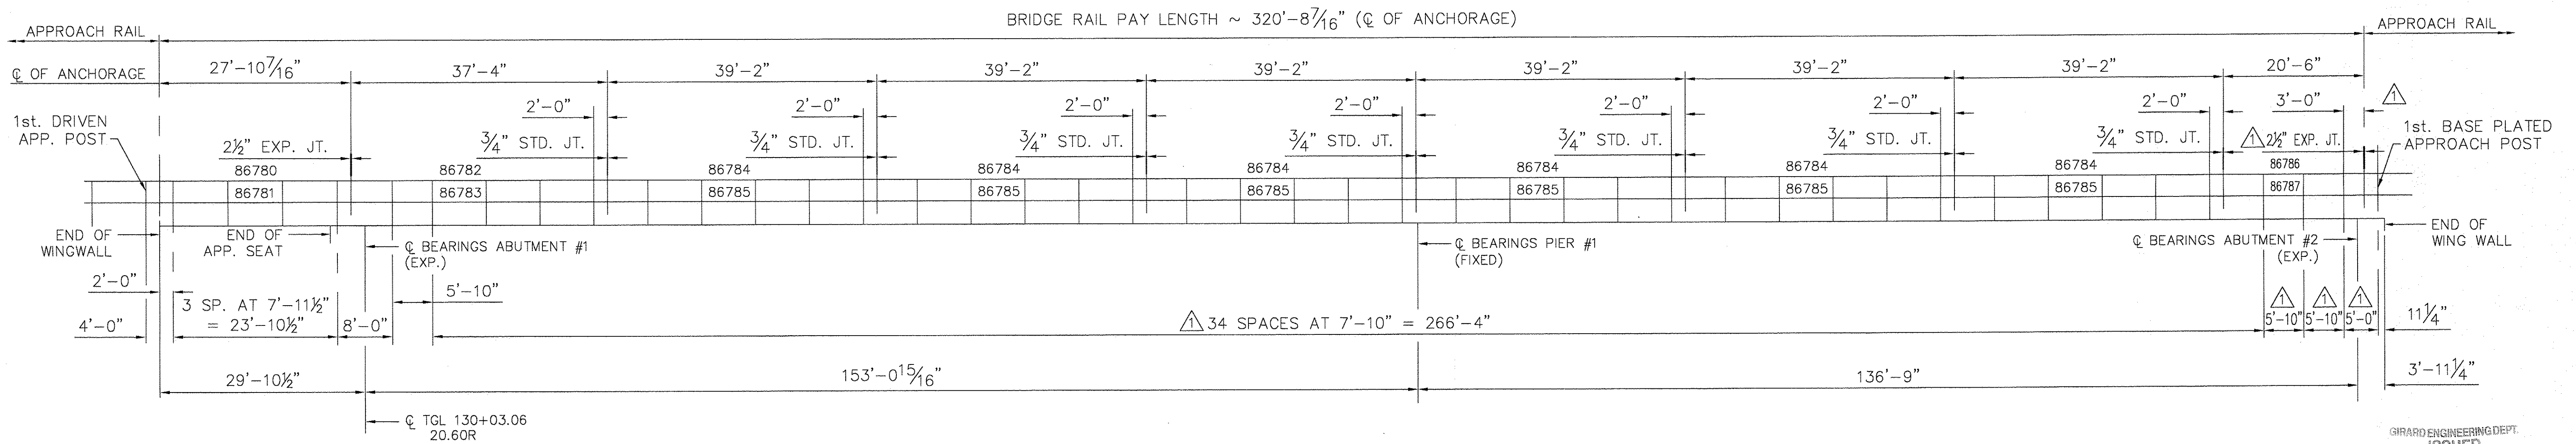

VIEWING NON-TRAFFIC FACE OF WEST RAIL
VT. ROUTE 9 OVER DEERFIELD RIVER
BRIDGE No. 25A

NOTES:

1. ALL POSTS ARE P.C. 32878. (U.N.)
2. RAIL SPLICES:
FOR T.S. 8" x 4" ~ STD. P.C. 35107
FOR T.S. 4" x 4" ~ STD. P.C. 35103
3. FINISH: GALV. A123
HWD.: GALV. A153
4. PAY LENGTH THIS SHEET:
ITEM 525.33 ~ 607'-8 5/16"

VAOT
RECEIVED
JAN 29 2003
RESUBMIT APPROVED
BY RRU DATE 1-30-03

GIKARD ENGINEERING DEPT.
ISSUED
JAN 15 2003
TRINITY INDUSTRIES, INC.
170 N. STATE STREET
GIRARD, OHIO 44420

APPROVAL DRAWING

REV.	CHK'D	BY	DATE	REMARKS
△	SAR		11/12/02	REVISED POST SPACING
PAY ITEM NUMBER 525.33 BR. RAIL 2 BAR NETC				
STATE OF VERMONT AGENCY OF TRANSPORTATION VT. ROUTE 9 - TOWNS OF SEARSBURGH & WILMINGTON COUNTIES OF BENNINGTON & WINDHAM STATE PROJECT NO. NHF 010-1(18) BRIDGE No. 25A				DRAWN SAR
CUSTOMER NORTHLAND SPECIALITIES				CHECKED S.H.
P.O. No. VERBAL				SCALE: N.T.S.
DATE 7/9/02				ENG. FILE # 22-1006277-E3
TRINITY INDUSTRIES, INC. HIGHWAY SAFETY PRODUCTS 2525 STEMMONS FREEWAY, DALLAS, TX 75207				SHT.No. E3 OF 4
TRINITY SALES ORDER NO. (22) 1006227				REV. 1

NOTE:
1. DIMENSIONS SHOWN ARE
AT C OF RAIL ANCHORAGE.

This drawing and the information shown thereon is the sole property of TRINITY INDUSTRIES, INC. Neither the drawing nor such information is to be used for any purpose other than that for which it was specifically furnished by TRINITY INDUSTRIES, INC., nor is any reproduction authorized without written permission.