



F:\RFShare\Engineering\WIP\VT1006227\22-1006227-E4.dwg 1/14/03 16:39:17

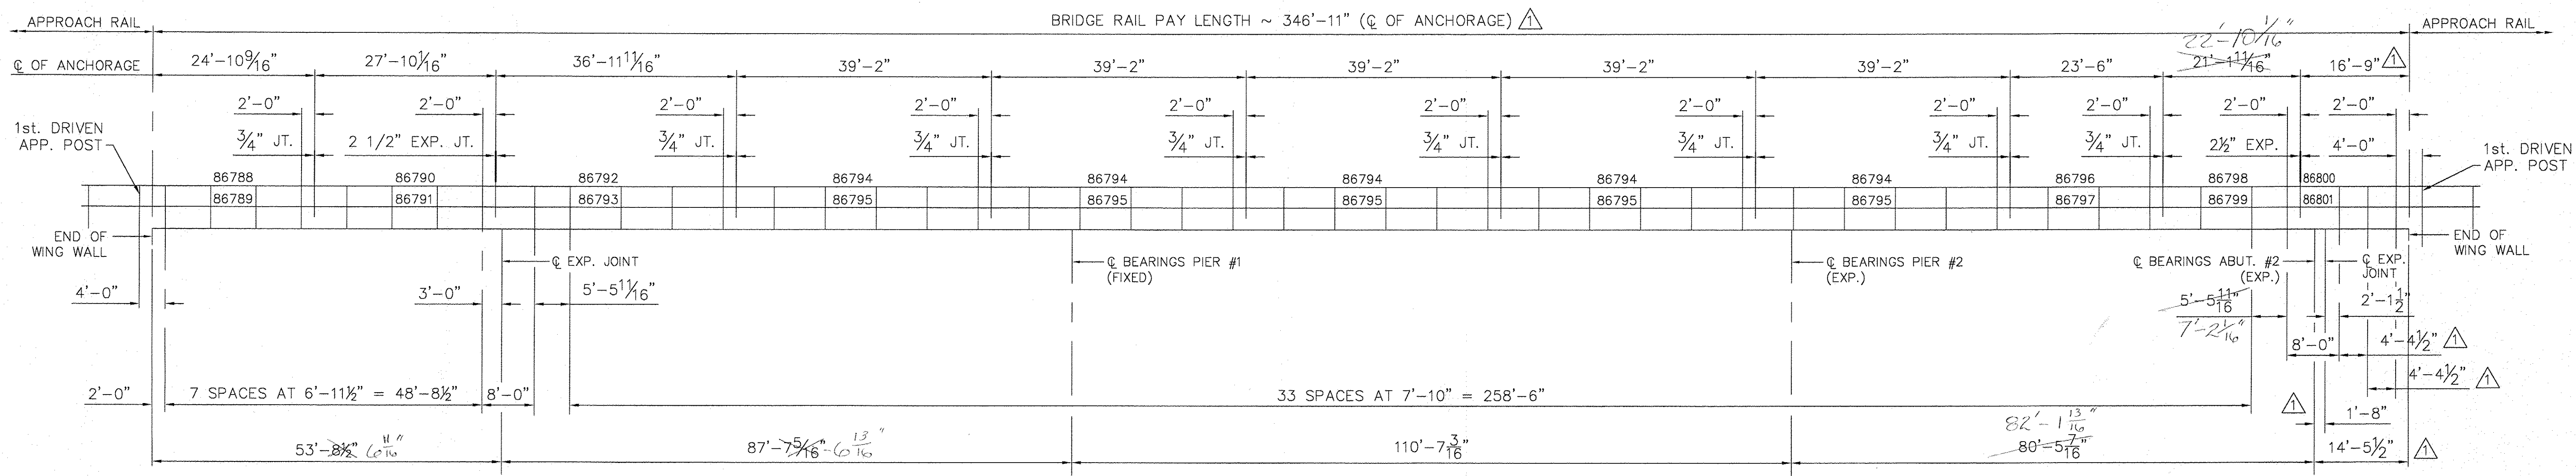

VIEWING TRAFFICE FACE OF EAST RAIL  
VT. ROUTE 9 OVER DEERFIELD RIVER  
BRIDGE No. 25B

GIRARD ENGINEERING DEPT.  
ISSUED  
JAN 15 2003  
TRINITY INDUSTRIES, INC.  
170 N. STATE STREET  
GIRARD, OHIO 44420

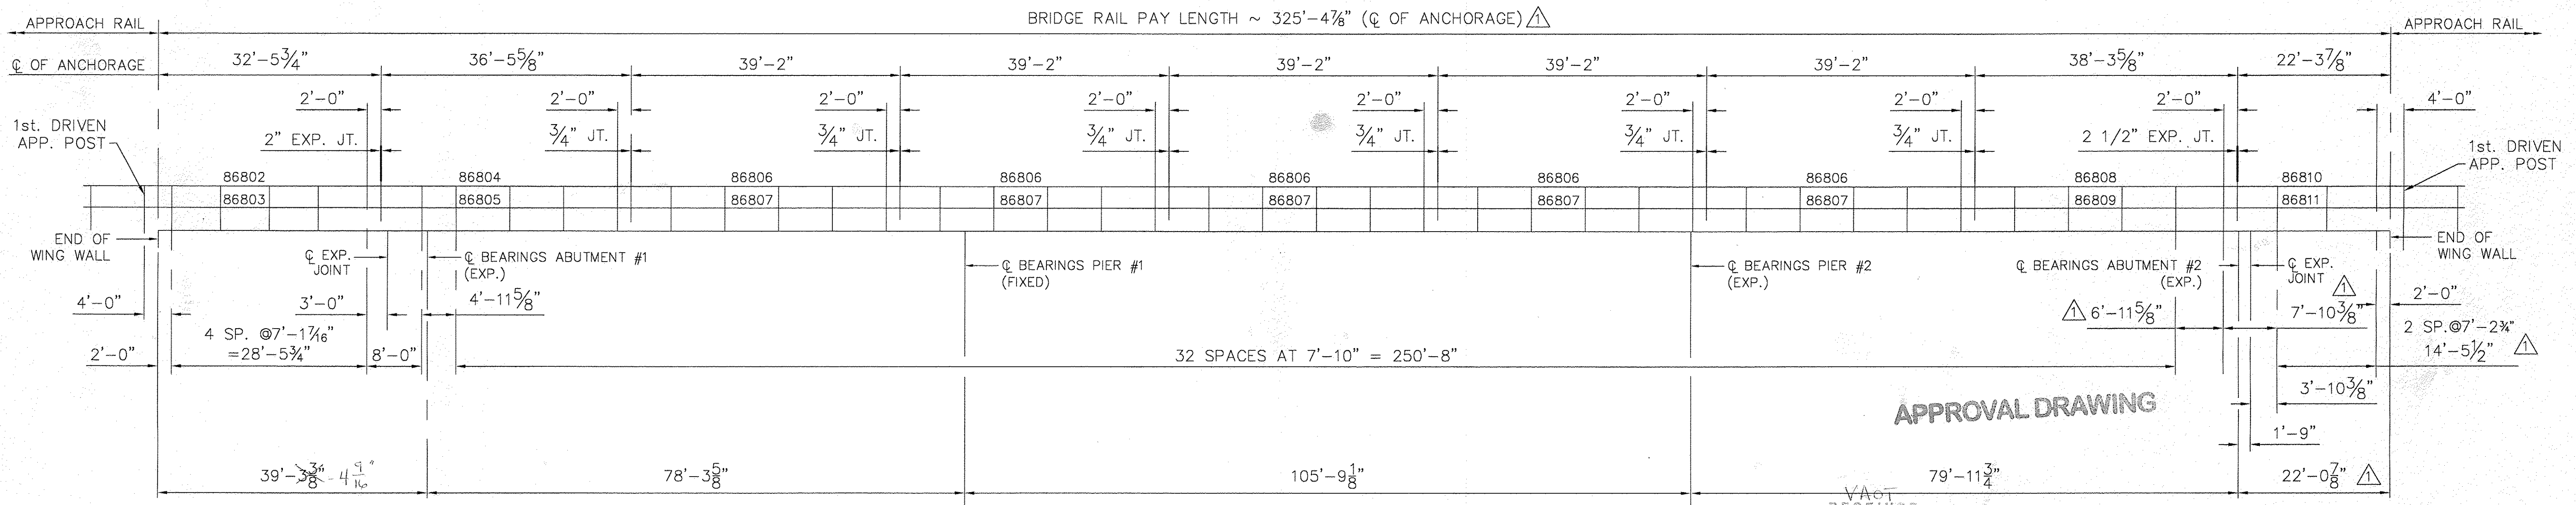

VIEWING NON-TRAFFICE FACE OF WEST RAIL  
VT. ROUTE 9 OVER DEERFIELD RIVER  
BRIDGE No. 25B

- NOTES:
- ALL POSTS ARE P.C. 32878. (U.N.)
  - RAIL SPLICES:  
FOR T.S. 8" x 4" ~ STD. P.C. 35107  
FOR T.S. 4" x 4" ~ STD. P.C. 35103
  - FINISH: GALV. A123  
HWD.: GALV. A153
  - PAY LENGTH THIS SHEET:  
ITEM 525.33 ~ 672'-3 7/8"

NOTE:  
1. DIMENSIONS SHOWN ARE  
AT  $\phi$  OF RAIL ANCHORAGE.

VAOT  
RECEIVED  
RESUBMITTED AS NOTED  
BY KRW DATE 1-30-03

APPROVAL DRAWING

REV.	CHK'D	BY	DATE	REMARKS
1	SAR		11/12/02	REVISED POST SPACING

**PAY ITEM NUMBER 525.33 BR. RAIL 2 BAR NETC**

STATE OF VERMONT AGENCY OF TRANSPORTATION VT. ROUTE 9 - TOWNS OF SEARSBURGH & WILMINGTON COUNTIES OF BENNINGTON & WINDHAM STATE PROJECT NO. NHF 010-(1)(18) BRIDGE No. 25B	DRAWN SAR CHECKED S.H. SCALE: N.T.S. DATE 7/9/02
CUSTOMER NORTHLAND SPECIALITES P.O. No. VERBAL	ENG. FILE # 22-1006277-E4
<b>TRINITY INDUSTRIES, INC.</b> HIGHWAY SAFETY PRODUCTS 2525 STEMMONS FREEWAY, DALLAS, TX 75207	
SHT.No. E4 OF 4 TRINITY SALES ORDER NO. (22) 1006227	REV. 1

This drawing and the information shown thereon is the sole property of TRINITY INDUSTRIES, INC. Neither the drawing nor such information is to be used for any purpose other than that for which it was specifically furnished by TRINITY INDUSTRIES, INC., nor is any reproduction authorized without written permission.