

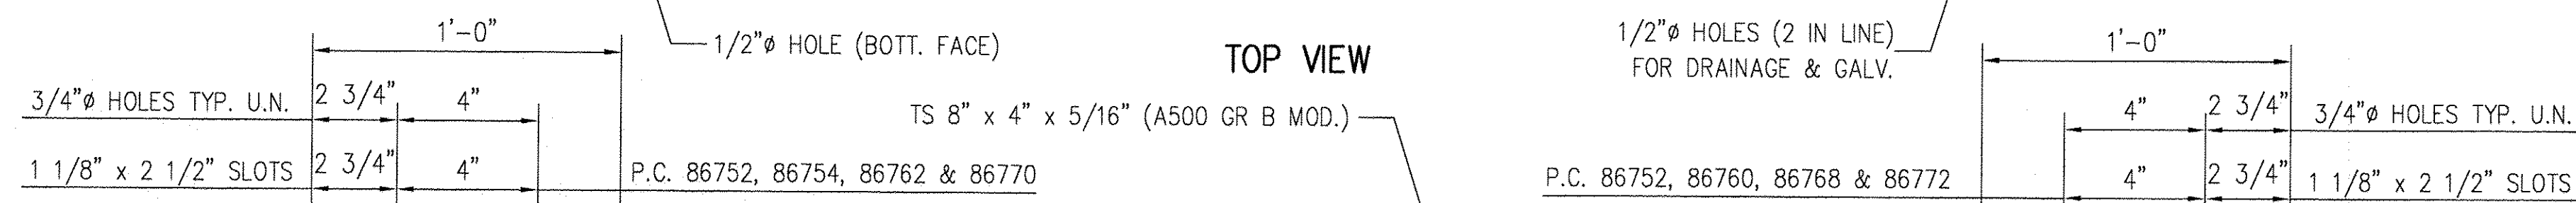
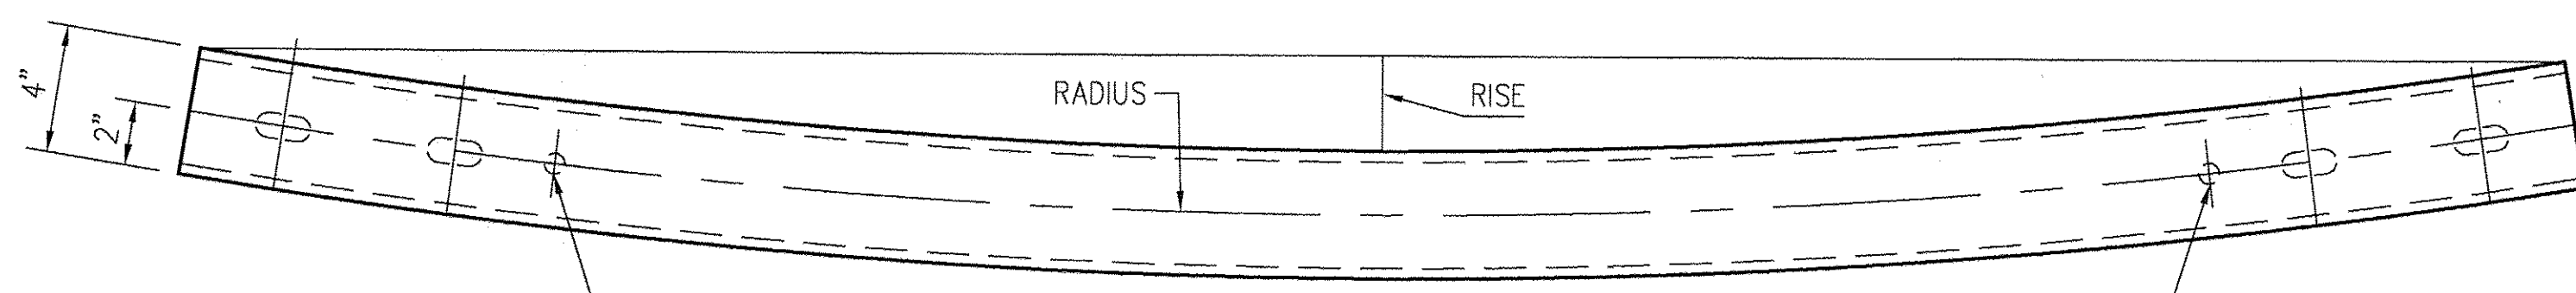


F:\R\Share\Engineering\WIP\VT1006227\22-1006227-D2.dwg 1/14/03 16:39:10

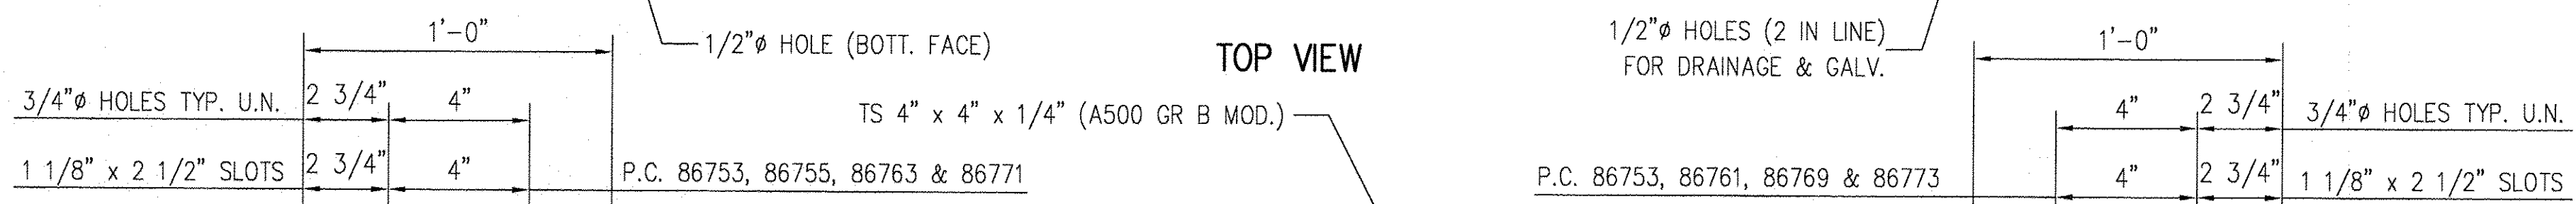

RAD.	PC	Length (ALONG CENTER LINE)	RISE
1253'-0 7/8"	PC-86752	25'-4 3/16"	3/4" Δ
1253'-0 7/8"	PC-86754	39'-2 1/2"	1 13/16"
1253'-0 7/8"	PC-86756	39'-1 3/8"	1 13/16"
1253'-0 7/8"	PC-86758	23'-5 3/8"	11/16"
1253'-0 7/8"	PC-86760	30'-1 5/16"	1 1/16"
1293'-4 7/8"	PC-86762	35'-2 1/4"	1 7/16"
1293'-4 7/8"	PC-86764	39'-1 1/16"	1 3/4"
1293'-4 7/8"	PC-86766	23'-5 3/16"	5/8"
1293'-4 7/8"	PC-86768	23'-4 1/4"	5/8" Δ
1293'-4 7/8"	PC-86770	31'-2 1/4"	1 1/8" Δ
1293'-4 7/8"	PC-86772	29'-2 9/16"	1" Δ

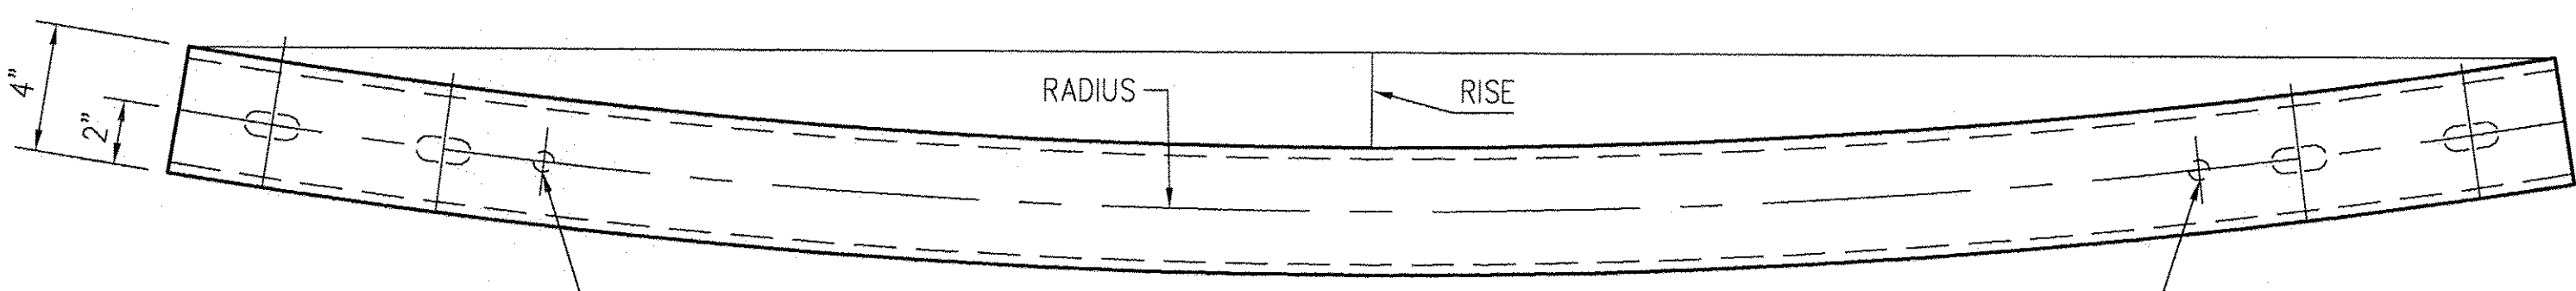

RAD.	PC	Length (ALONG CENTER LINE)	RISE
1253'-0 7/8"	PC-86753	25'-4 3/16"	3/4" Δ
1253'-0 7/8"	PC-86755	39'-2 1/2"	1 13/16"
1253'-0 7/8"	PC-86757	39'-1 3/8"	1 13/16"
1253'-0 7/8"	PC-86759	23'-5 3/8"	11/16"
1253'-0 7/8"	PC-86761	30'-1 5/16"	1 1/16"
1293'-4 7/8"	PC-86763	35'-2 1/4"	1 7/16"
1293'-4 7/8"	PC-86765	39'-1 1/16"	1 3/4"
1293'-4 7/8"	PC-86767	23'-5 3/16"	5/8"
1293'-4 7/8"	PC-86769	23'-4 1/4"	5/8" Δ
1293'-4 7/8"	PC-86771	31'-2 1/4"	1 1/8" Δ
1293'-4 7/8"	PC-86773	29'-2 9/16"	1" Δ

BILL OF MATERIAL

PRODUCT CODE	BRIDGE 25	DESCRIPTION	WT. EA.	REMARKS
Δ 86752G	1	TS 8" x 4" x 5/16" x 25'-4 3/16"	578 #	
86754G	1	TS 8" x 4" x 5/16" x 39'-2 1/2"	968 #	
86756G	4	TS 8" x 4" x 5/16" x 39'-1 3/8"	966 #	
86758G	1	TS 8" x 4" x 5/16" x 23'-5 3/8"	579 #	
86760G	1	TS 8" x 4" x 5/16" x 30'-1 5/16"	744 #	
86762G	1	TS 8" x 4" x 5/16" x 35'-2 1/4"	869 #	
86764G	4	TS 8" x 4" x 5/16" x 39'-1 1/16"	965 #	
86766G	1	TS 8" x 4" x 5/16" x 23'-5 3/16"	579 #	
Δ 86768G	1	TS 8" x 4" x 5/16" x 23'-4 1/4"	528 #	
Δ 86770G	1	TS 8" x 4" x 5/16" x 31'-2 1/4"	774 #	
Δ 86772G	1	TS 8" x 4" x 5/16" x 29'-2 9/16"	767 #	
Δ 86753G	1	TS 4" x 4" x 1/4" x 25'-4 3/16"	302 #	
86755G	1	TS 4" x 4" x 1/4" x 39'-2 1/2"	506 #	
86757G	4	TS 4" x 4" x 1/4" x 39'-1 3/8"	505 #	
86759G	1	TS 4" x 4" x 1/4" x 23'-5 3/8"	303 #	
86761G	1	TS 4" x 4" x 1/4" x 30'-1 5/16"	388 #	
86763G	1	TS 4" x 4" x 1/4" x 35'-2 1/4"	454 #	
86765G	4	TS 4" x 4" x 1/4" x 39'-1 1/16"	504 #	
86767G	1	TS 4" x 4" x 1/4" x 23'-5 3/16"	302 #	
Δ 86769G	1	TS 4" x 4" x 1/4" x 23'-4 1/4"	276 #	
Δ 86771G	1	TS 4" x 4" x 1/4" x 31'-2 1/4"	405 #	
Δ 86773G	1	TS 4" x 4" x 1/4" x 29'-2 9/16"	400 #	

NOTES: APPROVAL DRAWING

- FOR GENERAL NOTES PLEASE REFER TO SHEET D1 OF 4
- FOR ERECTION DETAILS SEE SHEET E1 OF 4 (22) 1006227
- FOR RAILING LAYOUT SEE SHEET E2 OF 4 (22) 1006227
- DETAIL DIMENSION SHOWN ARE ALONG CENTER LINE OF RAIL.

VAOT RECEIVED
 CK'D BY: *Rita*
 JAN 29 2003
 RESUBMIT APPROVED
 BY: *RHW* DATE: 1-30-03

This drawing and the information shown thereon is the sole property of TRINITY INDUSTRIES, INC. Neither the drawing nor such information is to be used for any purpose other than that for which it was specifically furnished by TRINITY INDUSTRIES, INC., nor is any reproduction authorized without written permission.

GIRARD ENGINEERING DEPT.
 ISSUED
 JAN 15 2003
 TRINITY INDUSTRIES, INC.
 170 N. STATE STREET
 GIRARD, OHIO 44420

REV.	CHK'D	BY	DATE	REMARKS
Δ		SAR	1/02/03	REVISED CALL OUTS
PAY ITEM NUMBER 525.33 BR. RAIL 2 BAR NETC				
STATE OF VERMONT AGENCY OF TRANSPORTATION VT. ROUTE 9 - TOWNS OF SEARSBURGH & WILMINGTON COUNTIES OF BENNINGTON & WINDHAM STATE PROJECT NO. NHF 010-1(18) BRIDGE No. 25				DRAWN SAR CHECKED S.H. SCALE: N.T.S.
CUSTOMER NORTHLAND SPECIALITES		P.O. No. VERBAL		DATE 11/13/02
TRINITY INDUSTRIES, INC. HIGHWAY SAFETY PRODUCTS 2525 STEMMONS FREEWAY, DALLAS, TX 75207				ENG. FILE # 22-1006227-D2 SHT.No. D2 OF 4 TRINITY SALES ORDER NO. (22) 1006227
				REV. 1