


DATE: _____
 BY: _____
 CHECKED: _____
 PLAN NO. _____

DATE: _____
 BY: _____
 CHECKED: _____
 PROFILE NO. _____



LINES SHOWN ON THIS PLAN AS EXISTING PROPERTY LINES (P/L) ARE BELIEVED TO BE ACCURATE BUT SHOULD NOT BE RELIED UPON FOR PURPOSES UNRELATED TO THE STATE OF VERMONT'S ACQUISITION OF LAND AND RIGHTS FOR THIS PROJECT.

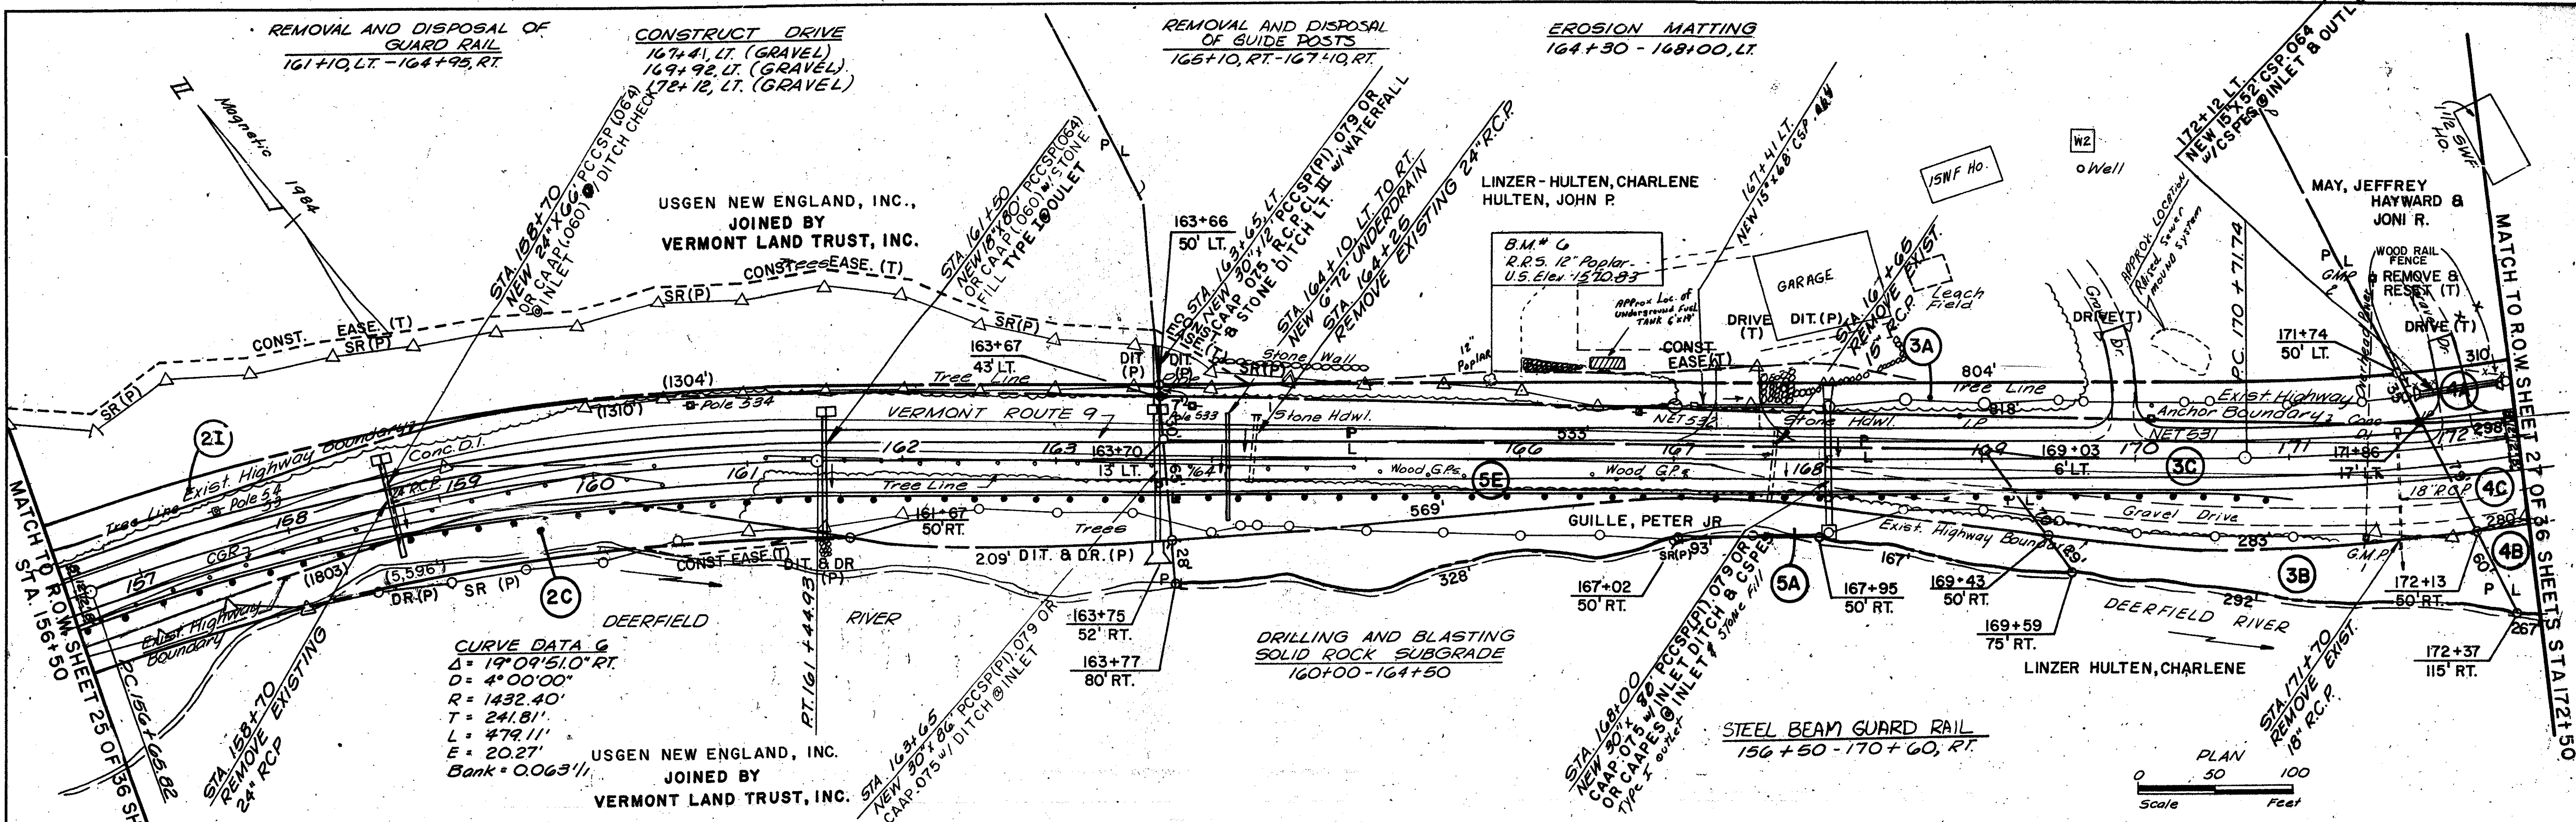