
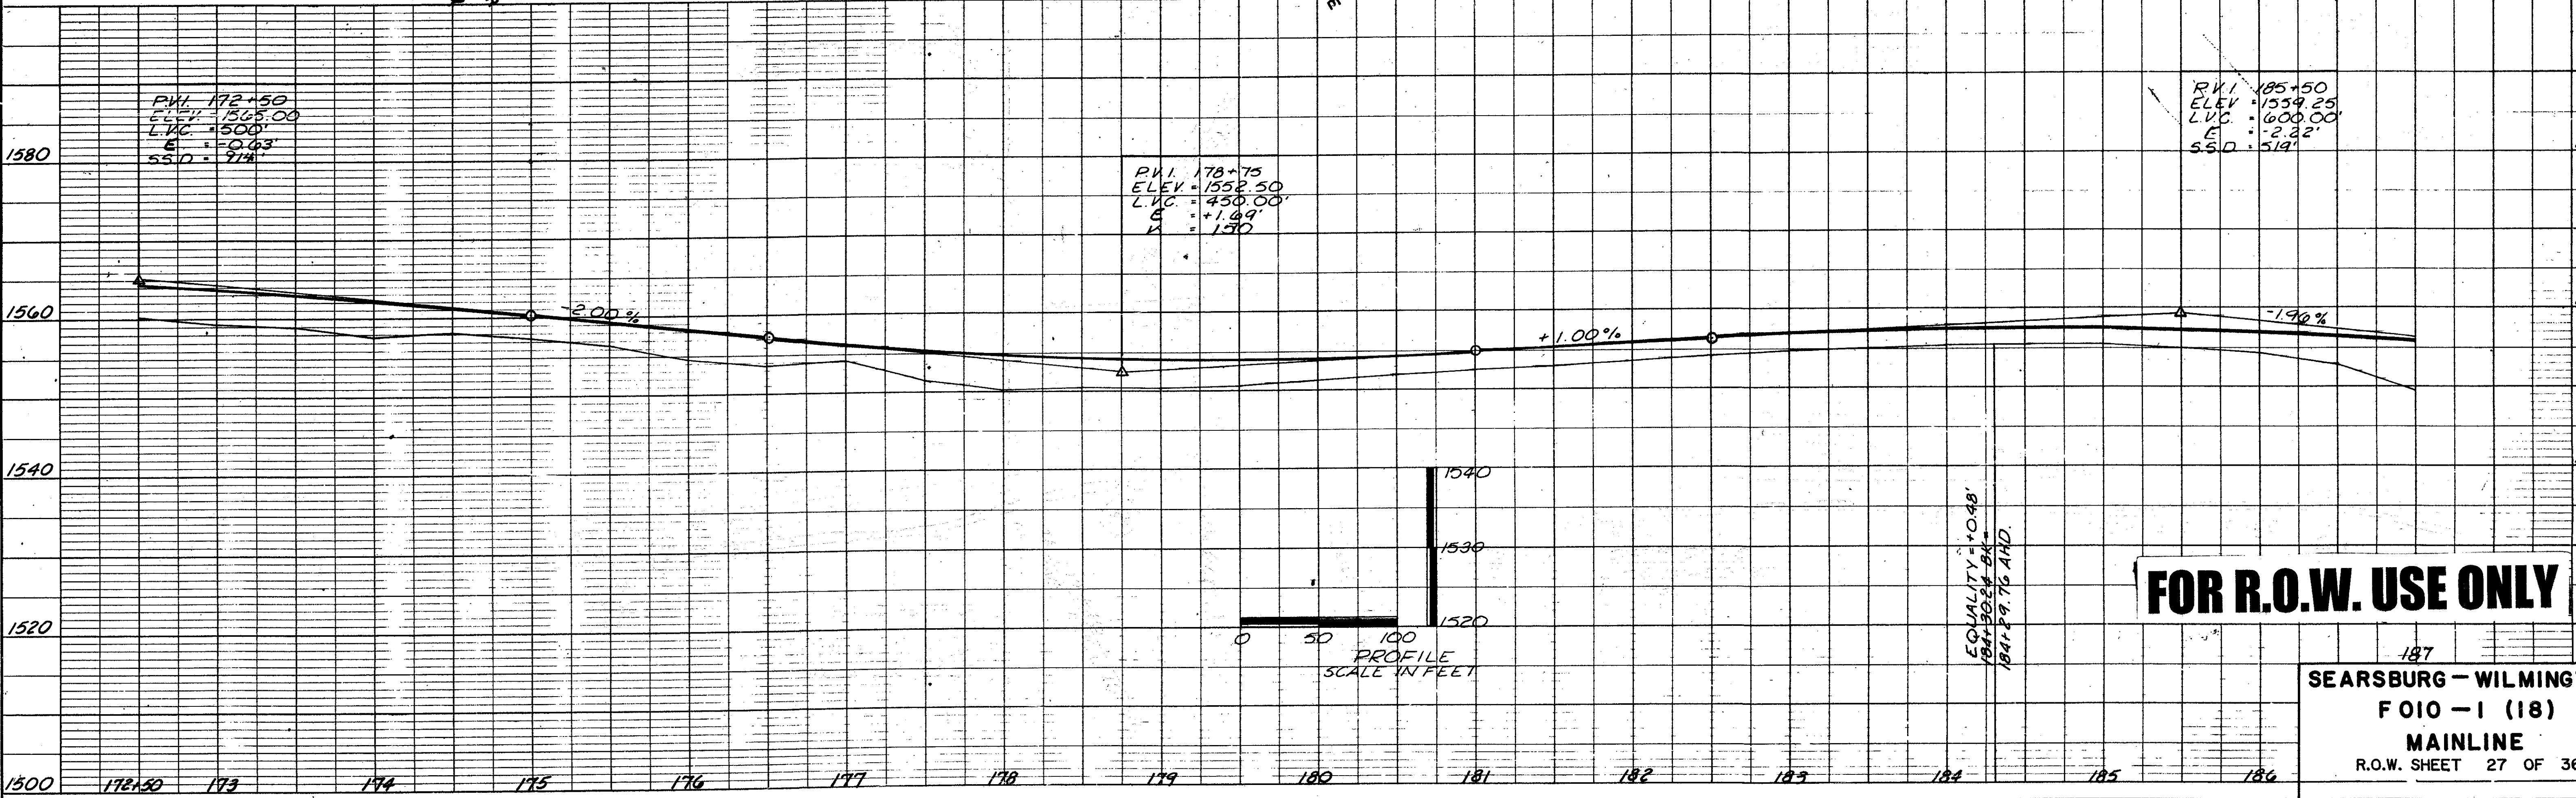


PLAN
 NOTE BOOK
 NO. OF WAY CHECKED

PROFILE
 NOTE BOOK
 NO. OF WAY CHECKED

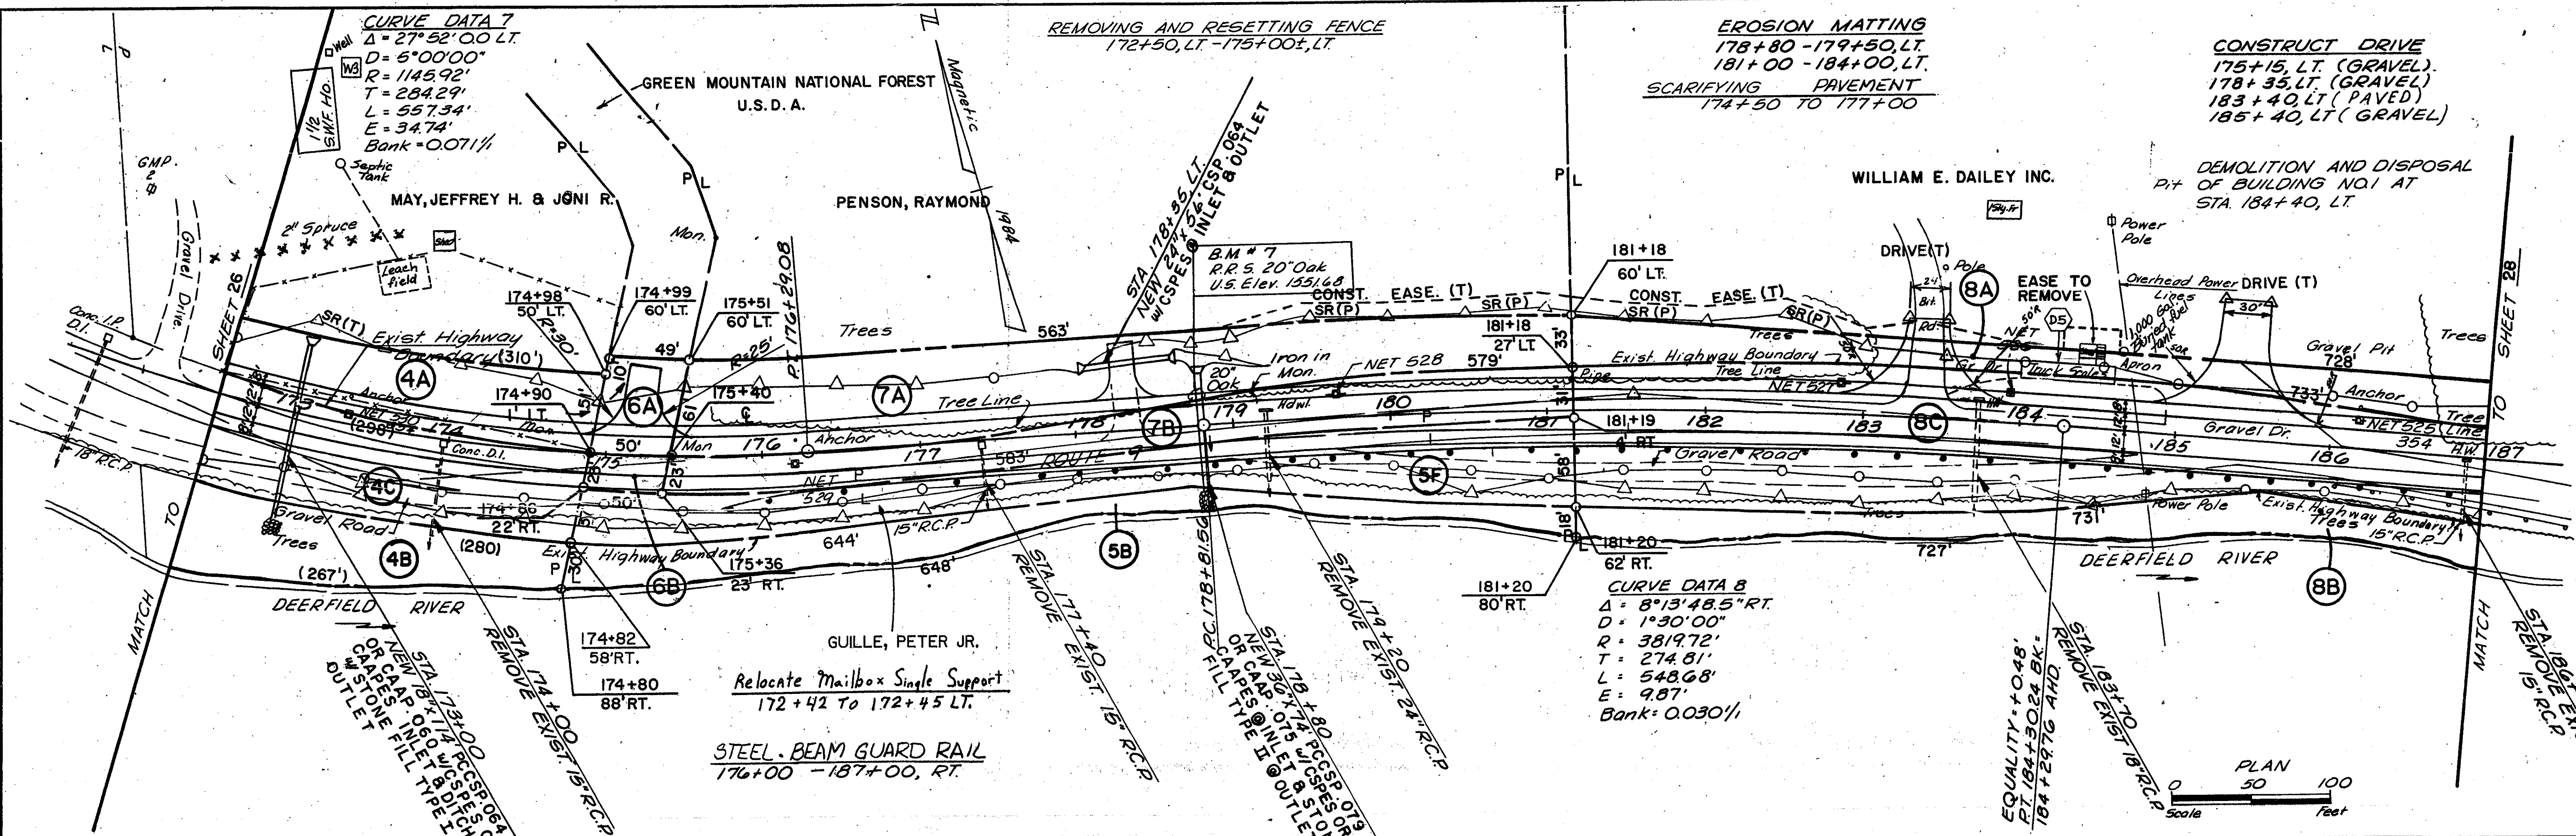

FOR R.O.W. USE ONLY

187
 SEARSBURG - WILMINGTON
 FOIO - I (18)
 MAINLINE
 R.O.W. SHEET 27 OF 36