



DATE	
BY	
REVISION	
NO.	
PLAN	
NOTE BOOK	
NO.	

DATE	
BY	
REVISION	
NO.	
PROFILE	
NOTE BOOK	
NO.	

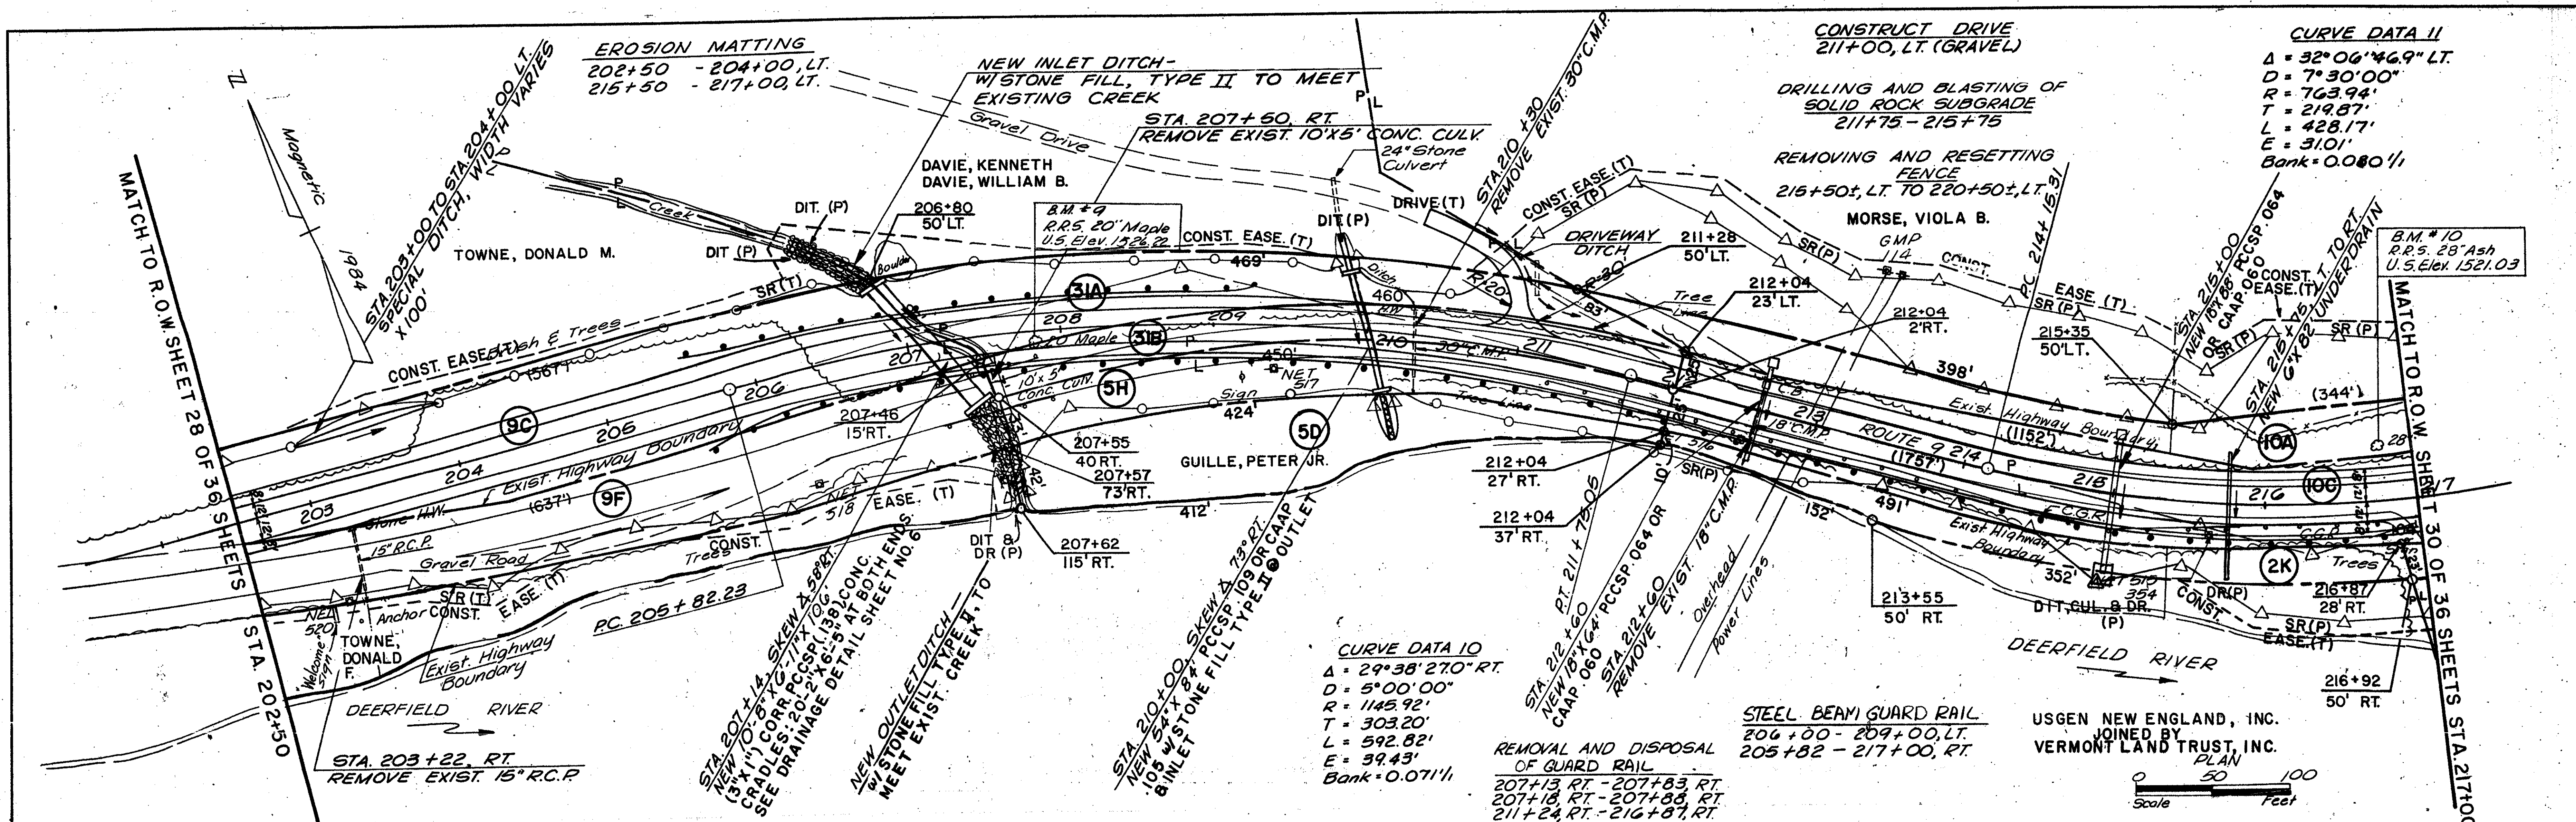

LINES SHOWN ON THIS PLAN AS EXISTING PROPERTY LINES (P/L) ARE BELIEVED TO BE ACCURATE BUT SHOULD NOT BE RELIED UPON FOR PURPOSES UNRELATED TO THE STATE OF VERMONT'S ACQUISITION OF LAND AND RIGHTS FOR THIS PROJECT.

P.K. 213+25
ELEV. = 1524.66
L.V.C. = 400'
E = 1.45'
S.S.D. = 0.38'

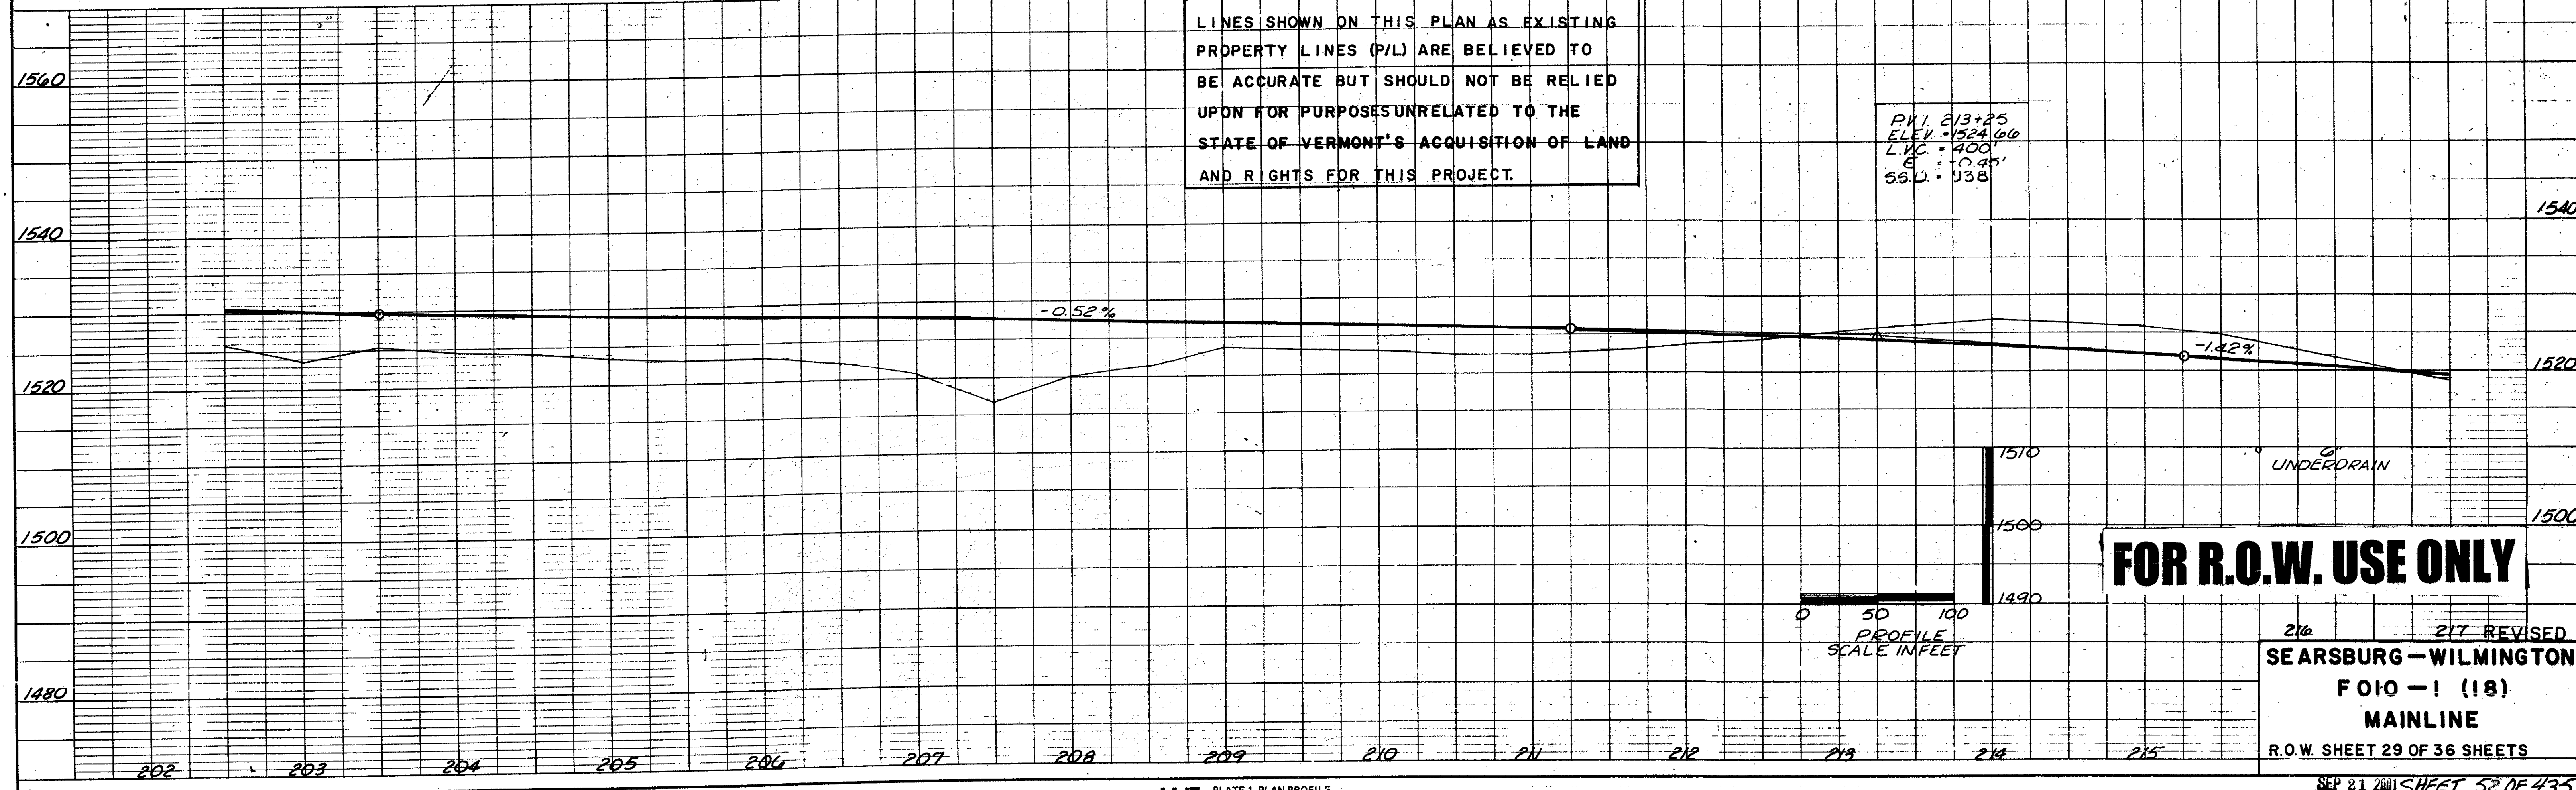

FOR R.O.W. USE ONLY

216 217 REVISED
SEARSBURG - WILMINGTON
FOIO - I (18)
MAINLINE
R.O.W. SHEET 29 OF 36 SHEETS