



DATE	
BY	
REVISION	
NO. 1	
NO. 2	
NO. 3	
NO. 100	

DATE	
BY	
REVISION	
NO. 1	
NO. 2	
NO. 3	
NO. 100	

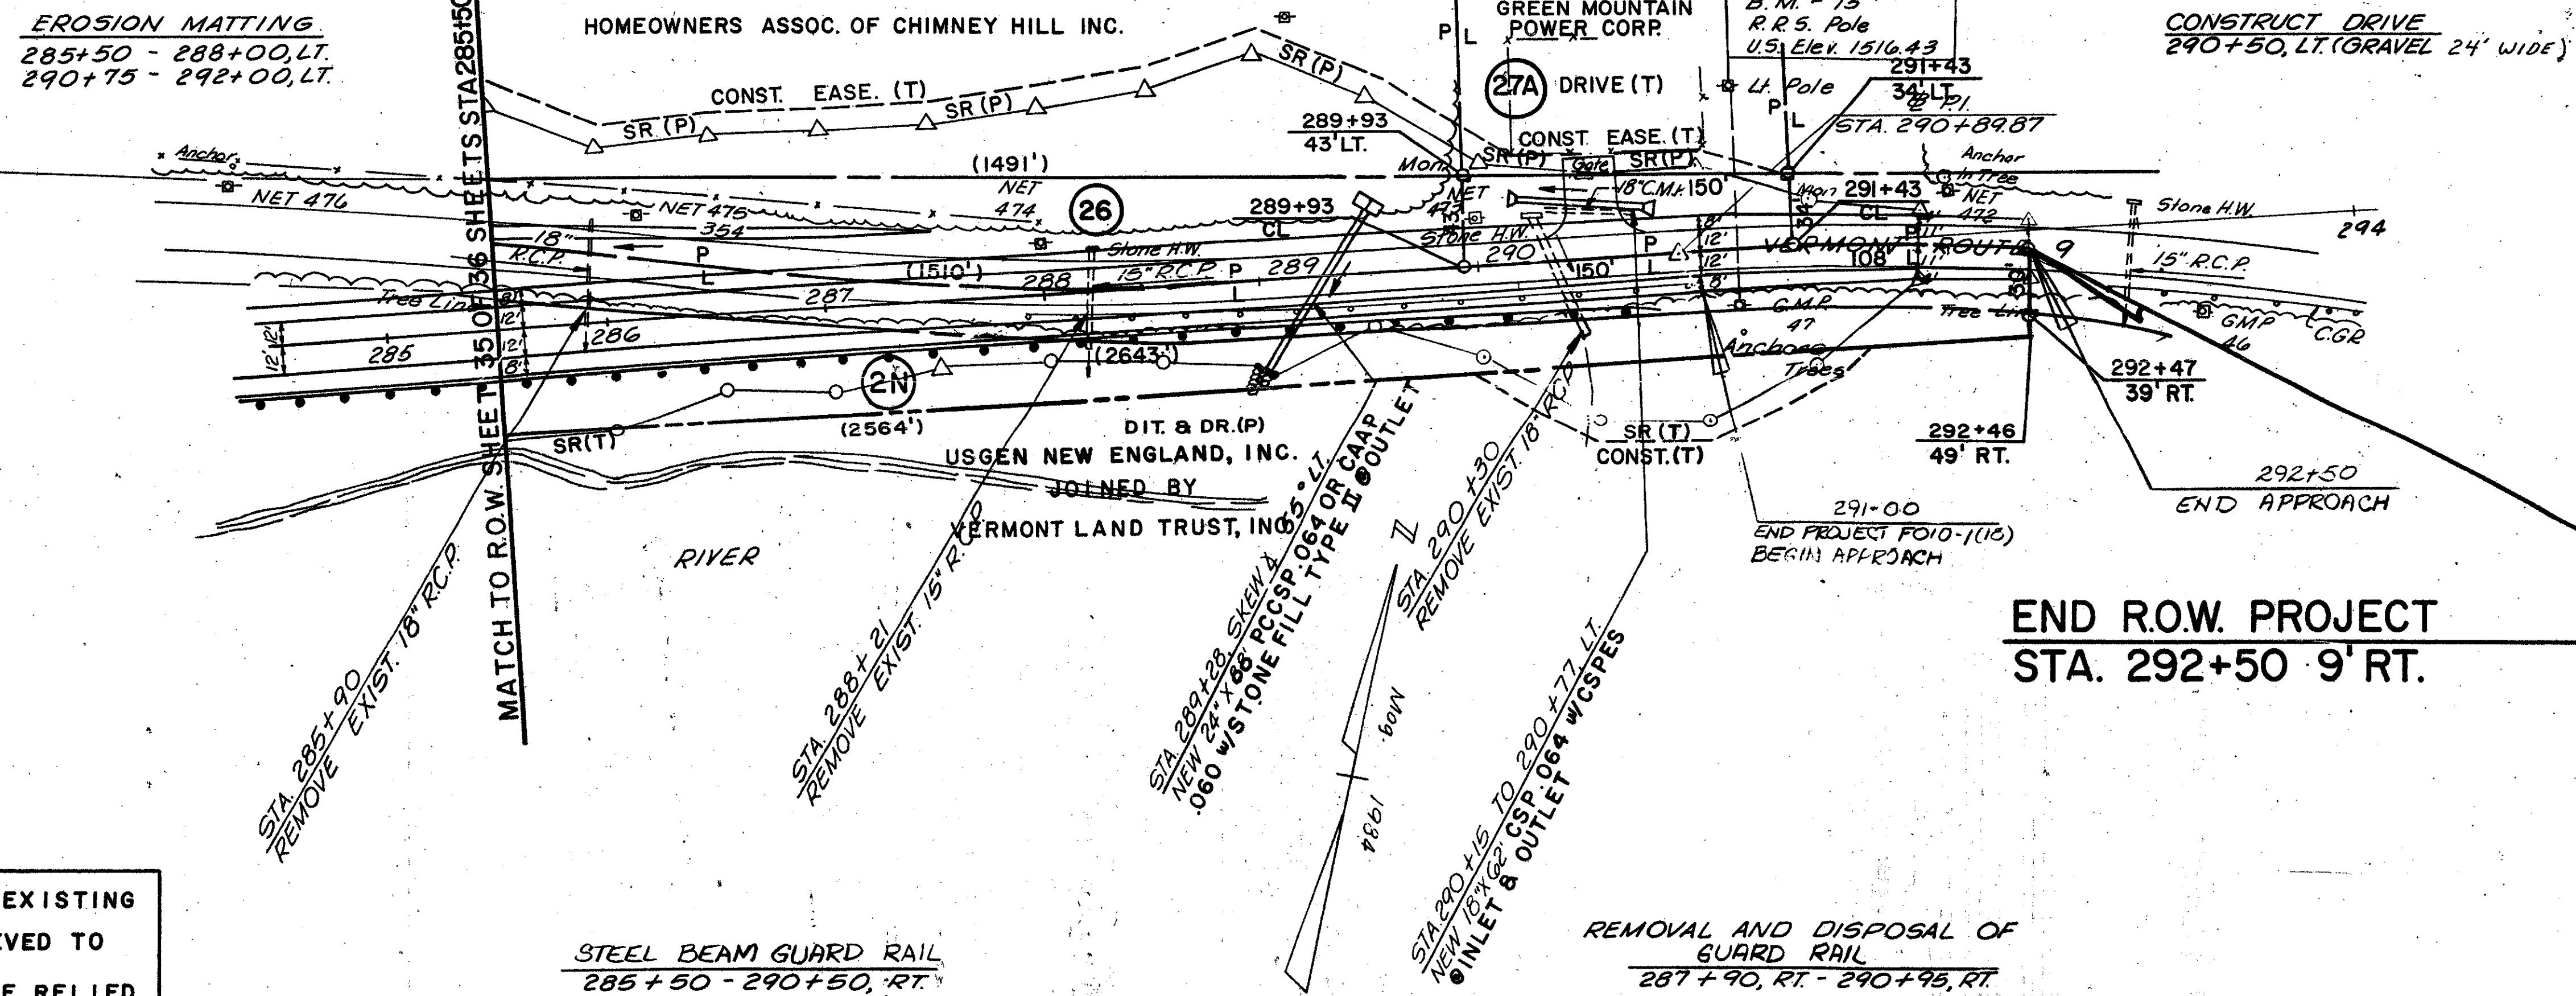

LINES SHOWN ON THIS PLAN AS EXISTING PROPERTY LINES (P/L) ARE BELIEVED TO BE ACCURATE BUT SHOULD NOT BE RELIED UPON FOR PURPOSES UNRELATED TO THE STATE OF VERMONT'S ACQUISITION OF LAND AND RIGHTS FOR THIS PROJECT.

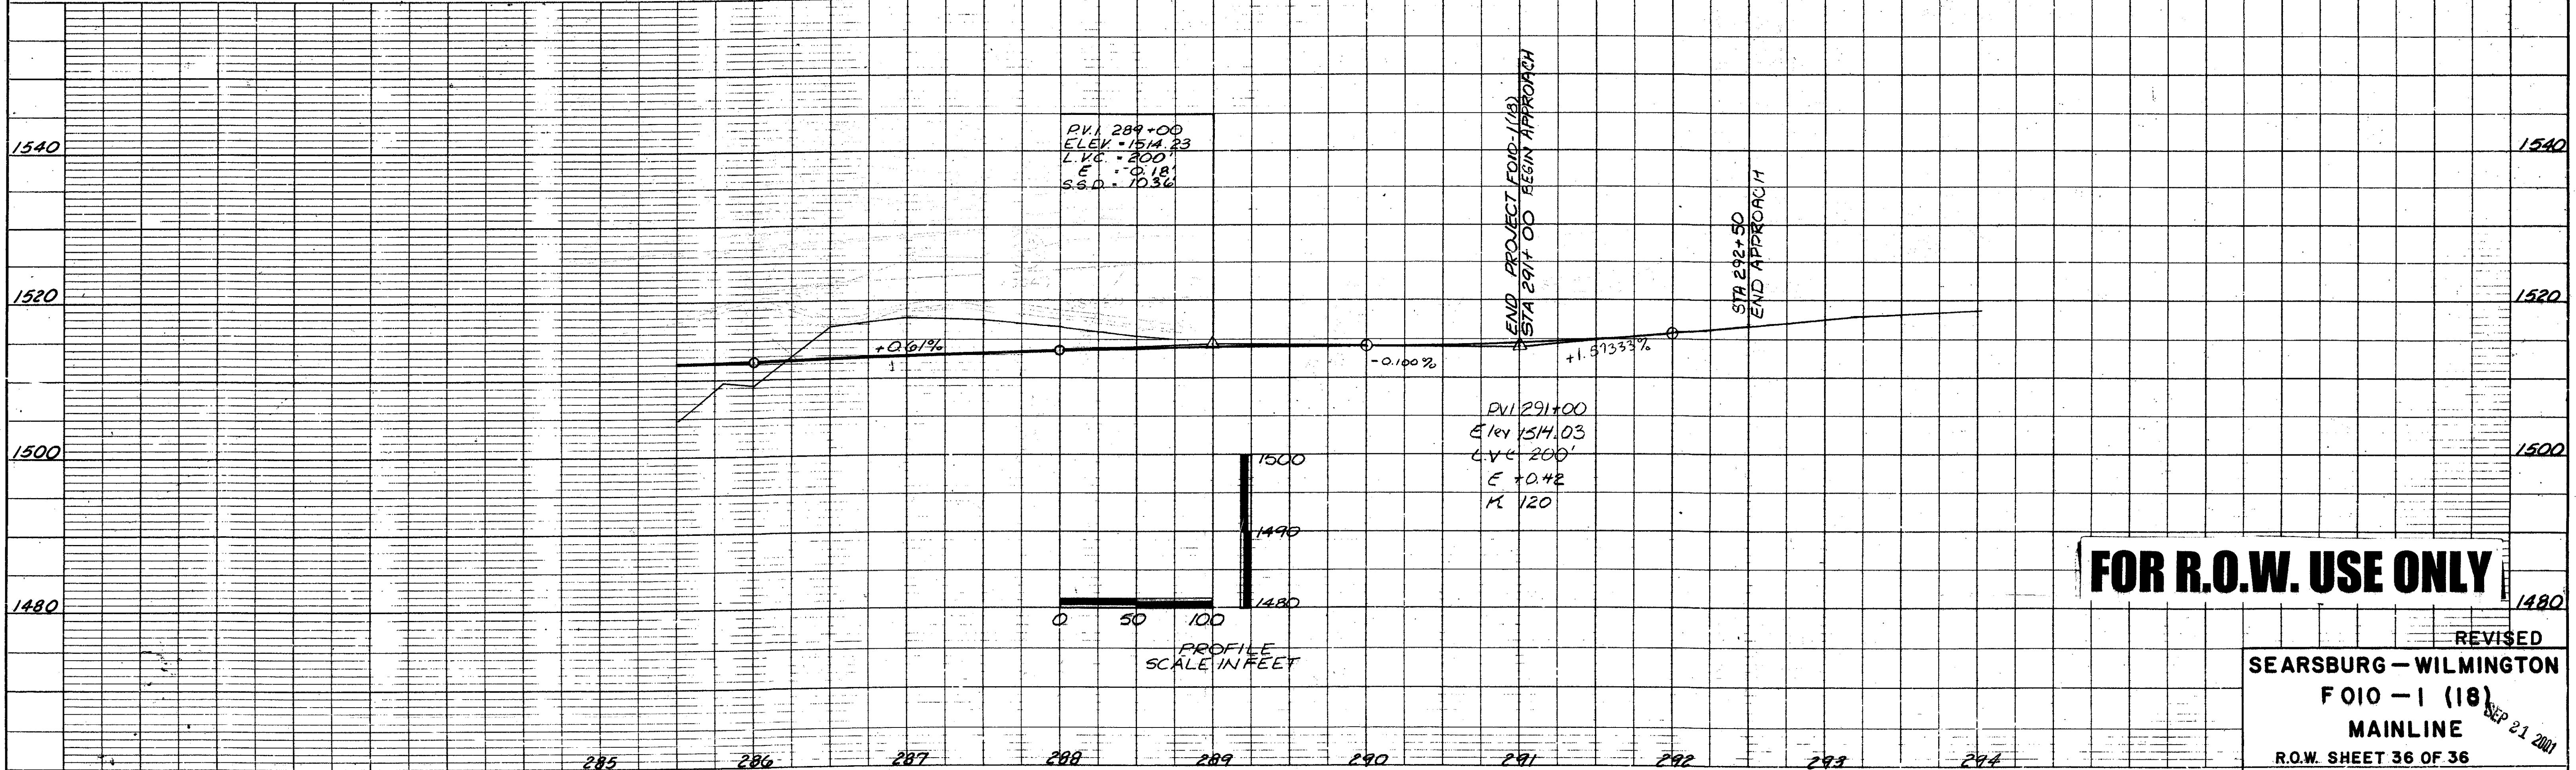

FOR R.O.W. USE ONLY

REVISED
SEARSBURG - WILMINGTON
FOIO - 1 (18)
MAINLINE
R.O.W. SHEET 36 OF 36