


DATE: _____ BY: _____
 PLAN
 NOTE BOOK ALIGNMENT CHECKED
 NO. _____

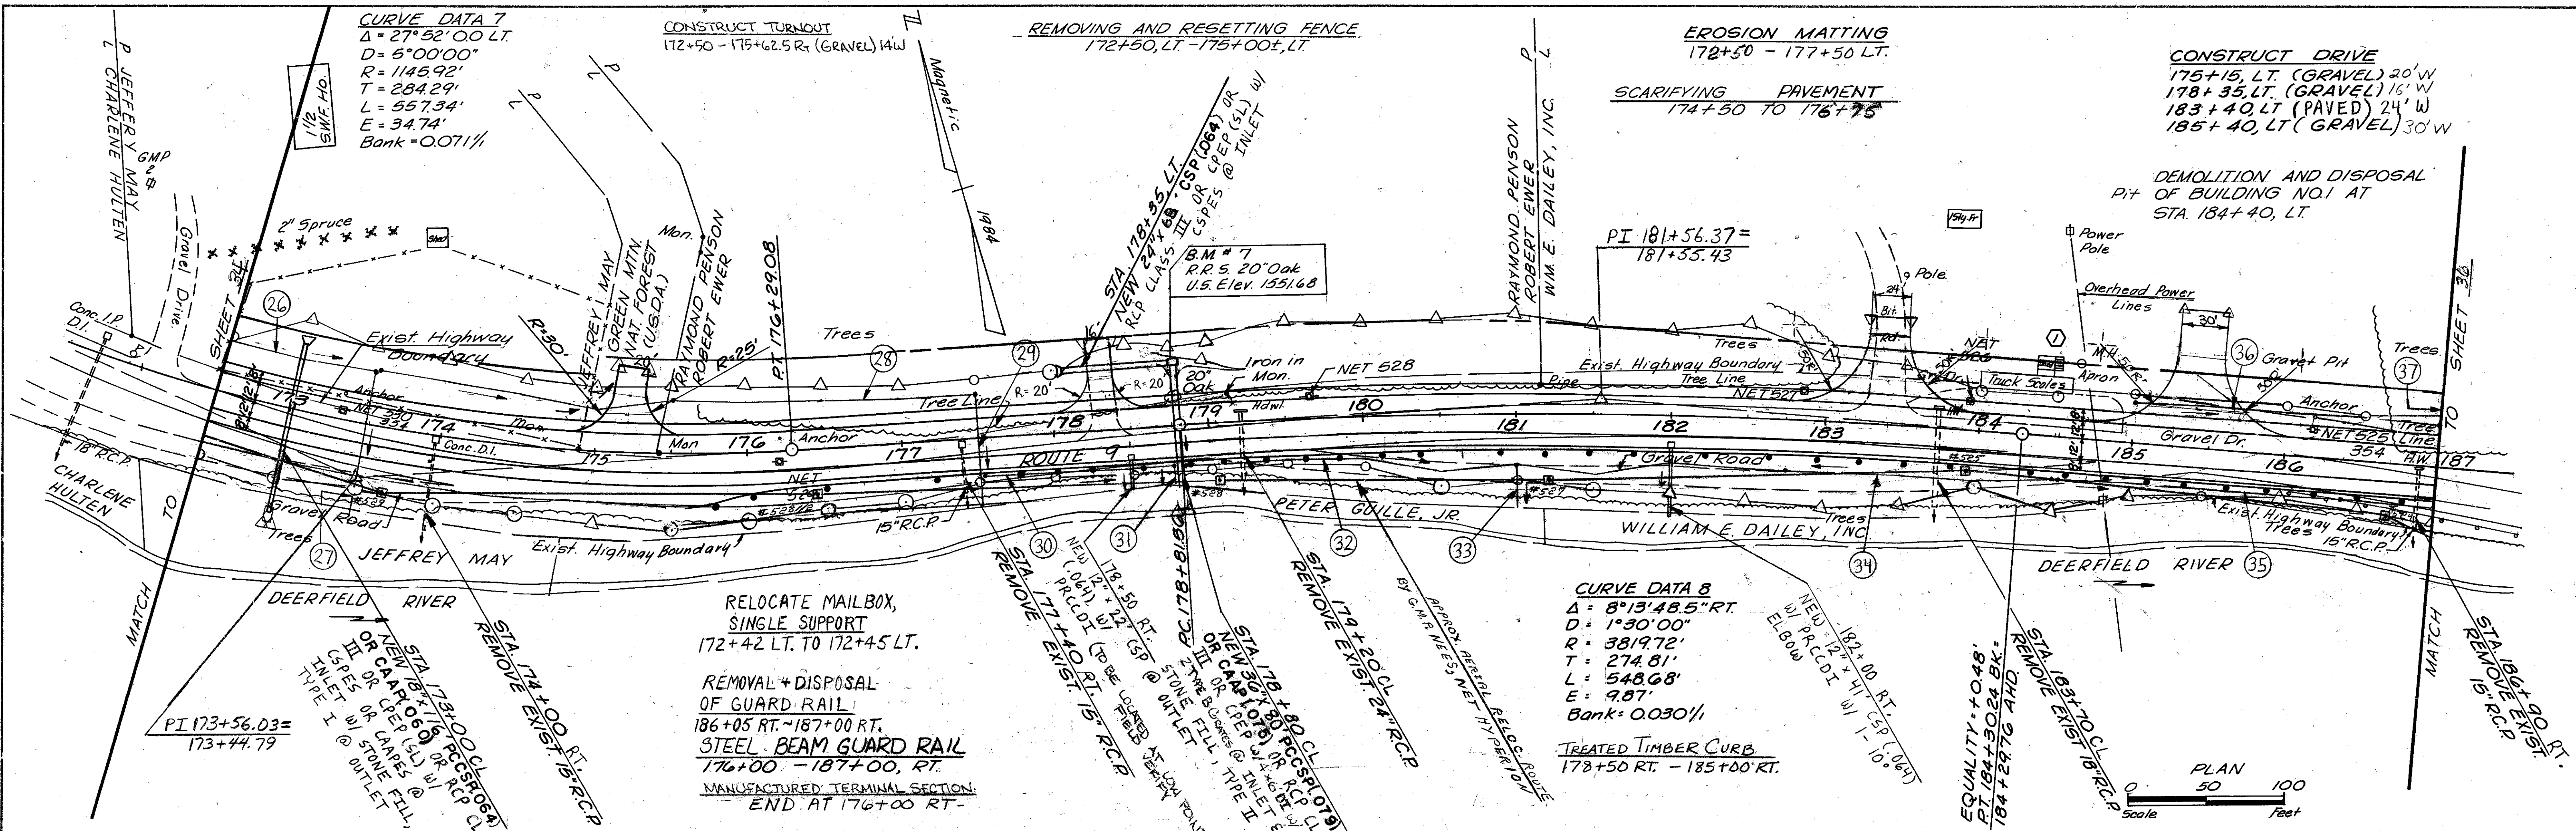

DATE: _____ BY: _____
 PROFILE
 NOTE BOOK GRADE CHECKED
 NO. _____

