
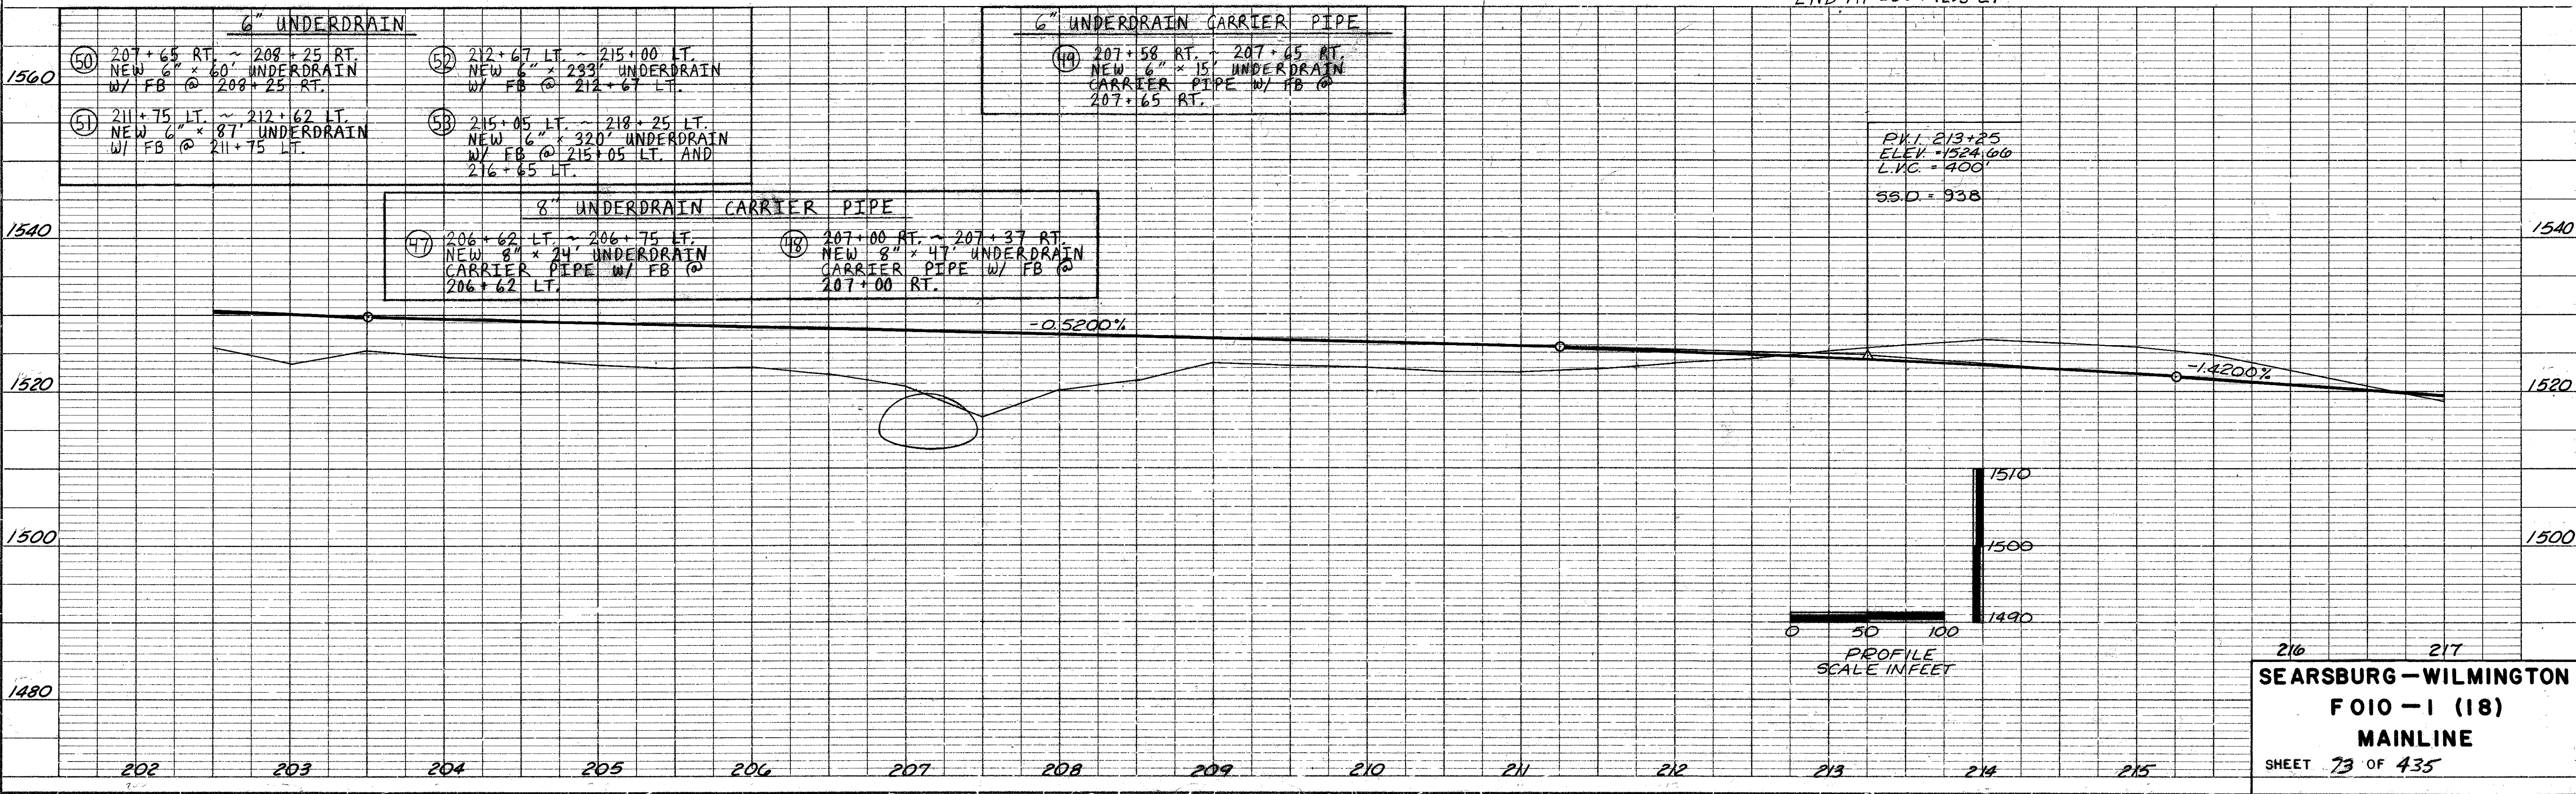


DATE: _____ BY: _____
 PROFILE GRADES CHECKED: _____
 PLAN GRADES CHECKED: _____
 ALIGNMENT CHECKED: _____
 E.T. OF WAY CHECKED: _____
 NO. _____

DATE: _____ BY: _____
 PROFILE GRADES CHECKED: _____
 PLAN GRADES CHECKED: _____
 ALIGNMENT CHECKED: _____
 E.T. OF WAY CHECKED: _____
 NO. _____

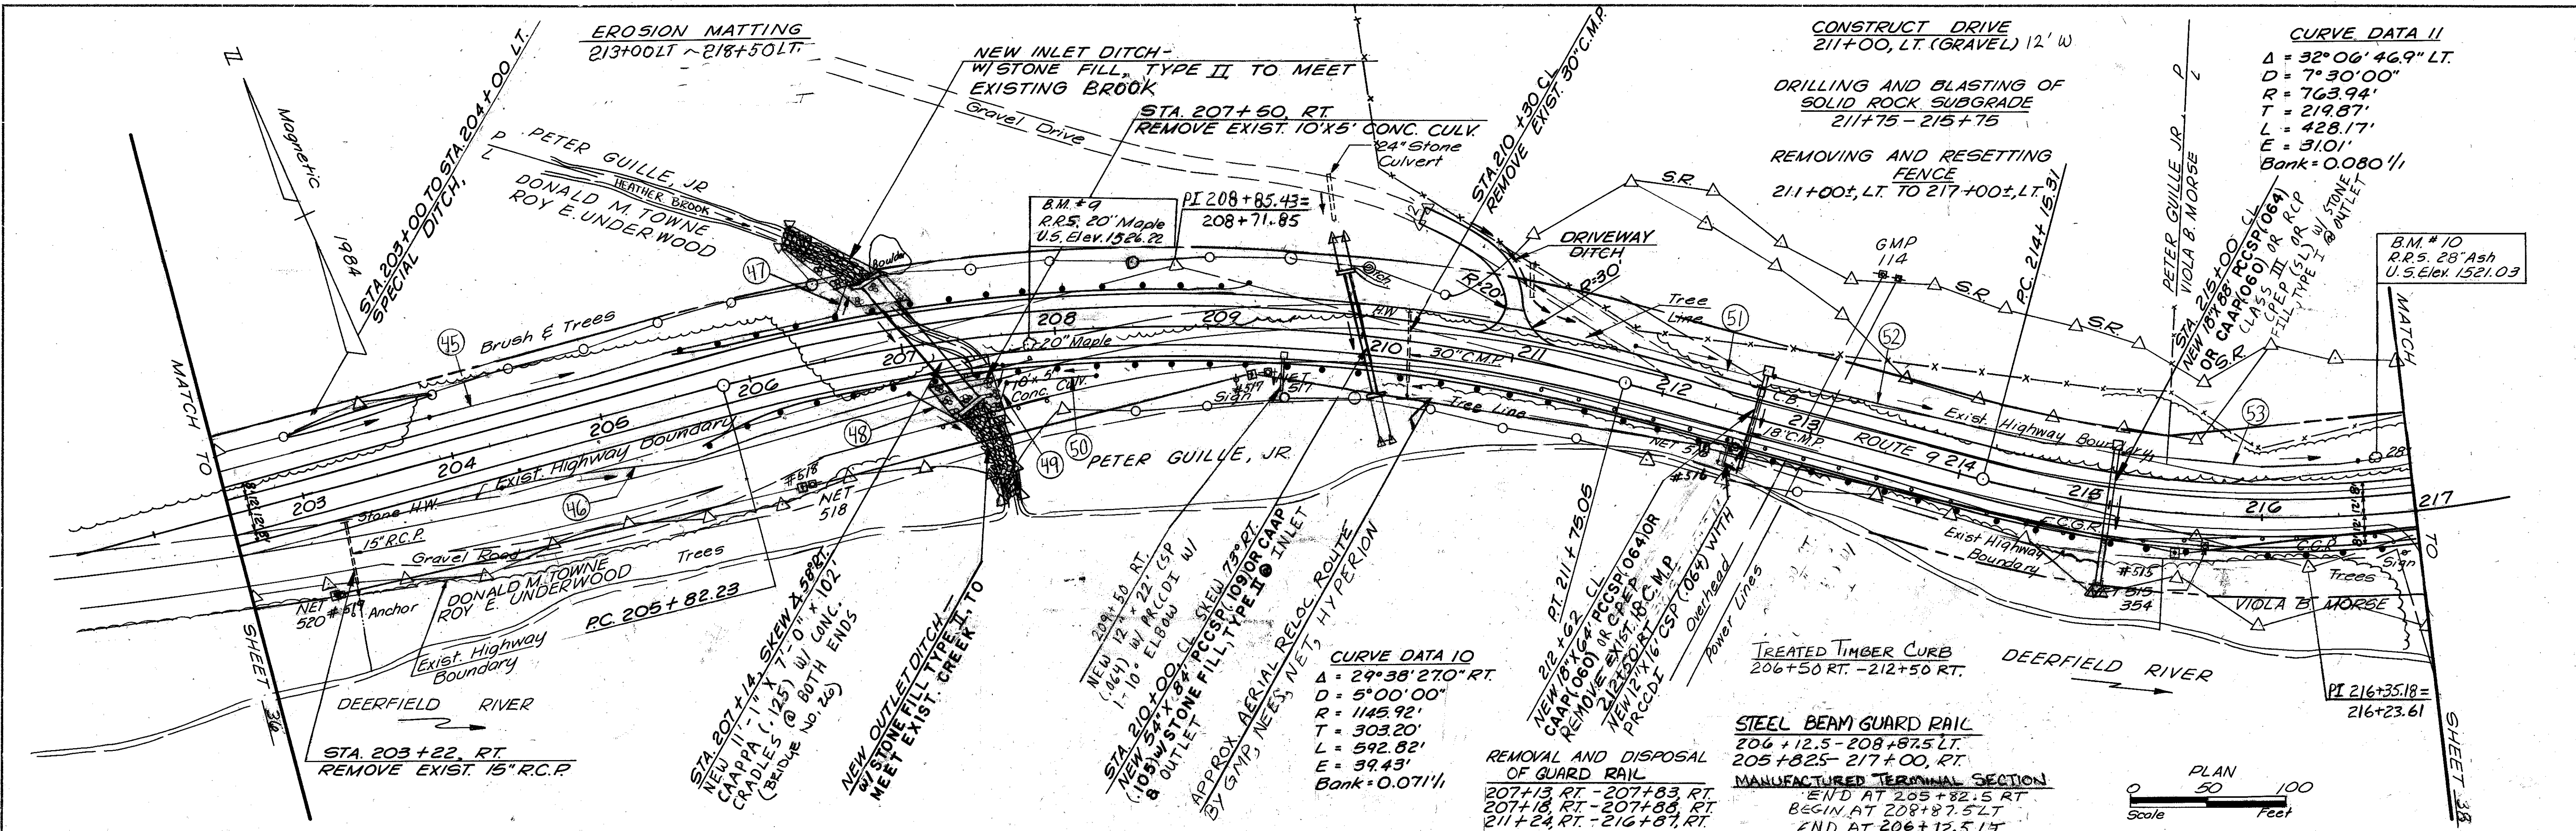

216 217
SEARSBURG - WILMINGTON
F010 - 1 (18)
MAINLINE
 SHEET 73 OF 435