



DATE	
BY	
REVISION	
NOTED	
ALIGNED	
NOTE BOOK	
NO.	
DATE	
BY	
REVISION	
NOTED	
ALIGNED	
NOTE BOOK	
NO.	

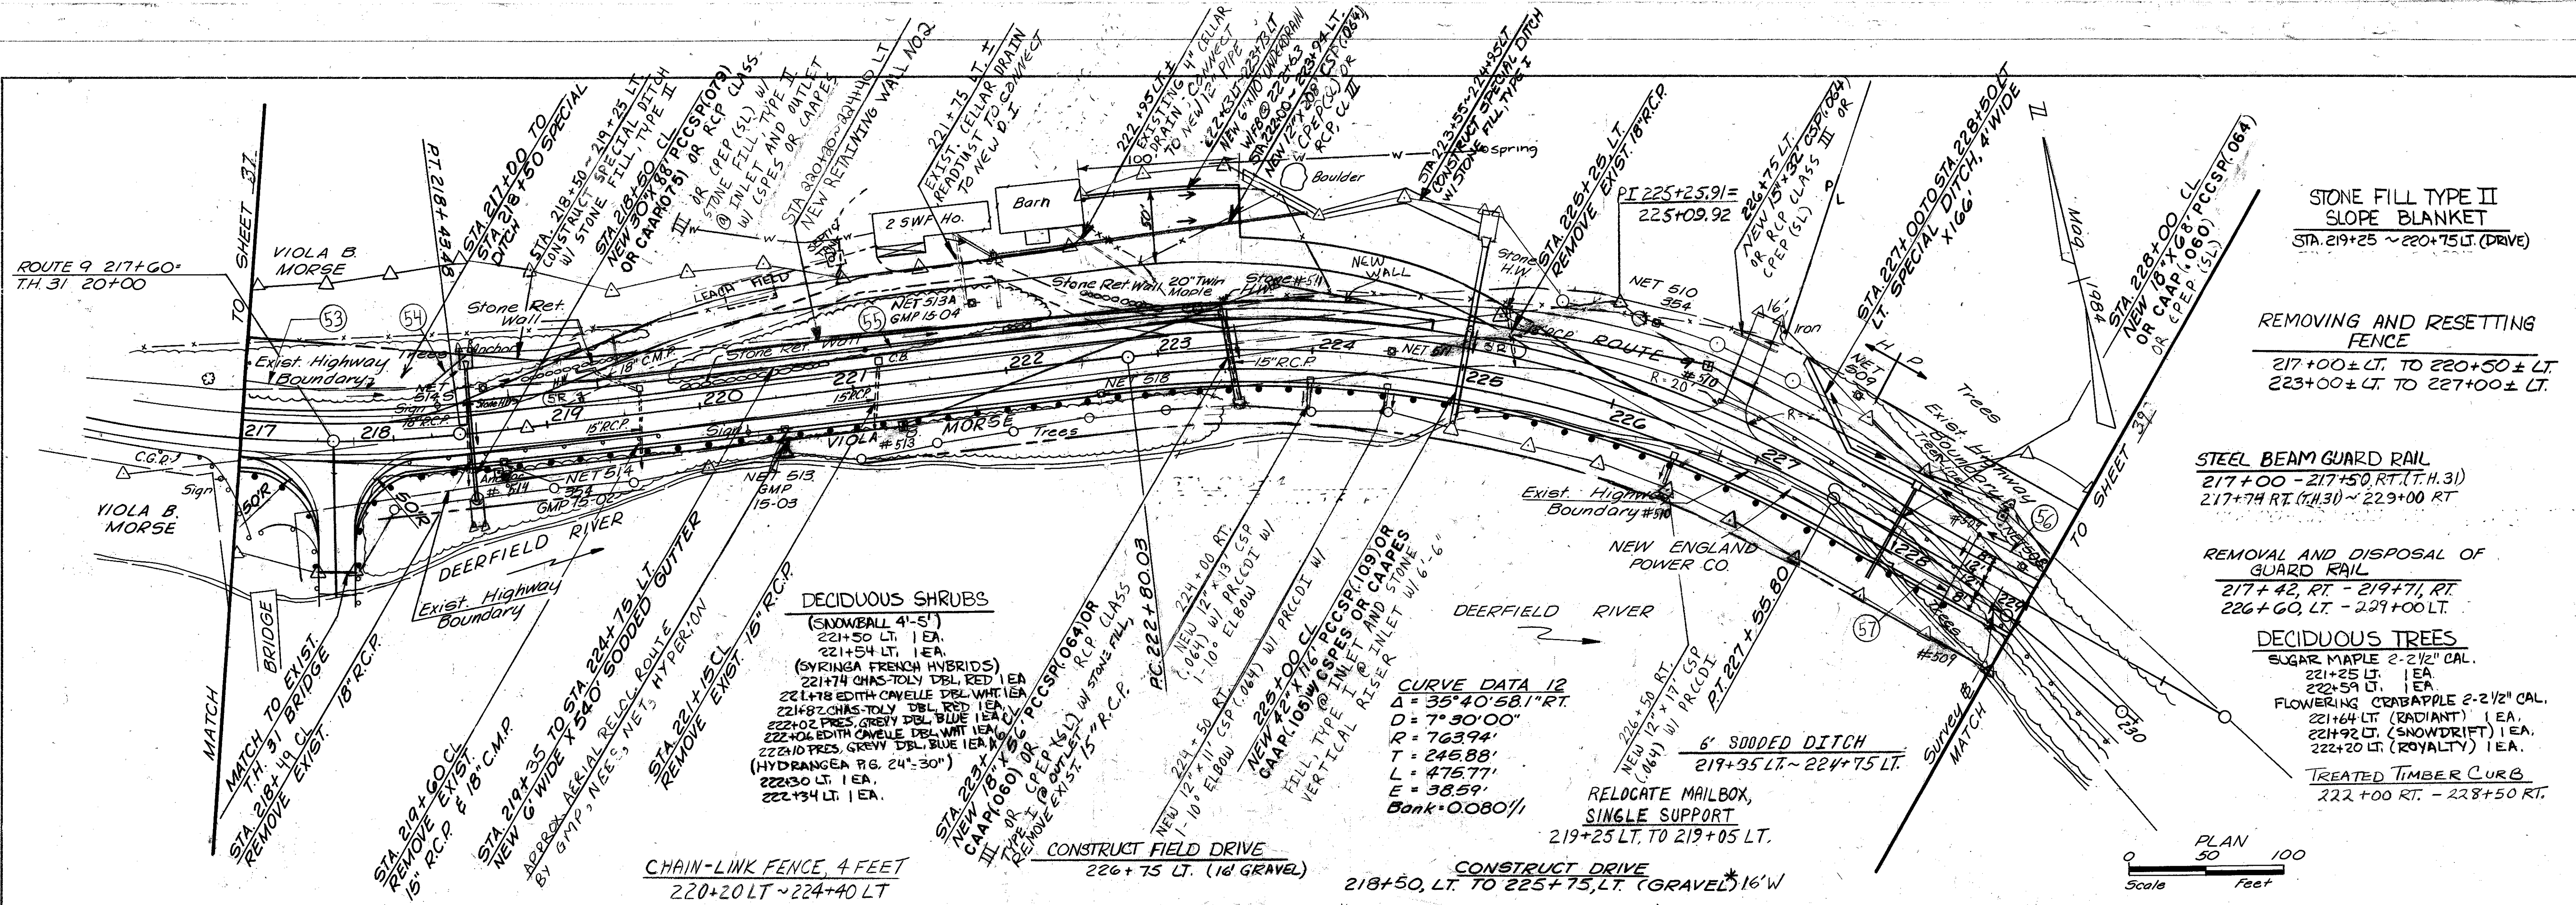

DATE	
BY	
REVISION	
NOTED	
ALIGNED	
NOTE BOOK	
NO.	
DATE	
BY	
REVISION	
NOTED	
ALIGNED	
NOTE BOOK	
NO.	

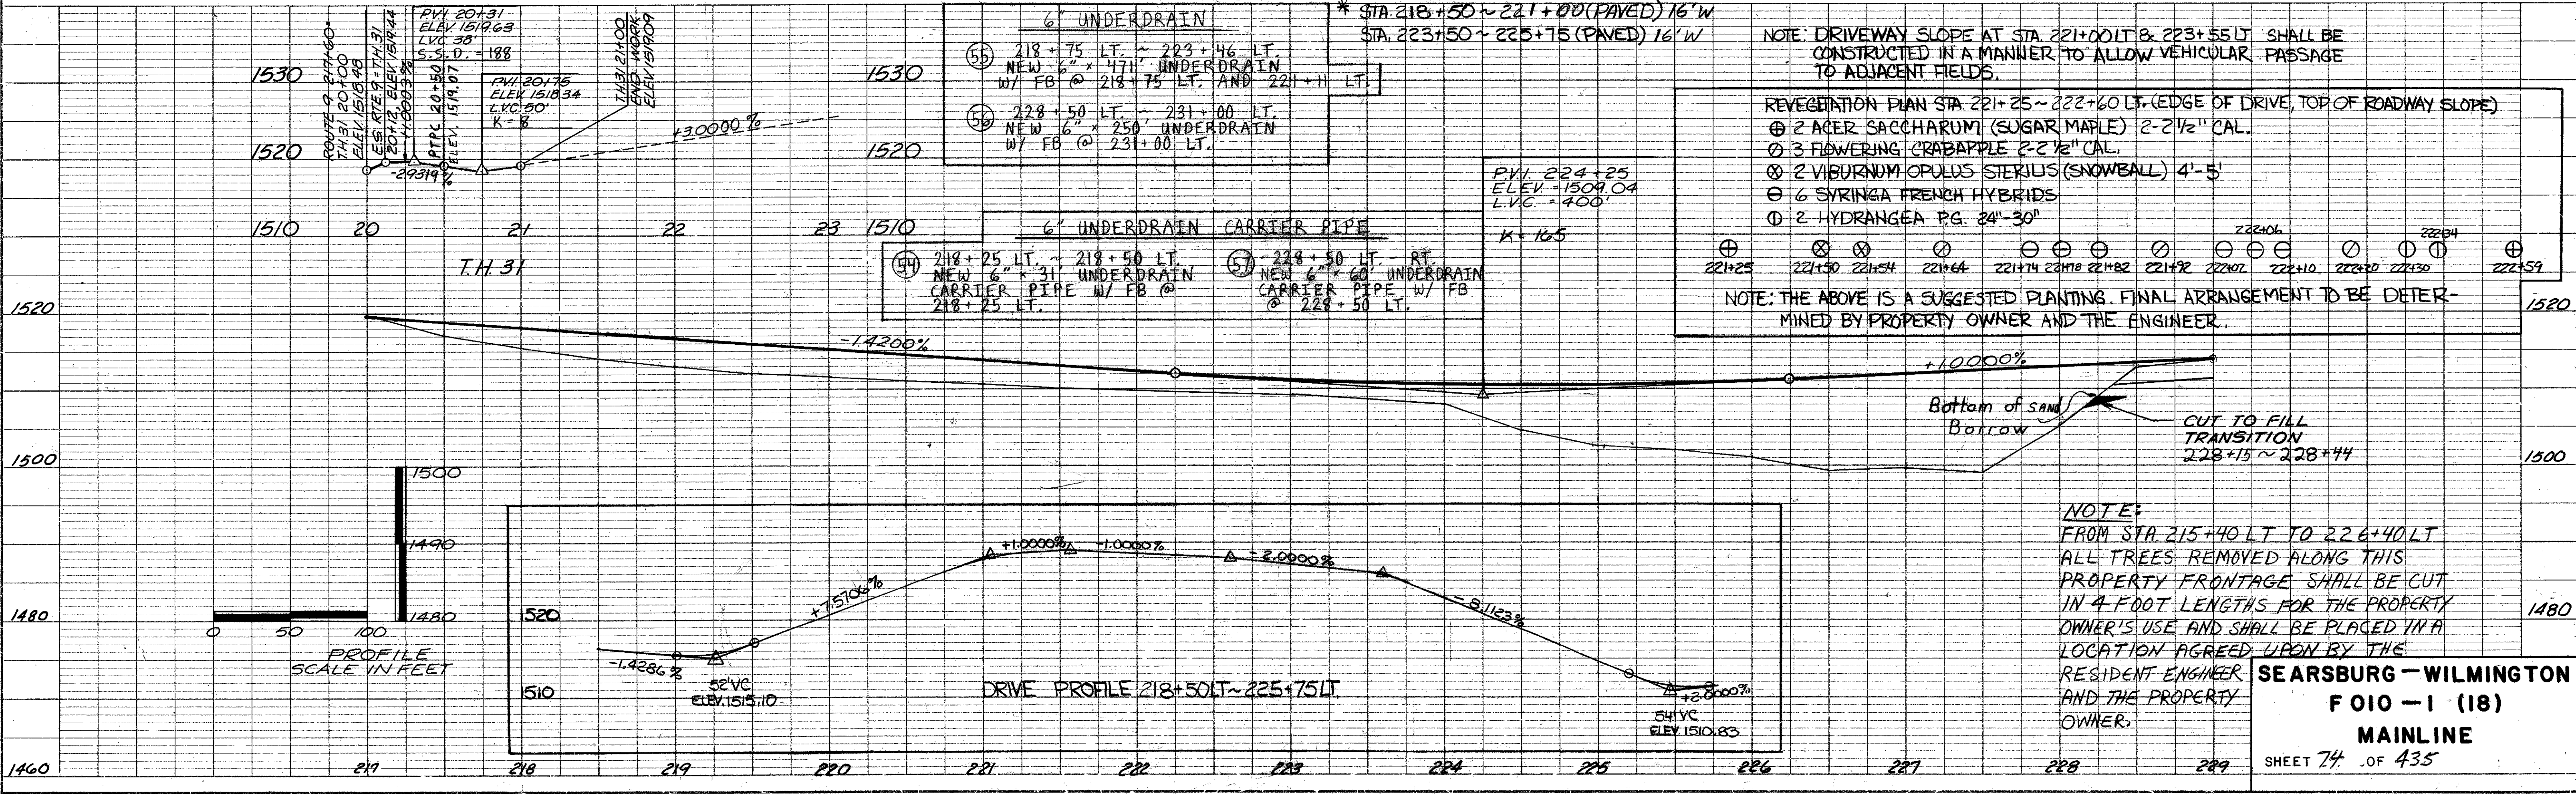

SEARSBURG - WILMINGTON  
FOIO - 1 (18)  
MAINLINE  
SHEET 74 OF 435