
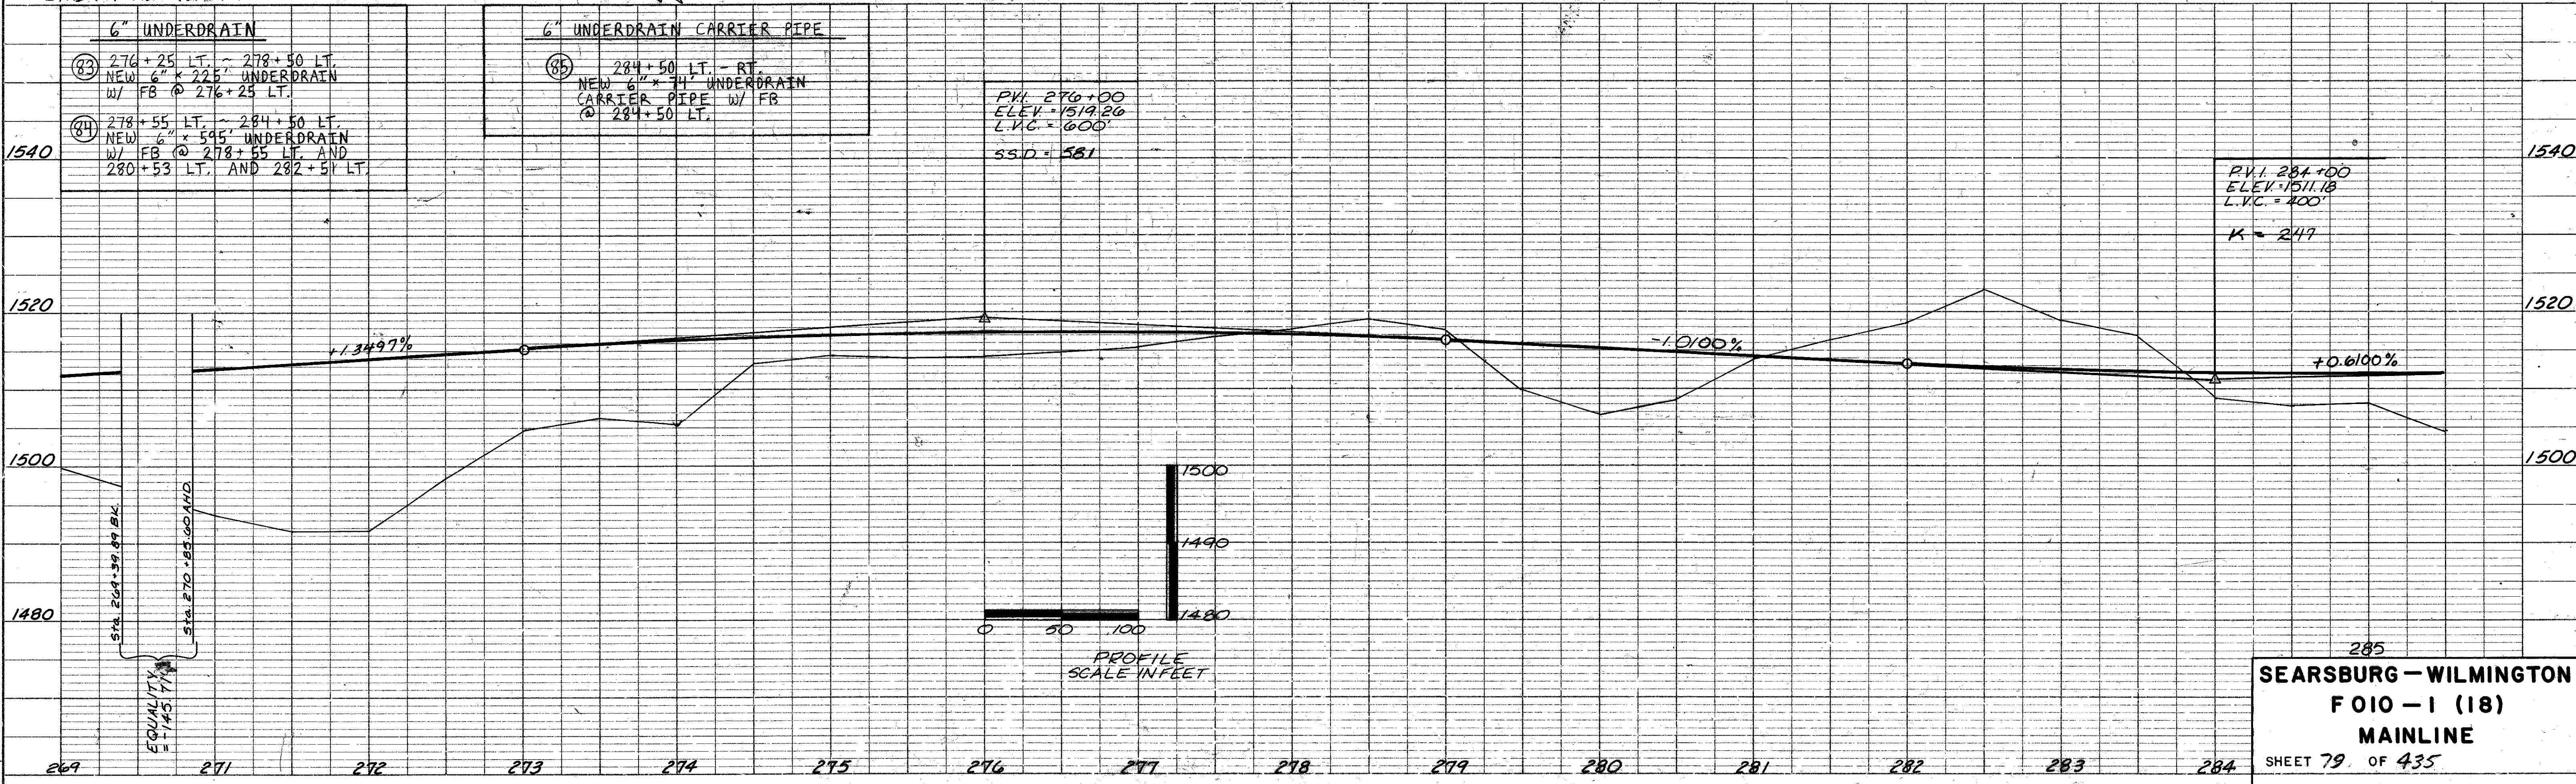


DATE: _____
 BY: _____
 SURVEYED: _____
 NOTE BOOK: _____
 ALIGNMENT CHECKED: _____
 RT. OF WAY CHECKED: _____
 No. _____

DATE: _____
 BY: _____
 SURVEYED: _____
 NOTE BOOK: _____
 GRADE CHECKED: _____
 R. M. V. NOTED: _____
 SUBMITTAL SIGNATURE CHECKED: _____
 No. _____

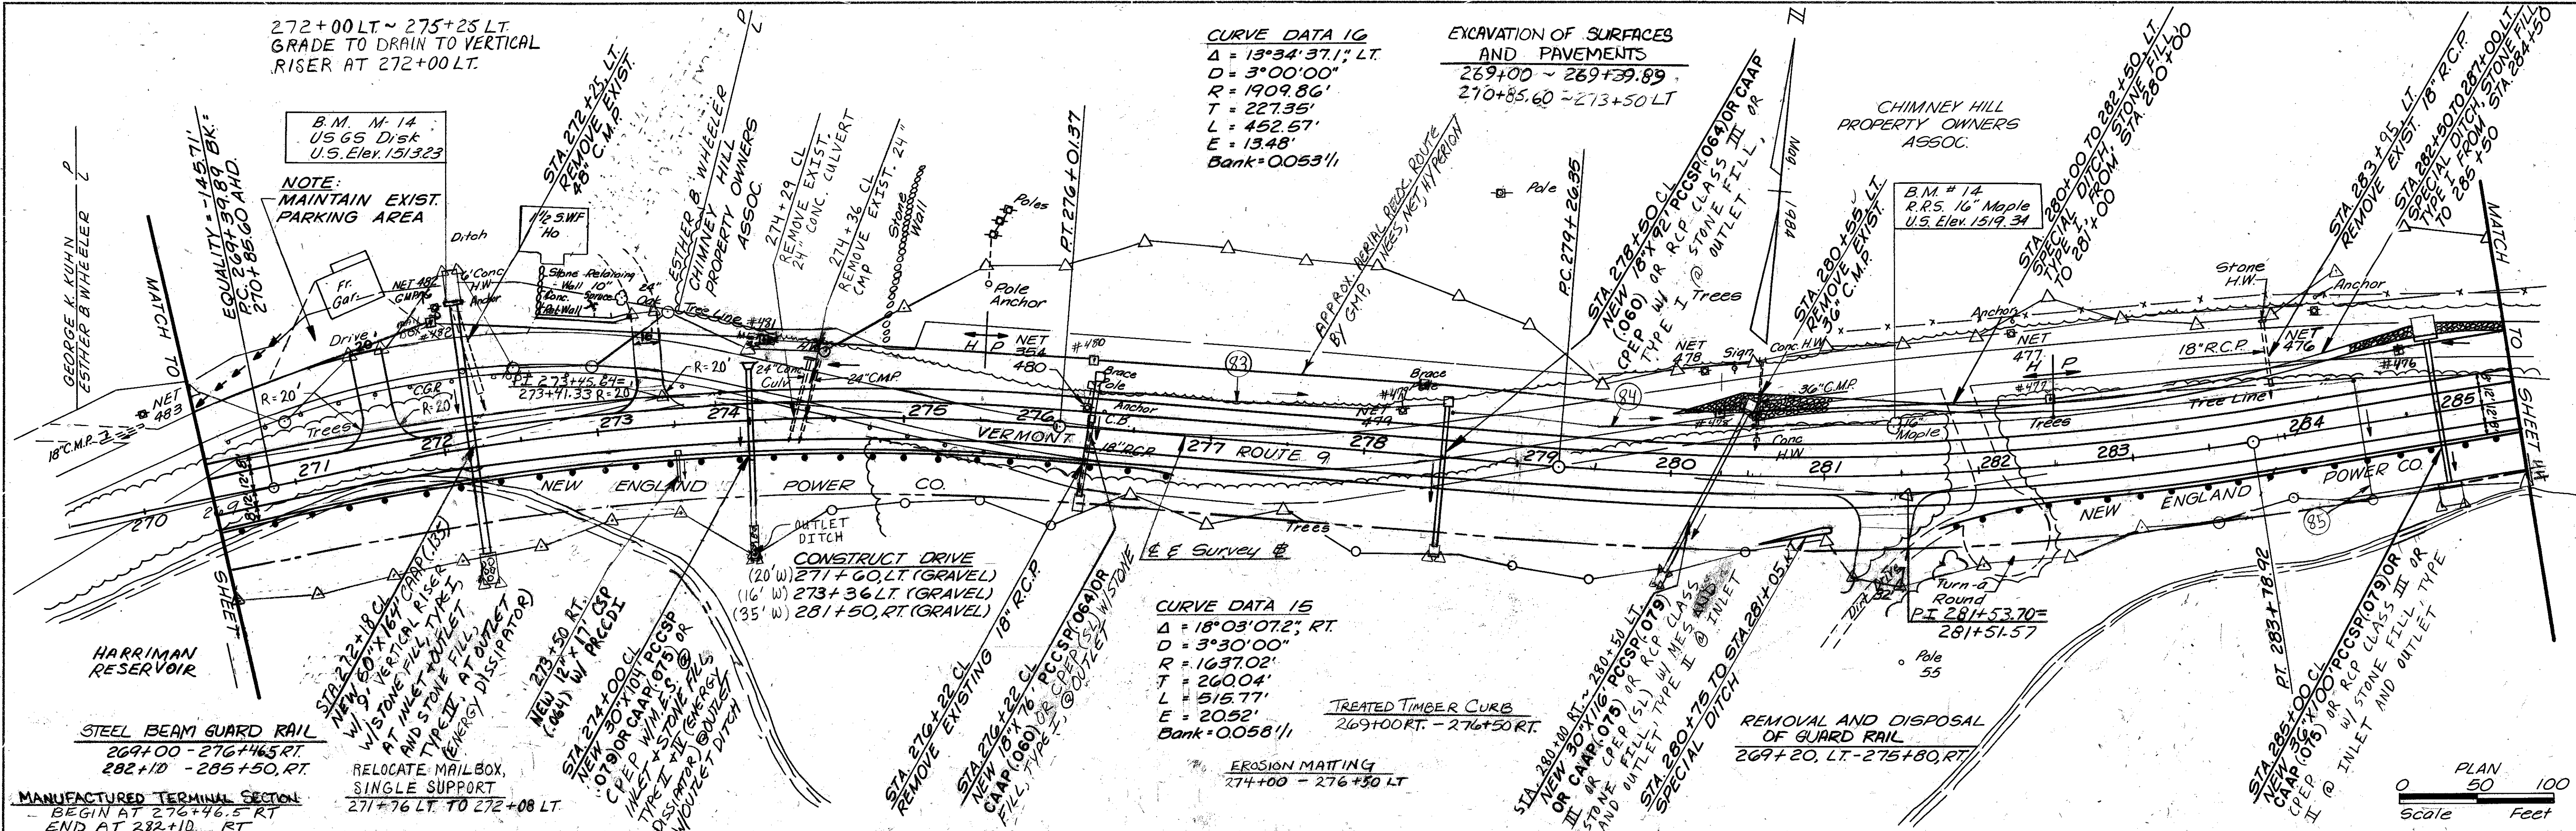

SEARSBURG - WILMINGTON
 FOIO - 1 (18)
 MAINLINE
 SHEET 79 OF 435