
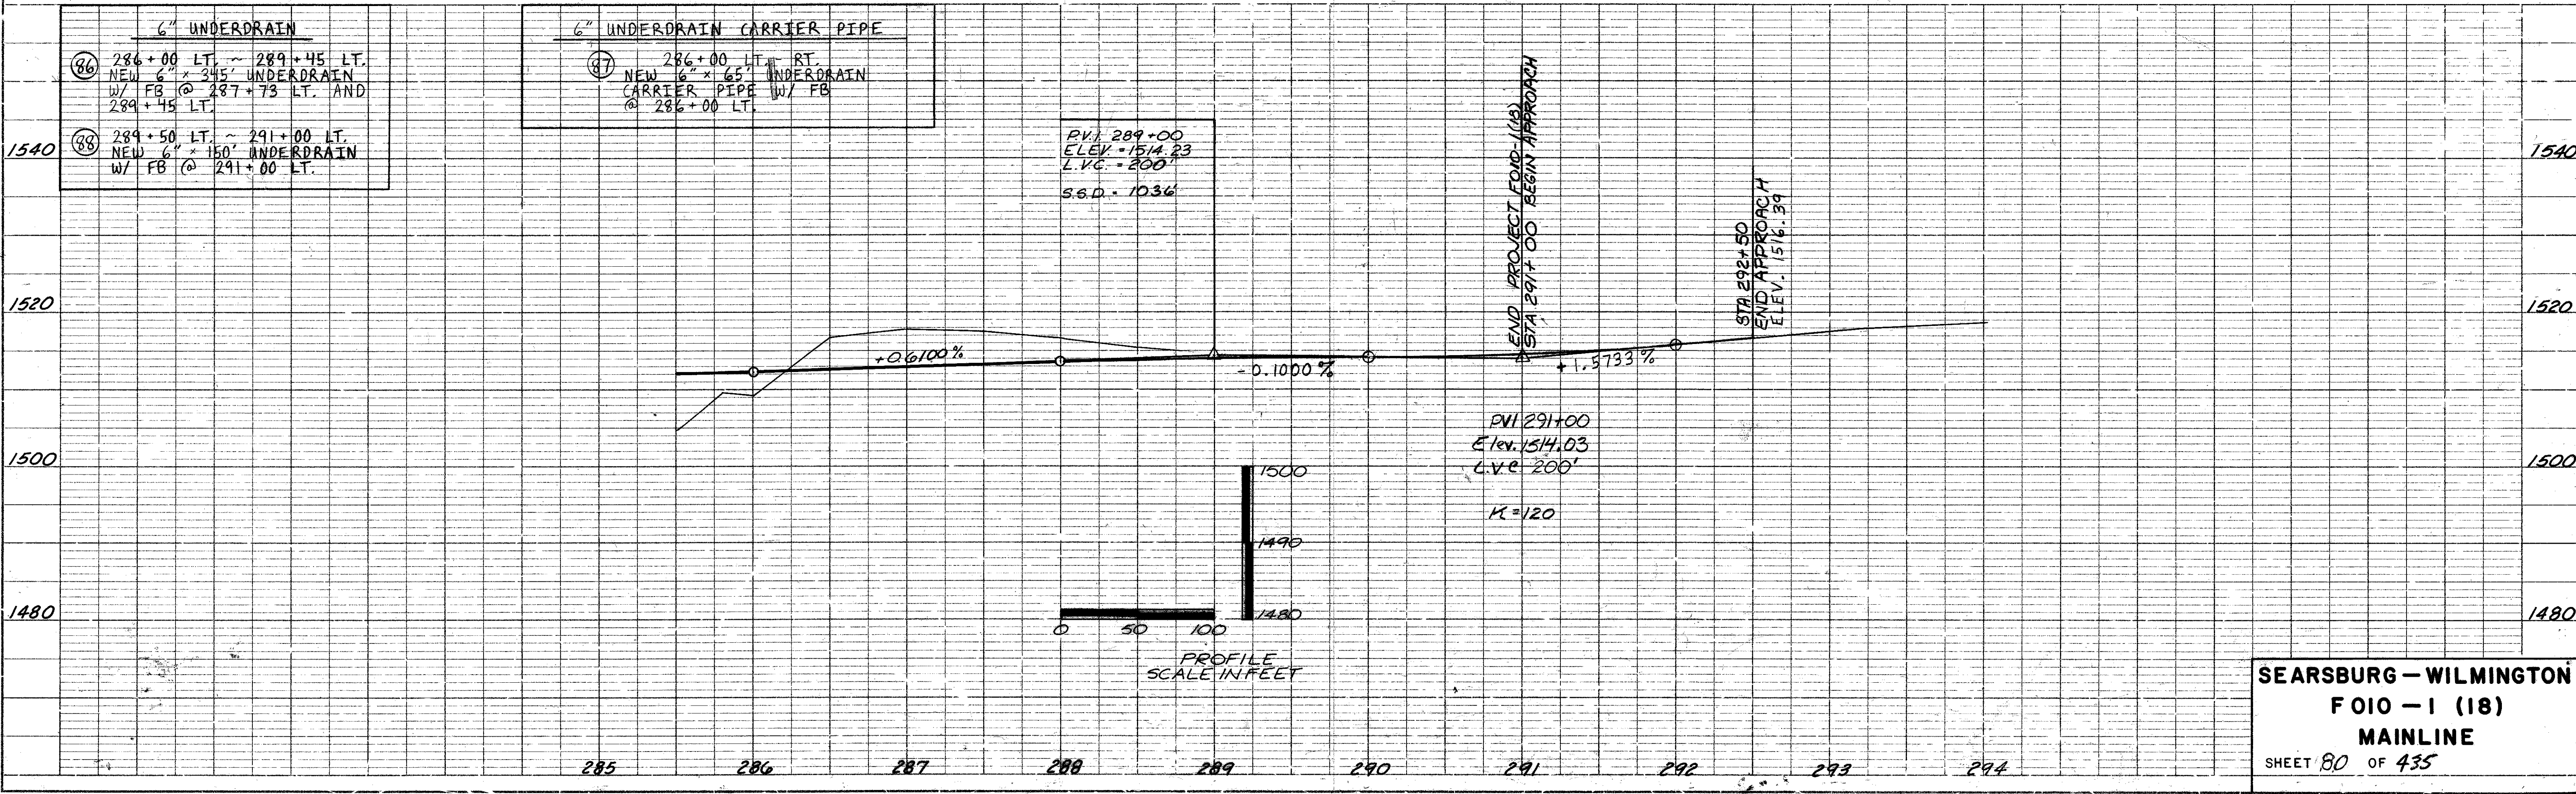
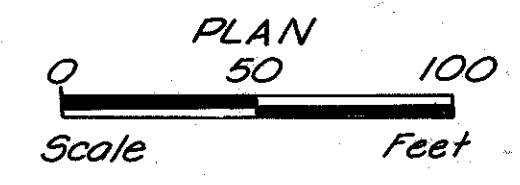


DATE: \_\_\_\_\_ BY: \_\_\_\_\_  
 SURVEYED: \_\_\_\_\_  
 NOTE BOOK: \_\_\_\_\_  
 ALIGNMENT CHECKED: \_\_\_\_\_  
 RT. OF WAY CHECKED: \_\_\_\_\_  
 No. \_\_\_\_\_

DATE: \_\_\_\_\_ BY: \_\_\_\_\_  
 SURVEYED: \_\_\_\_\_  
 NOTE BOOK: \_\_\_\_\_  
 GRADE CHECKED: \_\_\_\_\_  
 R. M. S. CHECKED: \_\_\_\_\_  
 PROPOSED ELEVATIONS CHECKED: \_\_\_\_\_  
 No. \_\_\_\_\_

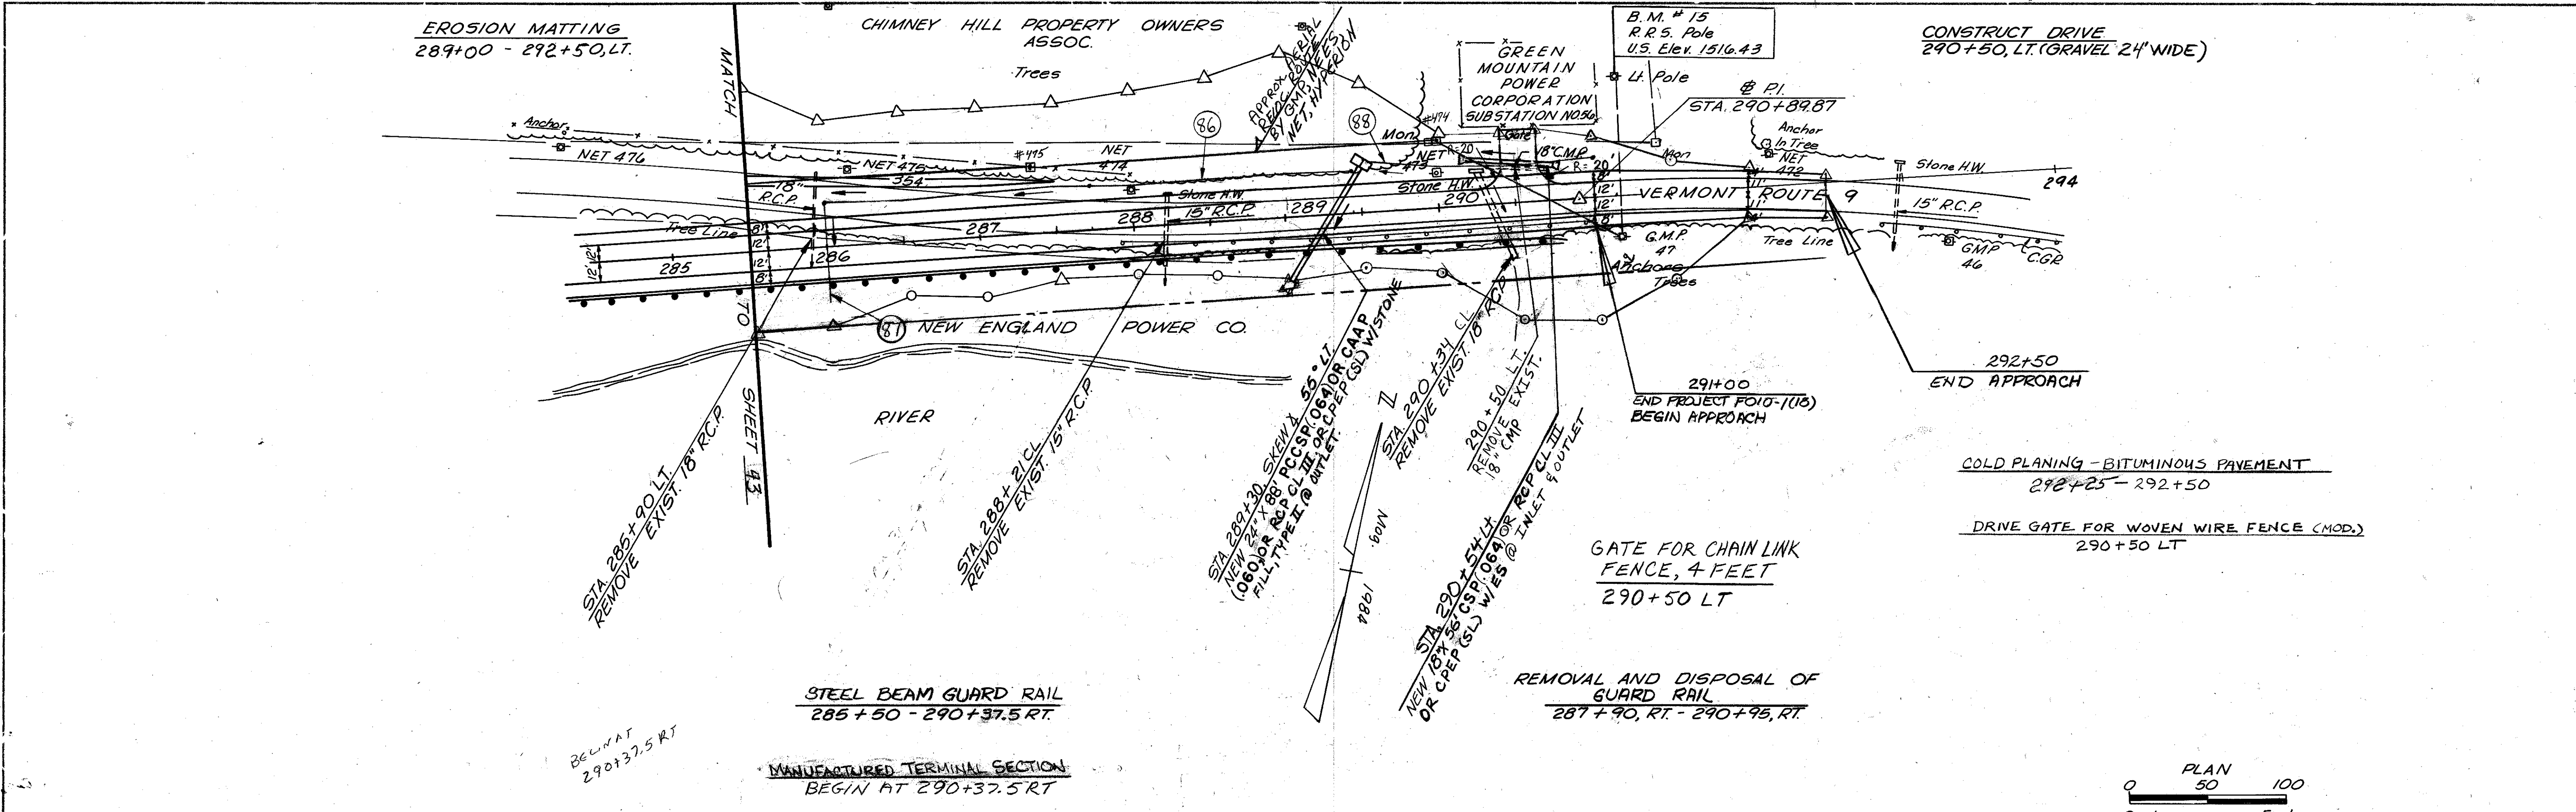

SEARSBURG - WILMINGTON  
 FOIO - 1 (18)  
 MAINLINE  
 SHEET 80 OF 435