



Mag. 1984

BEGIN PAVEMENT MARKINGS  
STA. 94+75

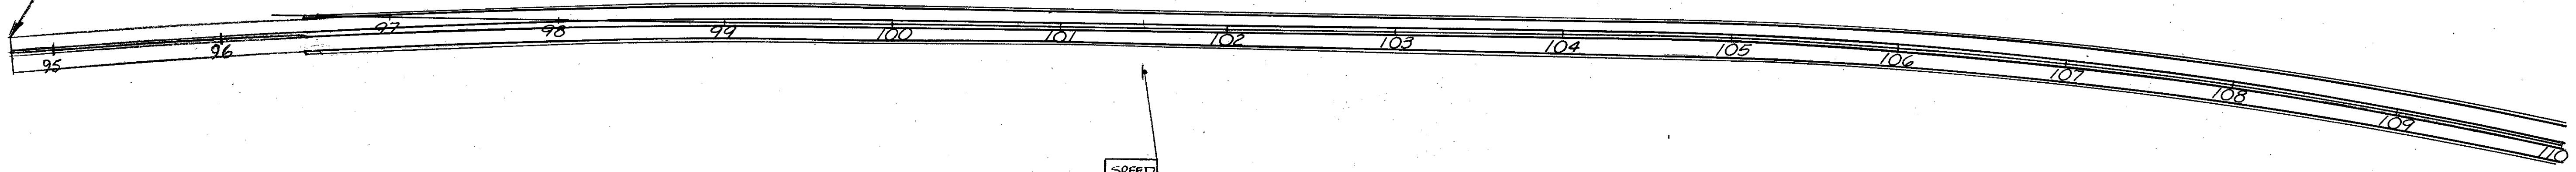

SPEED  
LIMIT  
50

STA. 101+50 RT.

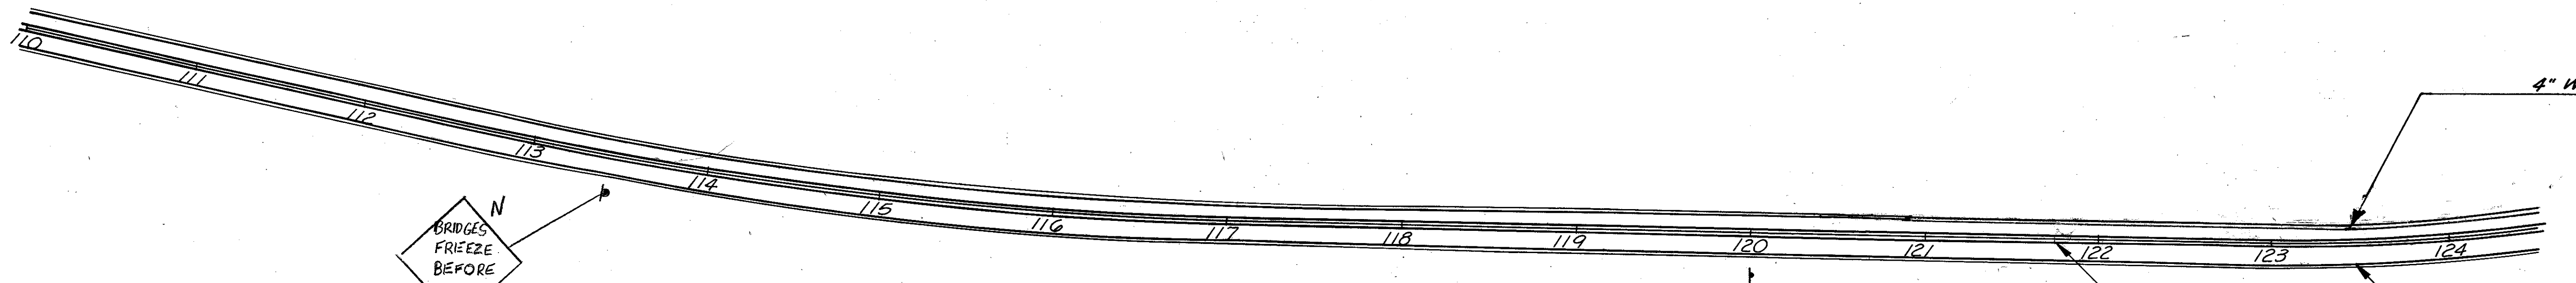

BRIDGES  
FRIEZE  
BEFORE  
ROAD

STA. 113+50 RT.

TEMPORARY 4" WHITE LINE  
STA. 94+75 Lt. - STA. 124+50 Lt.  
STA. 94+75 Rt. - STA. 124+50 Rt.

TEMPORARY 4" YELLOW LINE  
STA. 94+75 ♣ - STA. 124+50 ♣ (DOUBLE)

DURABLE 4" WHITE LINE  
STA. 94+75 Lt. - STA. 124+50 Lt.  
STA. 94+75 Rt. - STA. 124+50 Rt.

DURABLE 4" YELLOW LINE  
STA. 94+75 ♣ - STA. 124+50 ♣ (DOUBLE)

EAST  
VERMONT  
9

STA. 120+00 RT.

4" WHITE LINE  
4" YELLOW LINE  
4" WHITE LINE

**LEGEND**

- ◻ - EXISTING SIGN
  - ◻ - PROPOSED SIGN N-NEW
- NOT TO SCALE

<b>SEARSBURG - WILMINGTON</b> NHF 010-1 (18)		
<b>PAVEMENT MARKINGS AND SIGN LOCATIONS</b>		
McFARLAND-JOHNSON ENGINEERS, INC. BINGHAMTON NEW YORK		
SCALE NONE	DATE 11-85	SHEET 81 OF 435

IN CHARGE OF: \_\_\_\_\_  
 DESIGNED BY: \_\_\_\_\_  
 CHECKED BY: \_\_\_\_\_  
 DATE: \_\_\_\_\_