


EB PASSING ZONE CHANGED BY JOE KELLEY FROM STA. 227+50 TO STA. 228+50. (SIGHT DISTANCE)

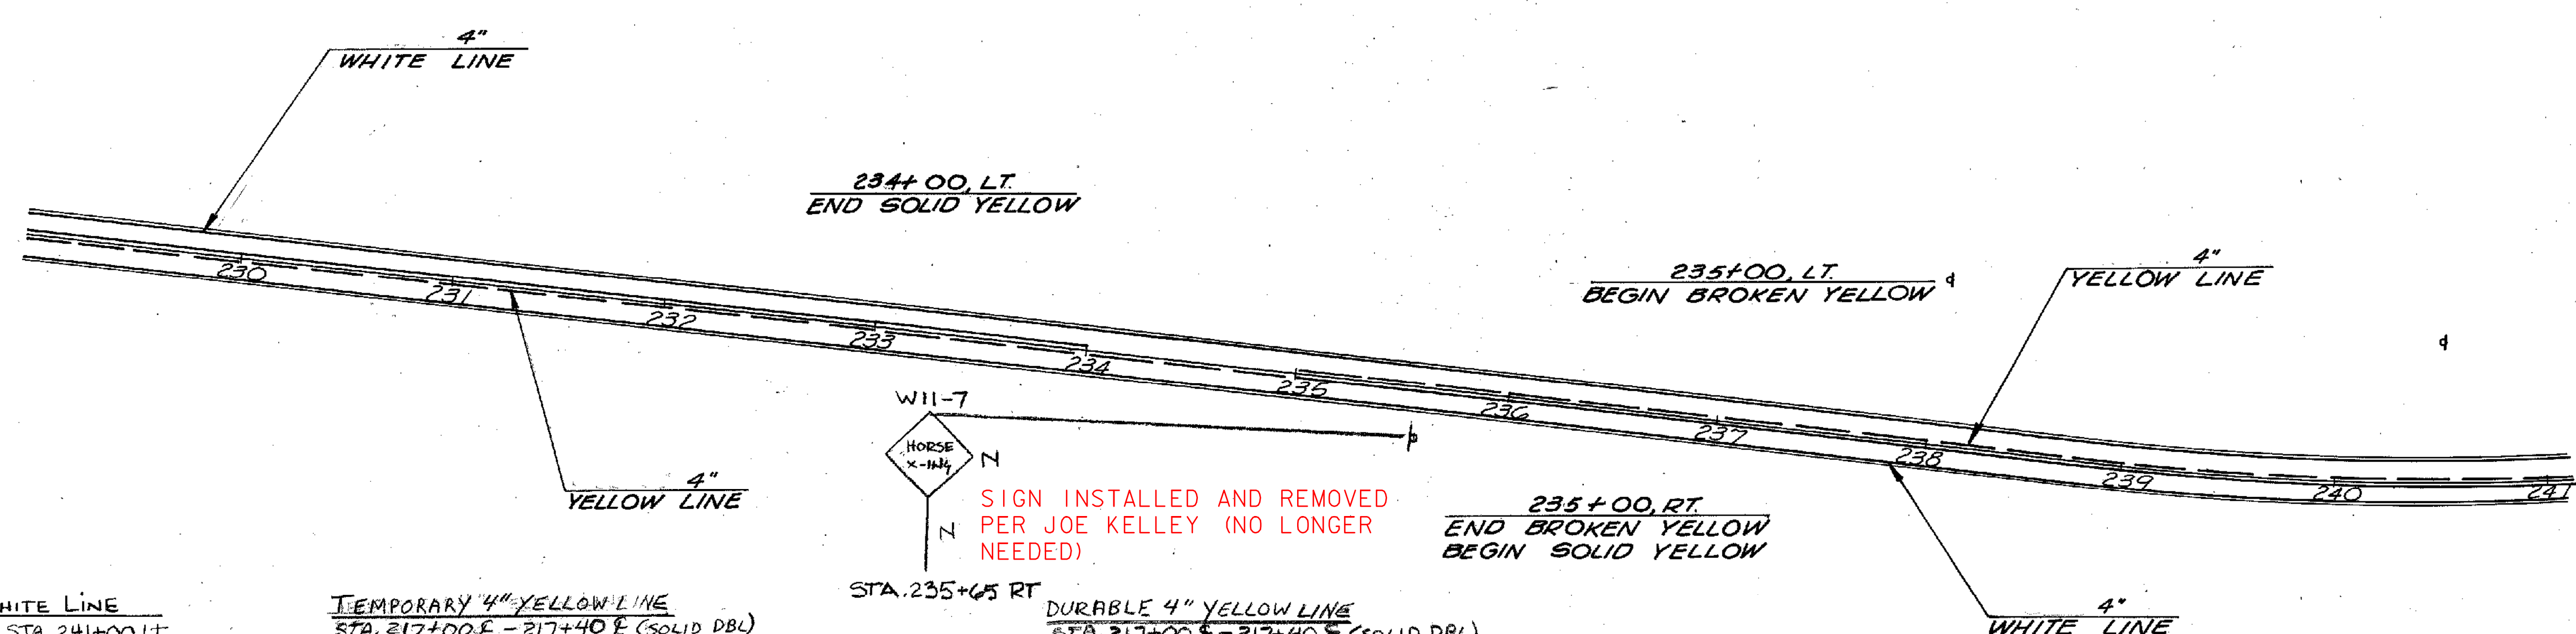

SIGN INSTALLED AND REMOVED PER JOE KELLEY (NO LONGER NEEDED)

TEMPORARY 4" WHITE LINE
 STA. 217+00 LT. - STA. 241+00 LT.
 STA. 217+00 RT. - STA. 217+20 RT.
 STA. 218+00 RT. - STA. 241+00 RT.

TEMPORARY 4" YELLOW LINE
 STA. 217+00 E - 217+40 E (SOLID DBL)
 STA. 217+80 E - 227+50 E (SOLID DBL) 228+50
 STA. 227+50 E - 234+00 E (SOLID LT, DASHED RT) 228+50
 STA. 234+00 E - 235+00 E (SINGLE DASHED)
 STA. 235+00 E - 241+00 E (DASHED LT, SOLID RT)
 T.H. 31 20+20 E - 20+60 E (SOLID, DBL)

DURABLE 4" WHITE LINE
 STA. 217+00 LT. - STA. 241+00 LT.
 STA. 217+00 RT. - STA. 20+60 RT. (TH-31)
 STA. 20+60 LT. (TH-31) - STA. 241+00 RT.

DURABLE 4" YELLOW LINE
 STA. 217+00 E - 217+40 E (SOLID DBL)
 STA. 217+80 E - 227+50 E (SOLID DBL) 228+50
 STA. 227+50 E - 234+00 E (SOLID LT, DASHED RT) 228+50
 STA. 234+00 E - 235+00 E (SINGLE DASHED)
 STA. 235+00 E - 241+00 E (DASHED LT, SOLID RT)
 TH 31 STA. 20+20 E - 20+60 E (DBL)

DURABLE LETTER OR SYMBOL
 STA. 20+30 LT. (TH-31) 4 EA ("STOP")

DURABLE 24" STOP BAR
 STA. 20+20 LT. (TH-31)

TEMPORARY 24" STOP BAR
 T.H. 31 20+20 LT

TEMPORARY LETTER OR SYMBOL
 4 EA T.H. 31 20+30 LT ("STOP")

LEGEND

- 4 - EXISTING SIGN
- 4 - PROPOSED SIGN
- N-NEW
- NOT TO SCALE

SEARSBURG - WILMINGTON NH F 010-1 (18)		
PAVEMENT MARKINGS AND SIGN LOCATIONS		
McFARLAND-JOHNSON ENGINEERS, INC. BINGHAMTON NEW YORK		
SCALE NONE	DATE 11-85	SHEET 85 OF 435

IN CHARGE OF: DESIGNED BY: CHECKED BY: