


**KEY:**  
 NF = NEAR FACE  
 FF = FAR FACE  
 EF = EACH FACE  
 ▲ = CUT TO FIT IN FIELD  
 3" CLR. UNLESS OTHERWISE SPECIFIED ON THE PLANS.

**ABUTMENT 2 REINFORCING PLAN - BR 25**

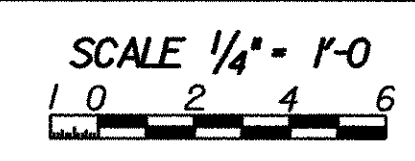

SHEET NAME: <b>ABUT 2 FOOTING REINFORCING PLAN</b>	
PROJECT NAME: <b>SEARSBURG</b>	HIGHWAY NO.: <b>ROUTE 9</b>
PROJECT NUMBER: <b>NH F 010-1(18)</b>	BRIDGE NO.: <b>25</b>
	OVER: <b>THE DEERFIELD RIVER</b>
FILE NAME: /str4/78d096/25 ab2elernf.dgn	PLOT DATE: <b>16-JAN-2003</b>
PROJECT MANAGER: <b>R.WHITCOMB</b>	DRAWN BY: <b>J.GILMORE</b>
DESIGNED BY: <b>CH&amp;A LLP</b>	IPARM NAME: <b>br228</b>
BRIDGE SHEET NUMBER: <b>BR228</b>	SHEET <b>154 OF 435</b>