


B TOP OF BACKWALL REINFORCING PLAN - BR 25

BR230


SCALE 3/8" = 1'-0"
 1 0 1 2 3 4

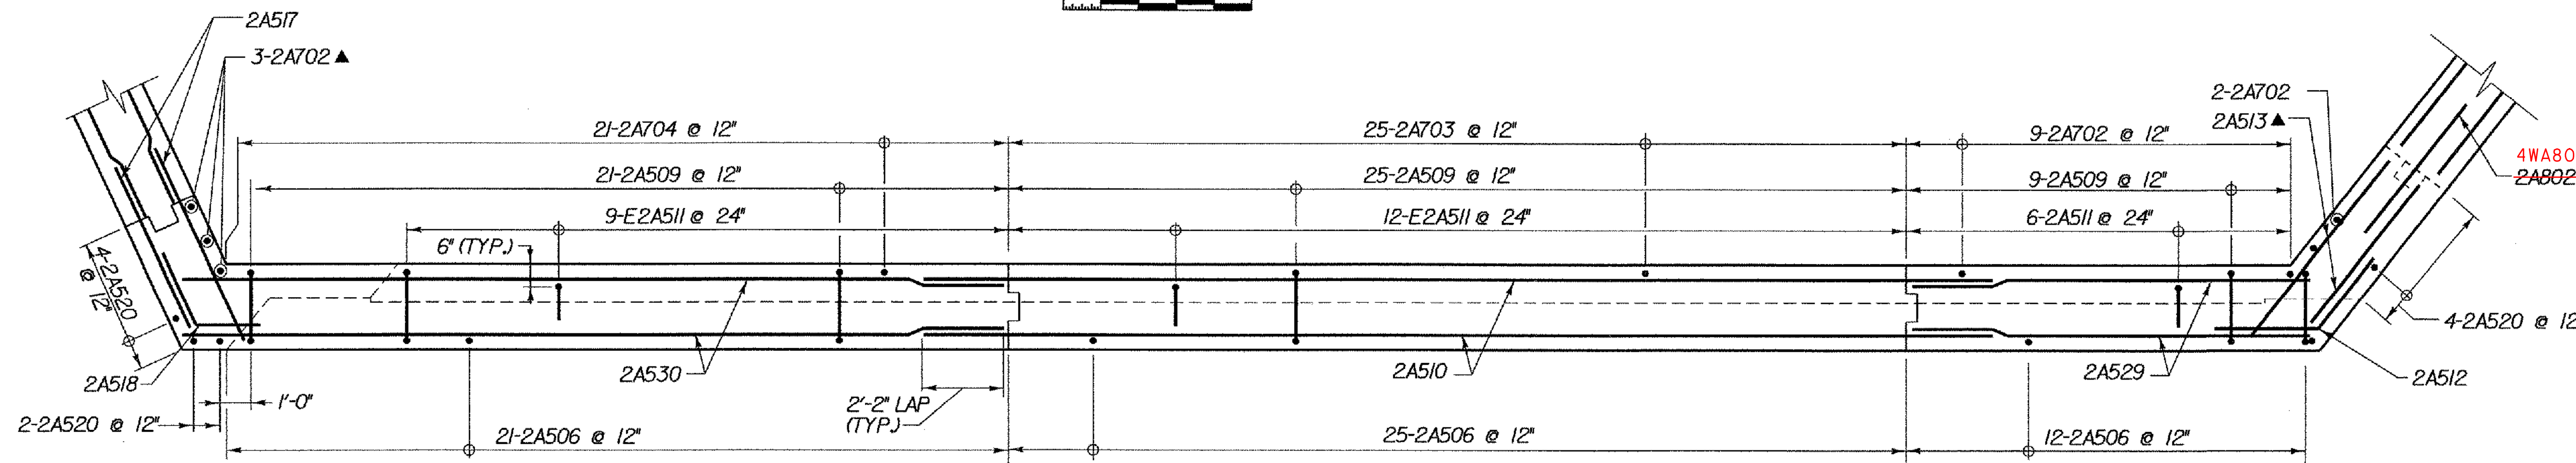

C BACKWALL REINFORCING PLAN - BR 25

BR230


SCALE 3/8" = 1'-0"
 1 0 1 2 3 4

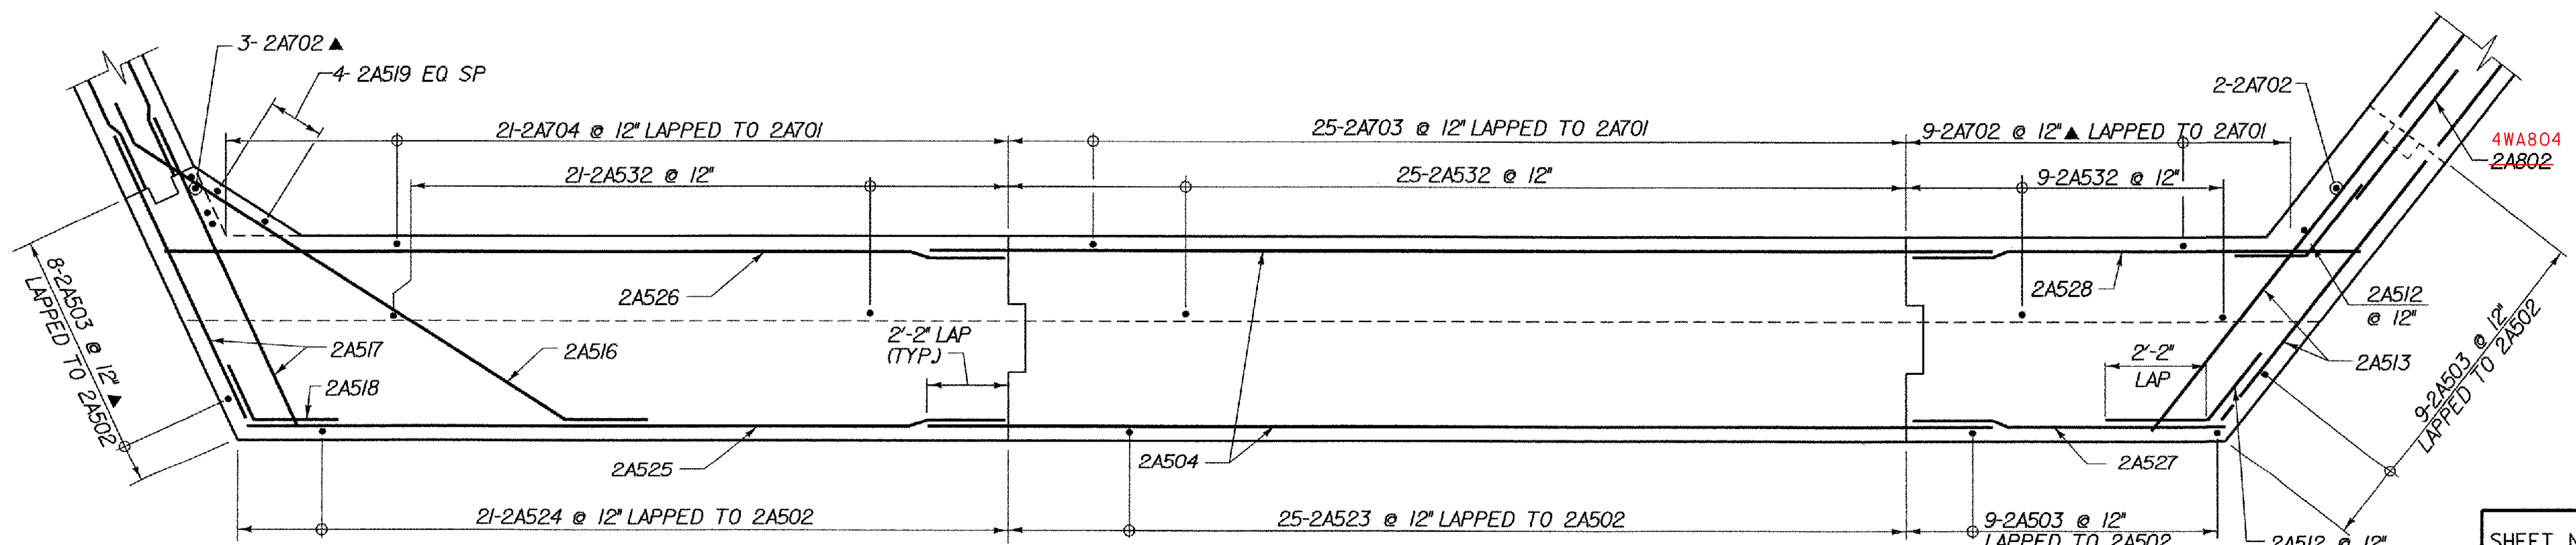

D STEM REINFORCING PLAN - BR 25

BR230

SCALE 3/8" = 1'-0"
 1 0 1 2 3 4

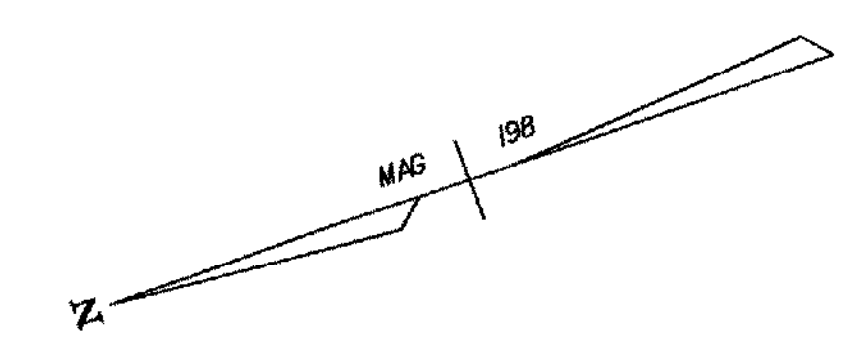

KEY:
 NF = NEAR FACE
 FF = FAR FACE
 EF = EACH FACE
 ▲ = CUT TO FIT IN FIELD
 3" CLR. UNLESS OTHERWISE SPECIFIED ON THE PLANS.

SHEET NAME: ABUTMENT 2 REINFORCING - 2	
PROJECT NAME: SEARSBURG	HIGHWAY NO.: ROUTE 9
PROJECT NUMBER: NH F 010-(18)	BRIDGE NO.: 25
	OVER: THE DEERFIELD RIVER
FILE NAME: /str4/78d096/25 ab2elernf.dgn	PLOT DATE: 16-JAN-2003
PROJECT MANAGER: R.WHITCOMB	DRAWN BY: J.GILMORE
DESIGNED BY: CH&A LLP	IPARM NAME: br229
BRIDGE SHEET NUMBER: BR229	SHEET 155 OF 435