

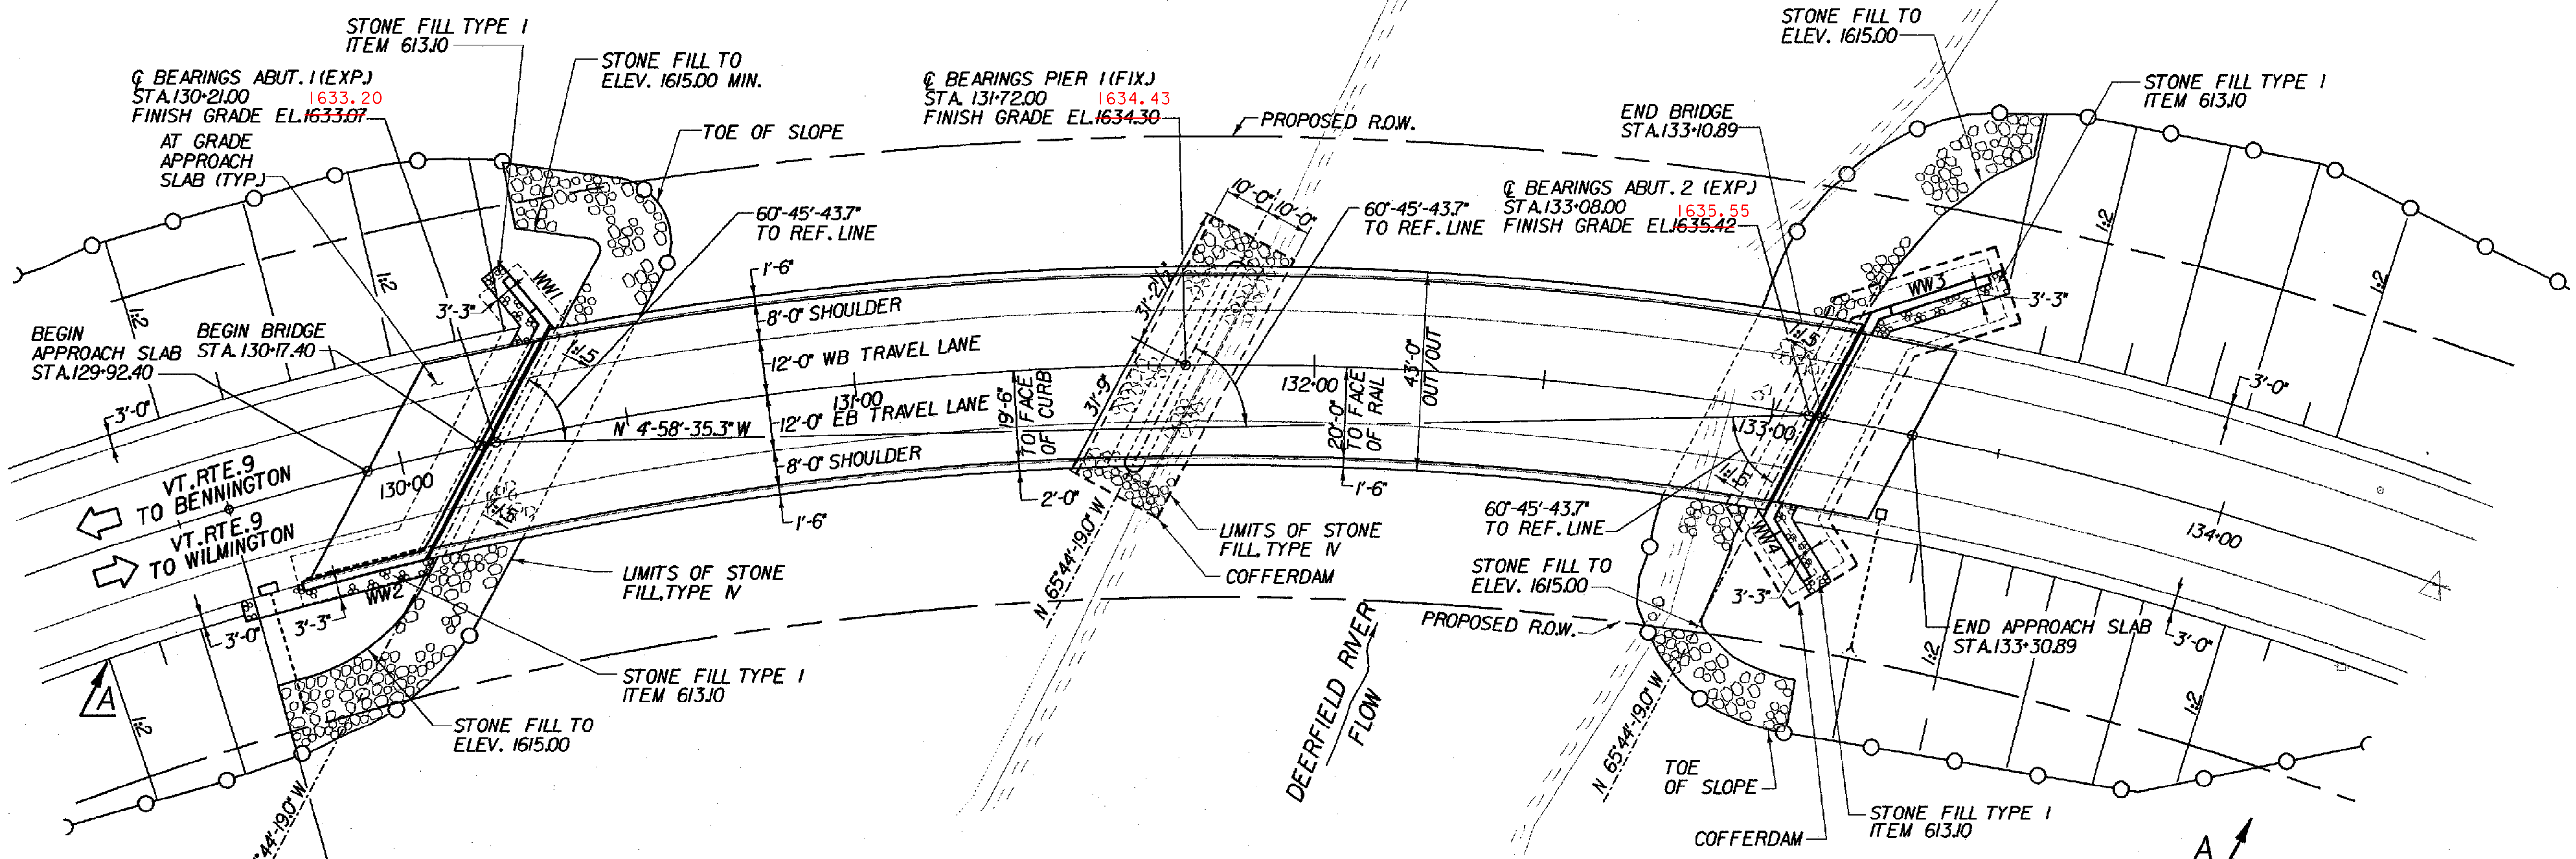
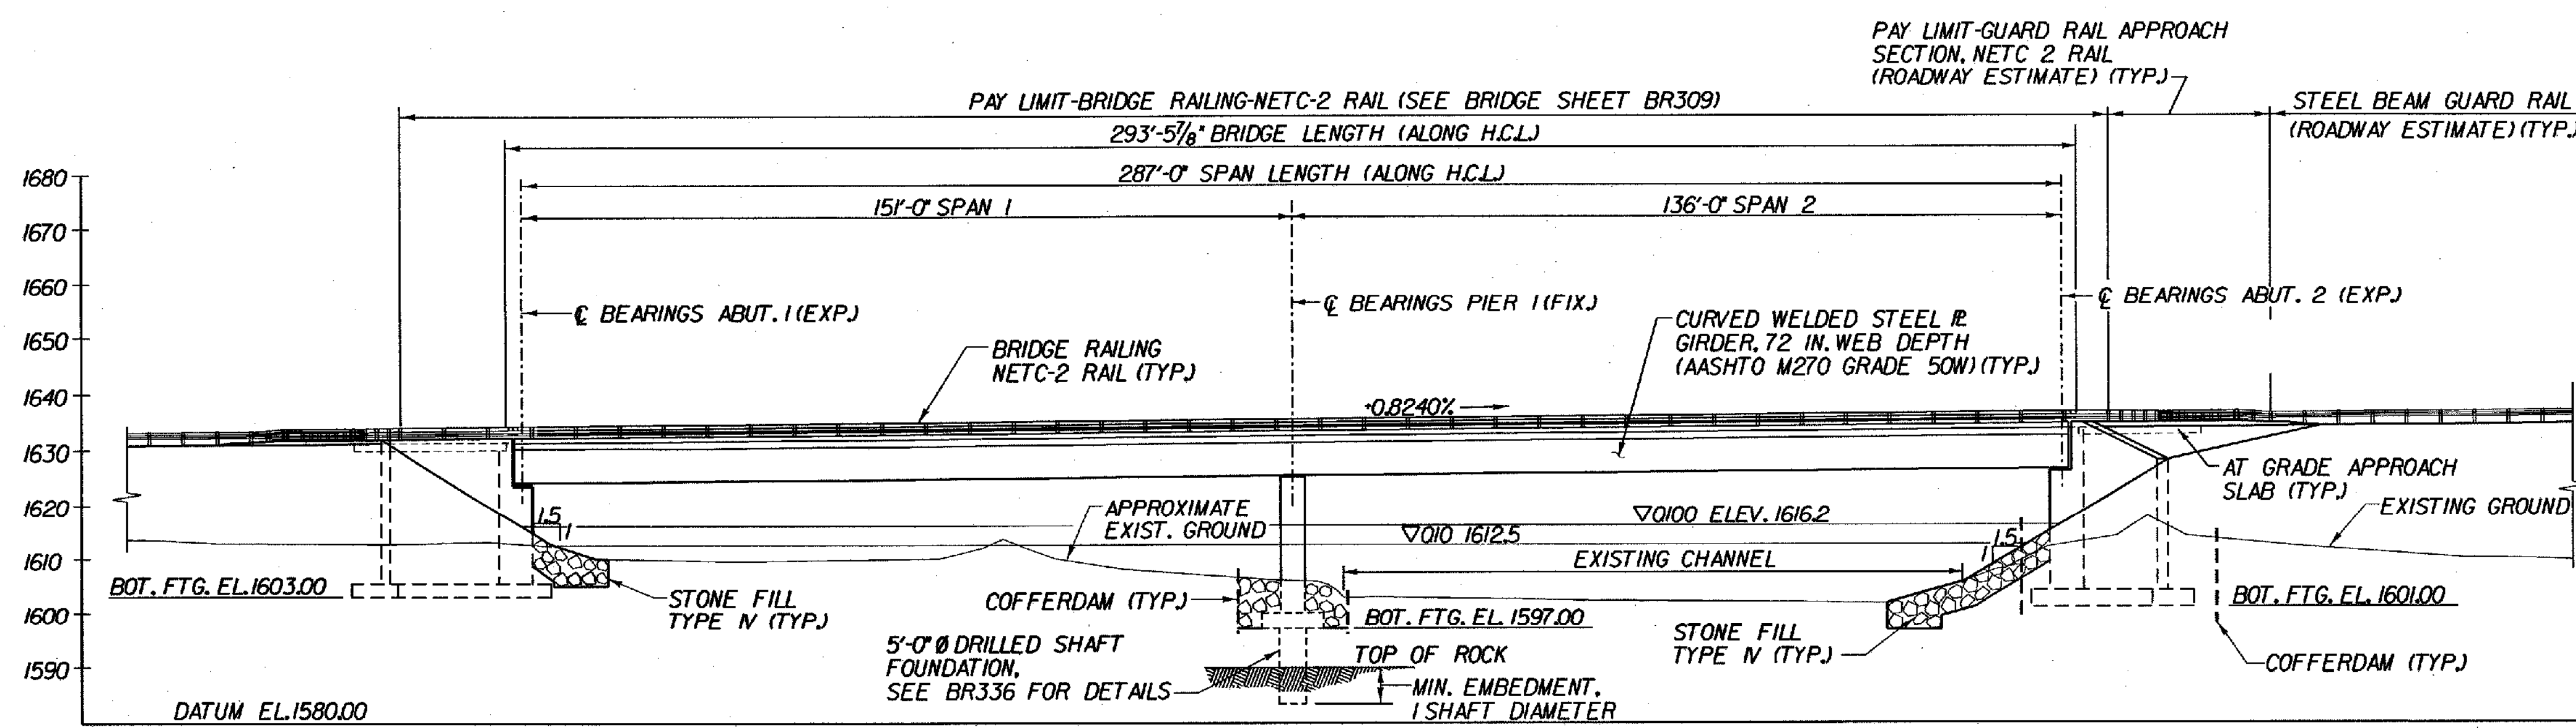



CURVE DATA	
REV P.C.	- STA. 127+03.130
REV P.T.	- STA. 134+48.830
Δ	- 55°-55'-38.86" RT
R	- 763.94'
Dc	- 7'-30"
L	- 745.70'
T	- 405.58'
E	- 100.99'
BANK	- 0.0800 FT/FT

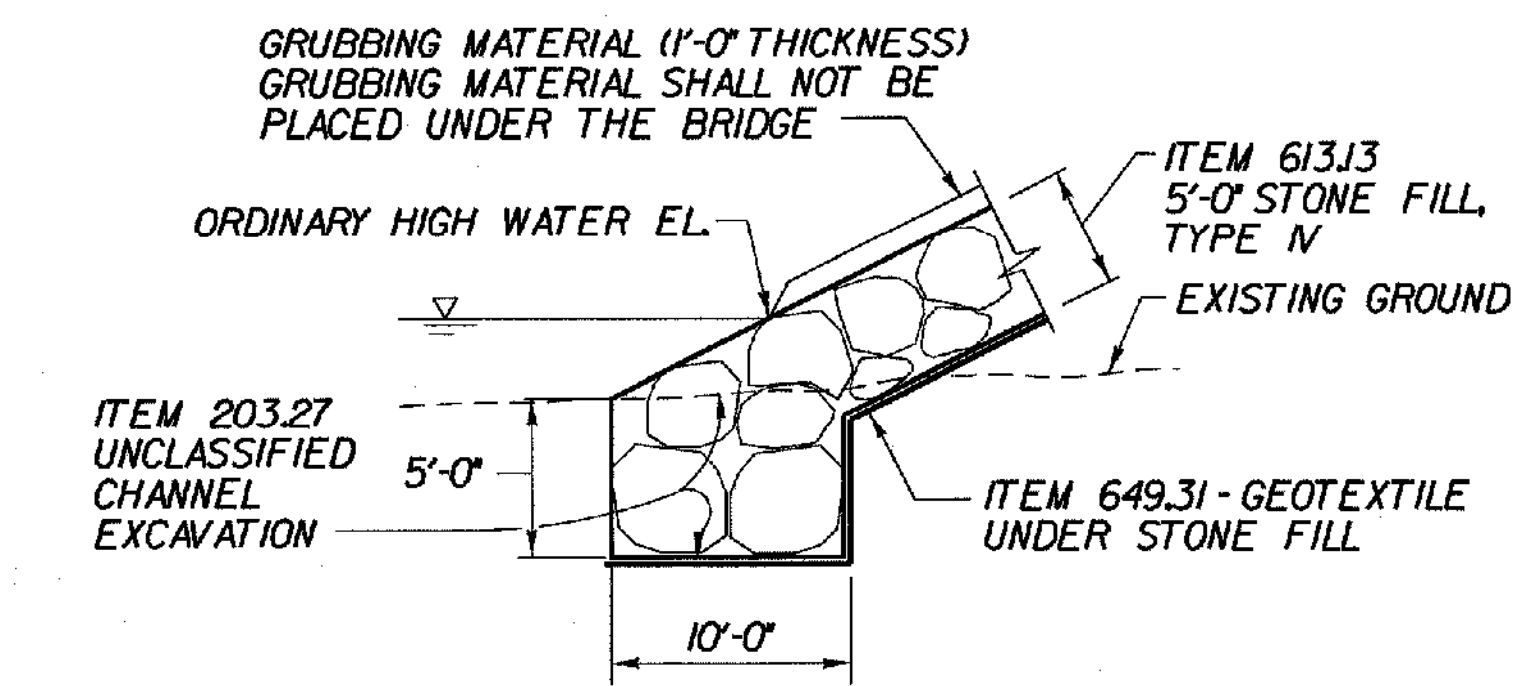

PLAN - BR 25A

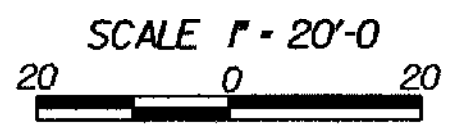

ELEVATION A-A - BR 25A

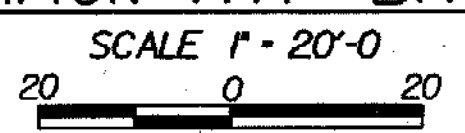

STATE OF VERMONT AGENCY OF TRANSPORTATION			
Town Of	SEARSBURG	Bridge No.	25A
Highway No.	VT. RTE. 9	Log Sta.	
		Surv. Sta.	
VT. RTE. 9 OVER DEERFIELD RIVER			
PLAN AND ELEVATION - BR 25A			
Designed By	D. VIENI	Drawn by	K. DETRICK / Wm WEATHERBY
Checked By	M. OLSTAD	Date	2/2002
		Bridge Design Supervisor	M. OLSTAD
		Date	2/2002
PROJECT	SEARSBURG - WILMINGTON	PROJECT NO.	NHF 010-K18)
I.C.C. Info.		Bridge Sheet No. BR300	

