


PROFILE - VT. RTE. 9 OVER DEERFIELD RIVER - BR 25A

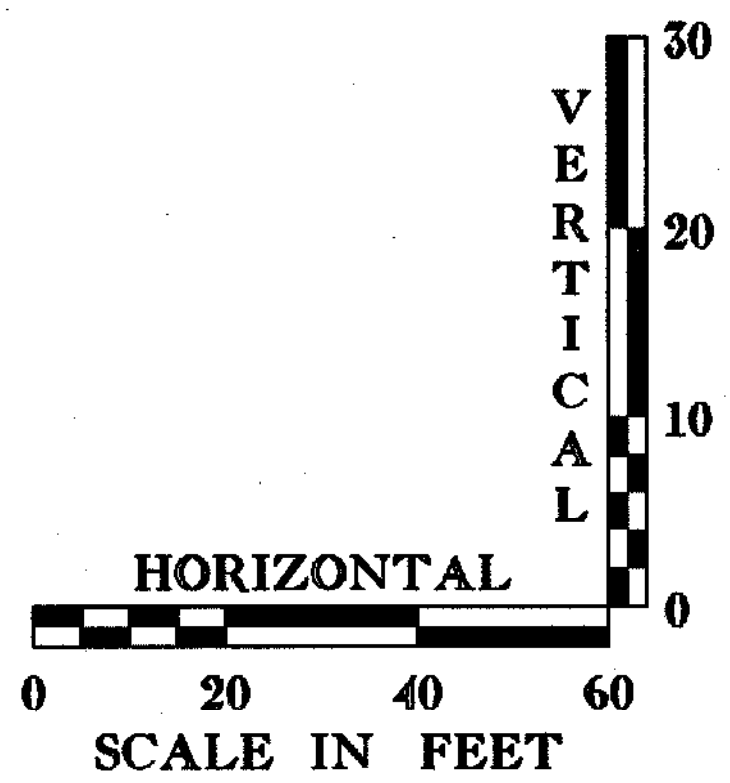

DECK HAUNCHES RAISED TO MAINTAIN MINIMUM HAUNCH. RESULTED IN A FINISH GRADE INCREASE OF 0.13 FT.

STATE OF VERMONT AGENCY OF TRANSPORTATION			
Town Of	SEARSBURG	Bridge No.	25A
Highway No.	VT. RTE. 9	Log Sta.	
		Surv. Sta.	
VT. RTE. 9 OVER DEERFIELD RIVER			
PROFILE - BR 25A			
Designed By	D. VIEN	Drawn by	K. DETRICK
Checked By	M. OLSTAD	Bridge Design Supervisor	M. OLSTAD
	Date 2/2002	Date	2/2002
PROJECT	SEARSBURG - WILMINGTON	PROJECT NO.	NHF 010-K18)
I.G.C. Info.		Bridge Sheet No. BR303	
		Sheet 168 of 435	

CHA CLOUGH, HARBOUR & ASSOCIATES LLP
ENGINEERS, SURVEYORS, PLANNERS & LANDSCAPE ARCHITECTS
WINNERS: OPOLÉ ALBANY, NEW YORK, 1999

FILE NAME: \\s1755\mstn\15\BR0625A\25a.prf.1.e.dgn
DATE/TIME: 02/20/02
USER: 2223