



ABUTMENT I PLAN - BR 25A

SCALE 1/4" = 1'-0"  
 1 0 2 4 6

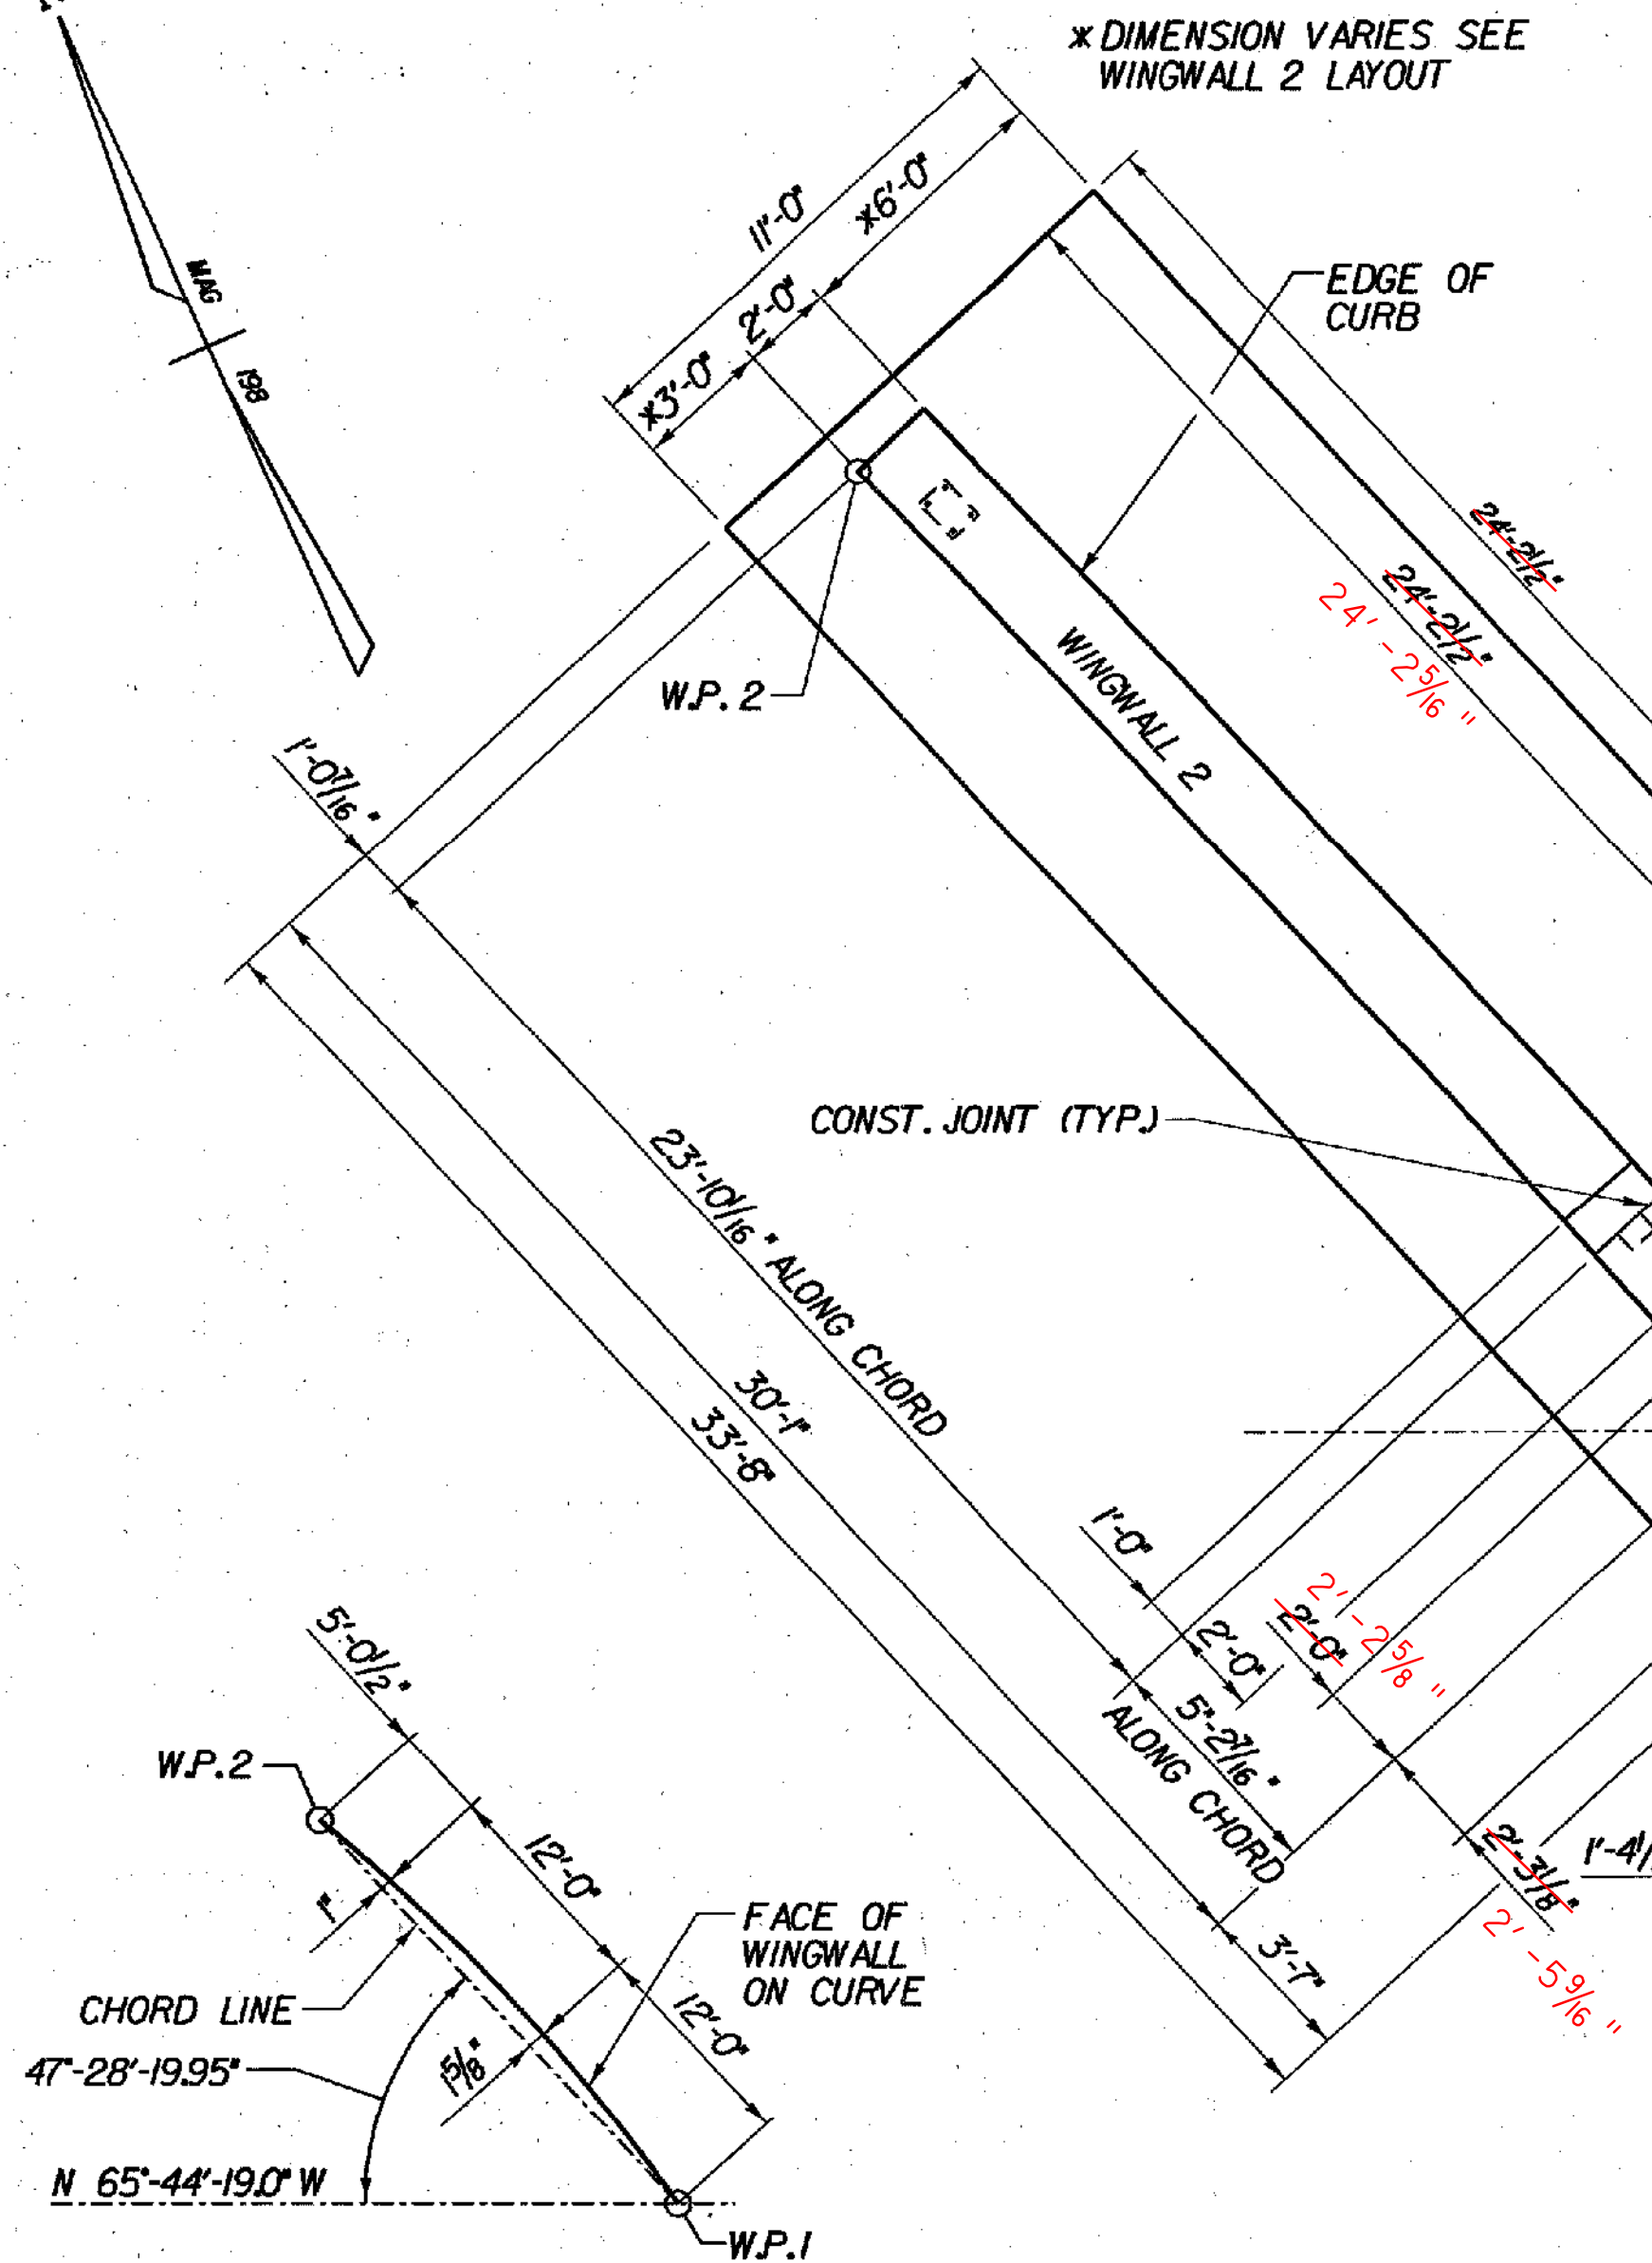

WINGWALL 2 LAYOUT

N.T.S.

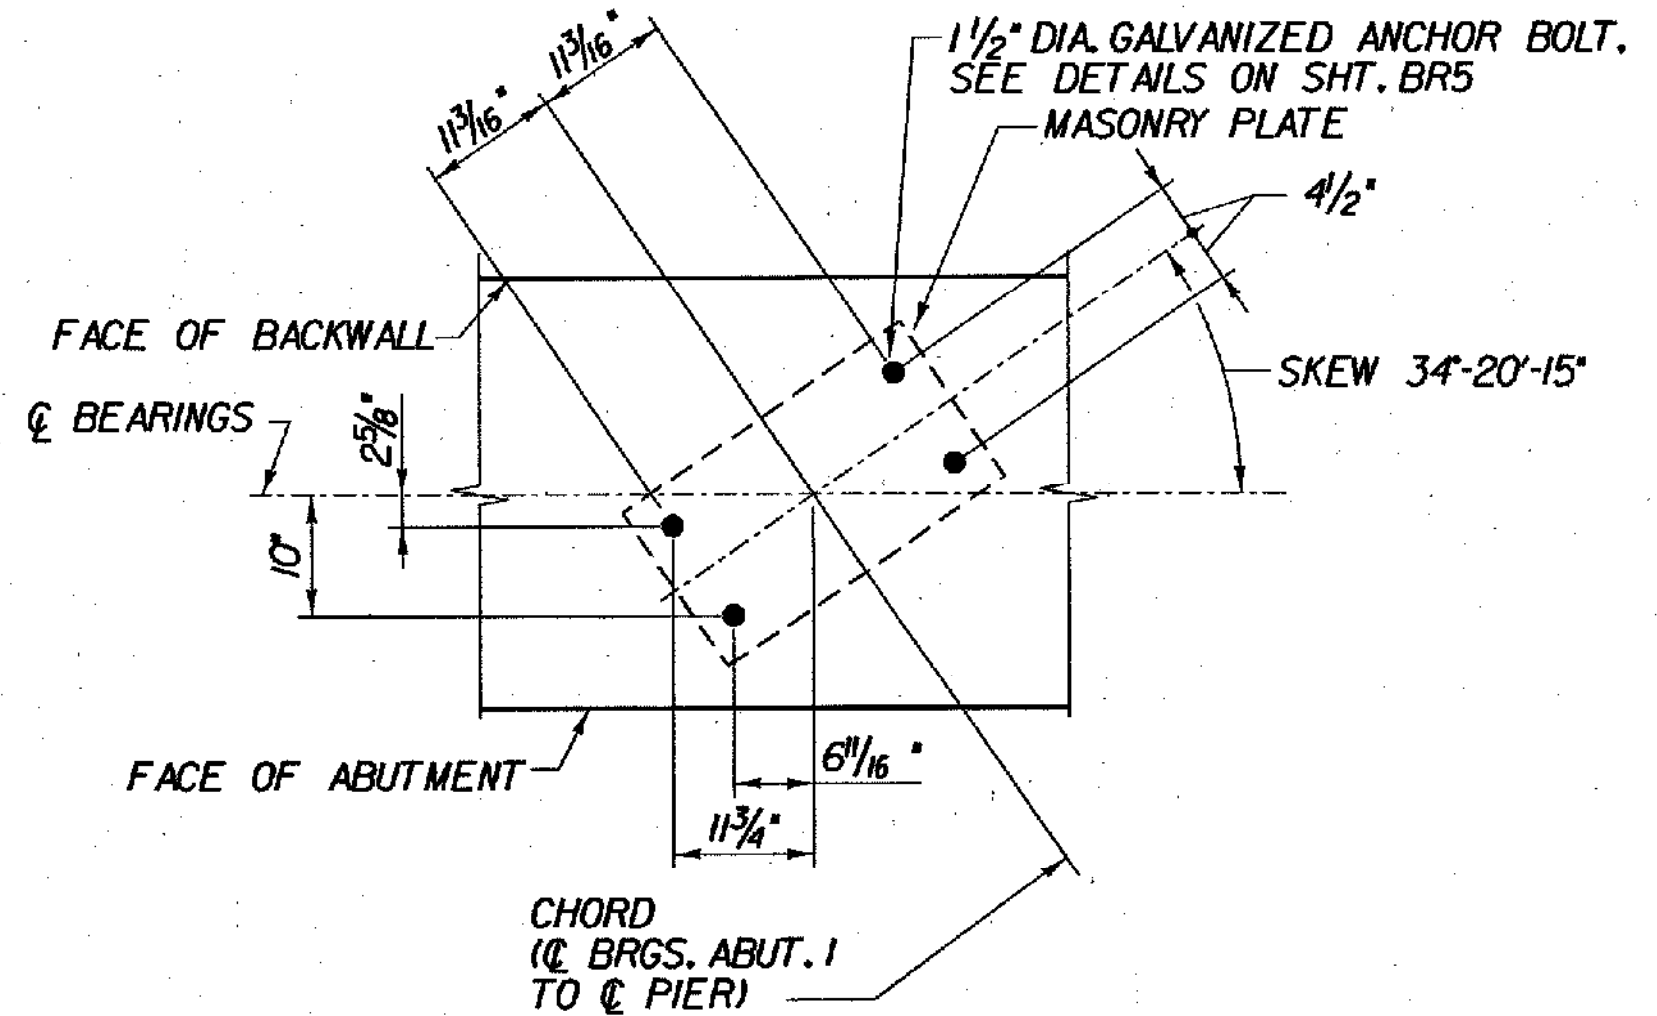

PLAN-ANCHOR BOLT LAYOUT-ABUTMENT I - BR 25A

SCALE 3/4" = 1'-0"  
 1 0 2

- NOTE:**
1. FOR BEARING DETAILS SEE BRIDGE SHEET BR6 AND BR7.
  2. FOR CONSTRUCTION JOINT DETAILS SEE BRIDGE SHEET BR15.

**STATE OF VERMONT  
 AGENCY OF TRANSPORTATION**

Town Of	SEARSBURG	Bridge No.	25A
Highway No.	VT. RTE. 9	Log Sta.	
		Surv. Sta.	
VT. RTE. 9 OVER DEERFIELD RIVER			
ABUTMENT I PLAN - BR 25A			
Designed By	D. VIEN	Drawn by	K. DETRICK/Wm WEATHERBY
Checked By	M. OLSTAD	Bridge Design Supervisor	M. OLSTAD
Date	2/2002	Date	2/2002
PROJECT	SEARSBURG - WILMINGTON	PROJECT NO.	NHF 010-118
L.C.C. Info.		Bridge Sheet No. BR320	

**CHA CLOUGH, HARBOUR & ASSOCIATES LLP**  
 ENGINEERS, SURVEYORS, PLANNERS & LANDSCAPE ARCHITECTS  
 11 WINNERS CIRCLE ALBANY, NEW YORK, 12208