



BRIDGE SEAT #3 ACTUAL: 1625.06

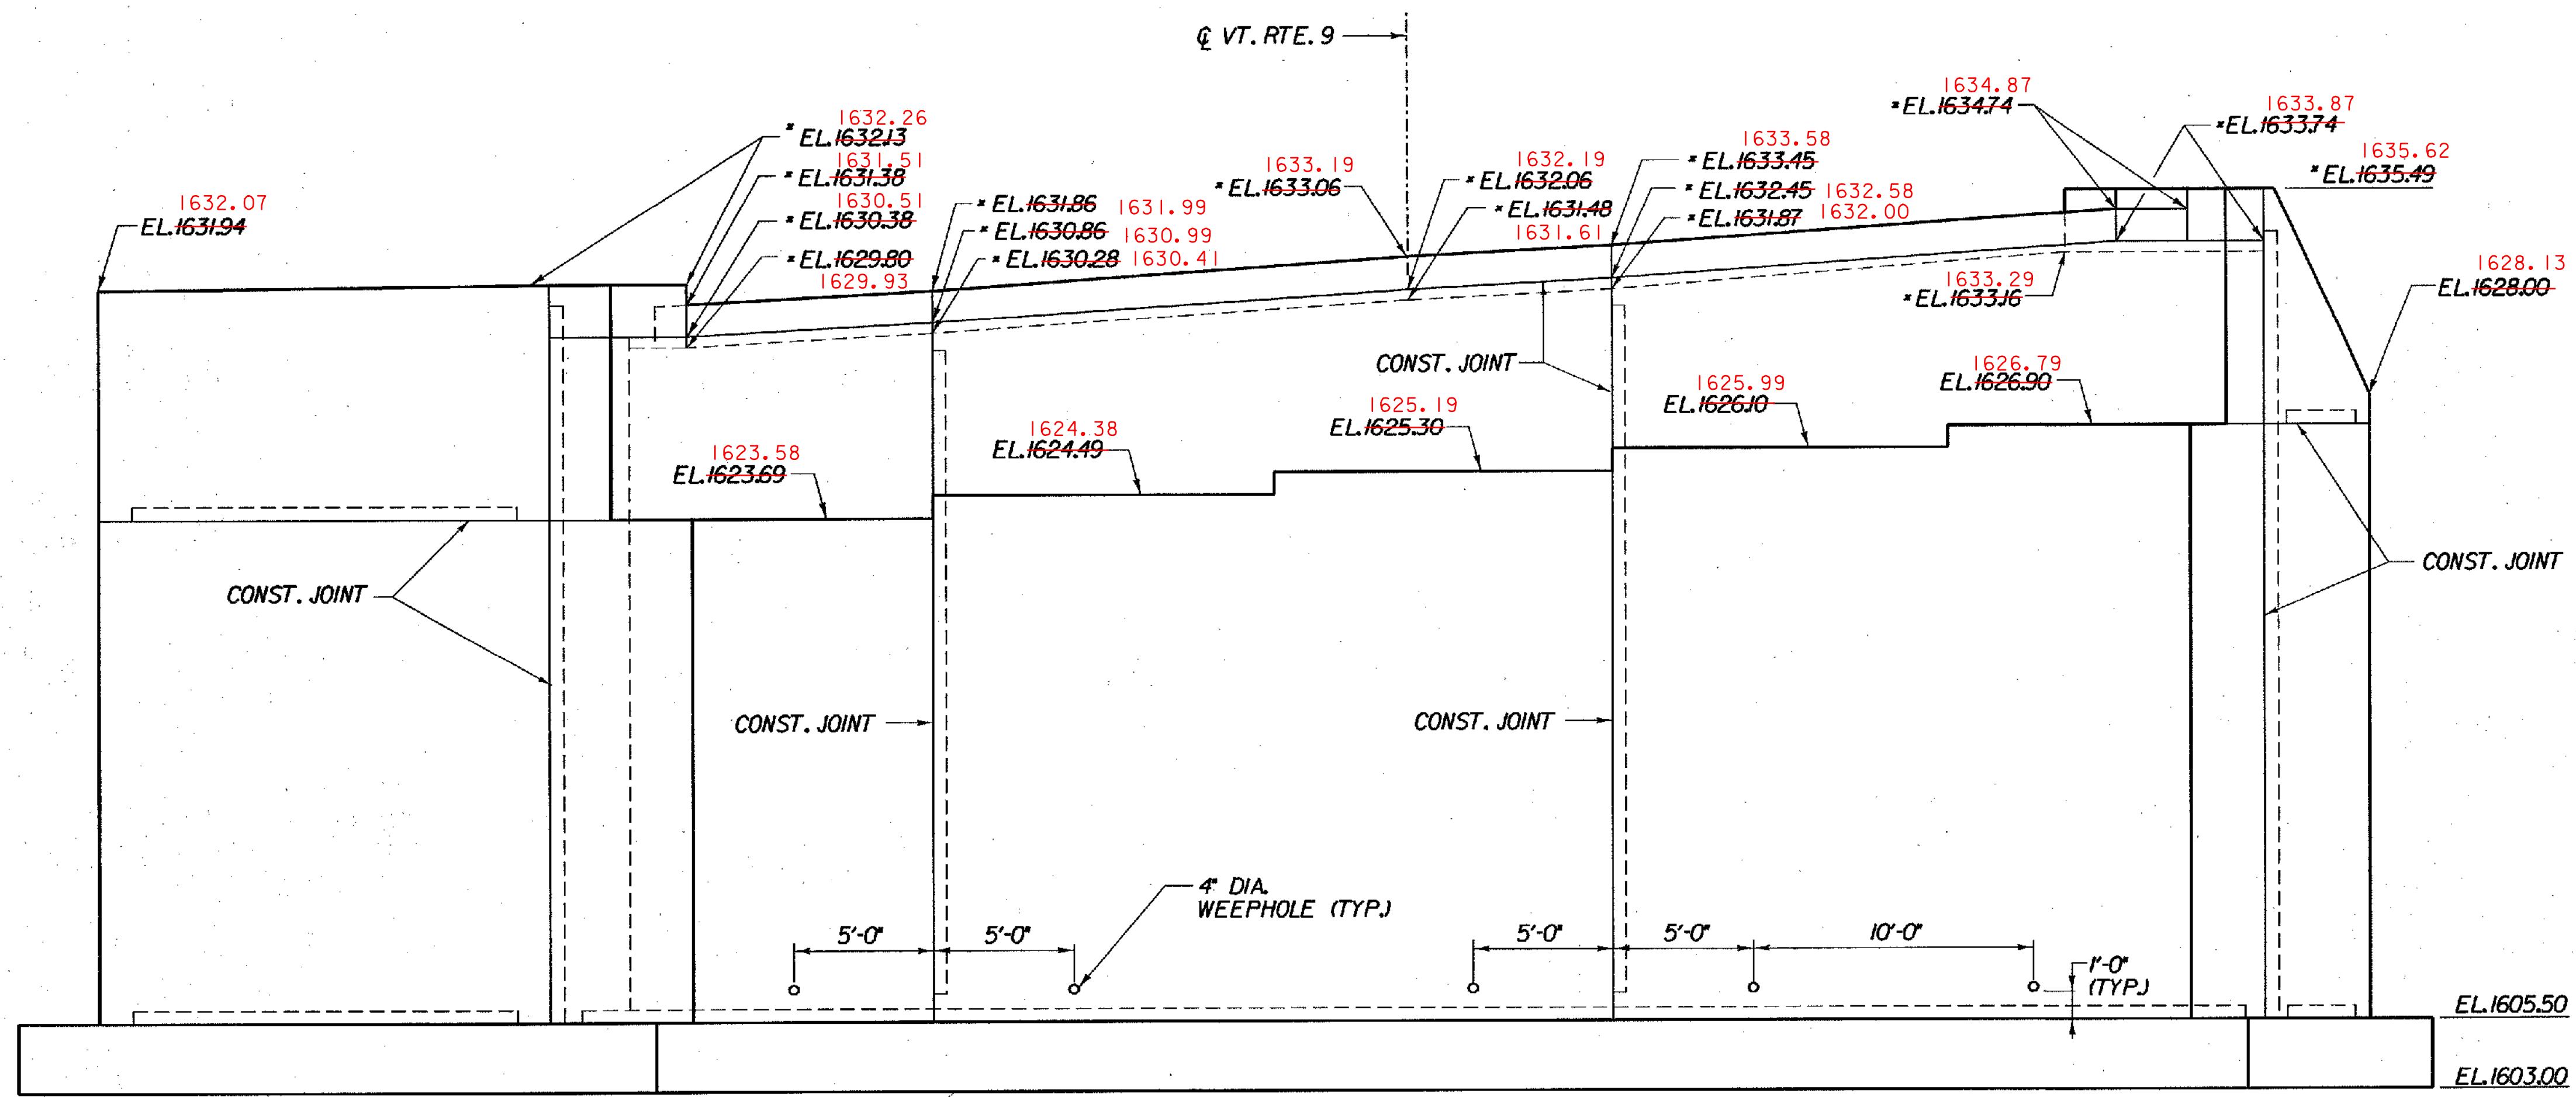

ABUTMENT 1 ELEVATION - BR 25A

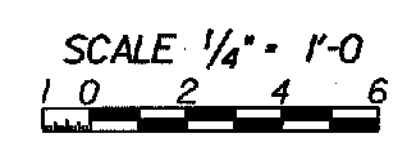

* ELEVATIONS ARE APPROXIMATE, USED FOR ESTIMATING PURPOSES ONLY. ALL TOP OF BACKWALL ELEVATIONS WILL BE DETERMINED AFTER STRUCTURAL STEEL IS SET.

STATE OF VERMONT AGENCY OF TRANSPORTATION			
Town Of	SEARSBURG	Bridge No.	25A
Highway No.	VT. RTE. 9	Log Sta.	
		Surv. Sta.	
VT. RTE. 9 OVER DEERFIELD RIVER			
ABUTMENT 1 ELEVATION - BR 25A			
Designed By	D. VIENI	Drawn by	Wm WEATHERBY
Checked By	M. OLSTAD	Bridge Design Supervisor	M. OLSTAD
Date	2/2002	Date	2/2002
PROJECT	SEARSBURG - WILMINGTON	PROJECT NO.	NHF 010-K18)
I.G.C. Info.			
Bridge Sheet No. BR321			Sheet 186 of 435



DATE TIME 10/27/02 USER 2225