


SCALE 1/4" = 1'-0"
 1 0 2 4 6

KEY:
 NF - NEAR FACE
 FF - FAR FACE
 EF - EACH FACE
 ▲ - CUT TO FIT IN FIELD
 3" CLR. UNLESS OTHERWISE SPECIFIED ON THE PLANS.

STATE OF VERMONT AGENCY OF TRANSPORTATION			
Town of	SEARSBURG	Bridge No.	25A
Highway No.	VT. RTE. 9	Log Sta.	
		Surv. Sta.	
VT. RTE. 9 OVER DEERFIELD RIVER			
ABUTMENT 1 FOOTING REINFORCING - BR 25A			
Designed By	D. VIENI	Drawn by	K. DETRICK
Checked By	M. OLSTAD	Bridge Design Supervisor	M. OLSTAD
Date	12/2001	Date	12/2001
PROJECT	SEARSBURG - WILMINGTON	PROJECT NO.	NHF 010-K18)
I.G.C. Info.		I.G.C. Info.	
Bridge Sheet No. BR322		Sheet 187 of 435	

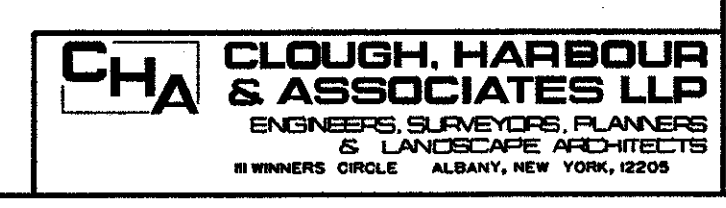

FILE NAME: s:\9755\WSTN\15\BRDC25A\25a.ab1.dwg
 DATE/TIME: 12/12/01
 USER: 2225