


WINGWALLS AND BACKWALL RAISED 1/2"

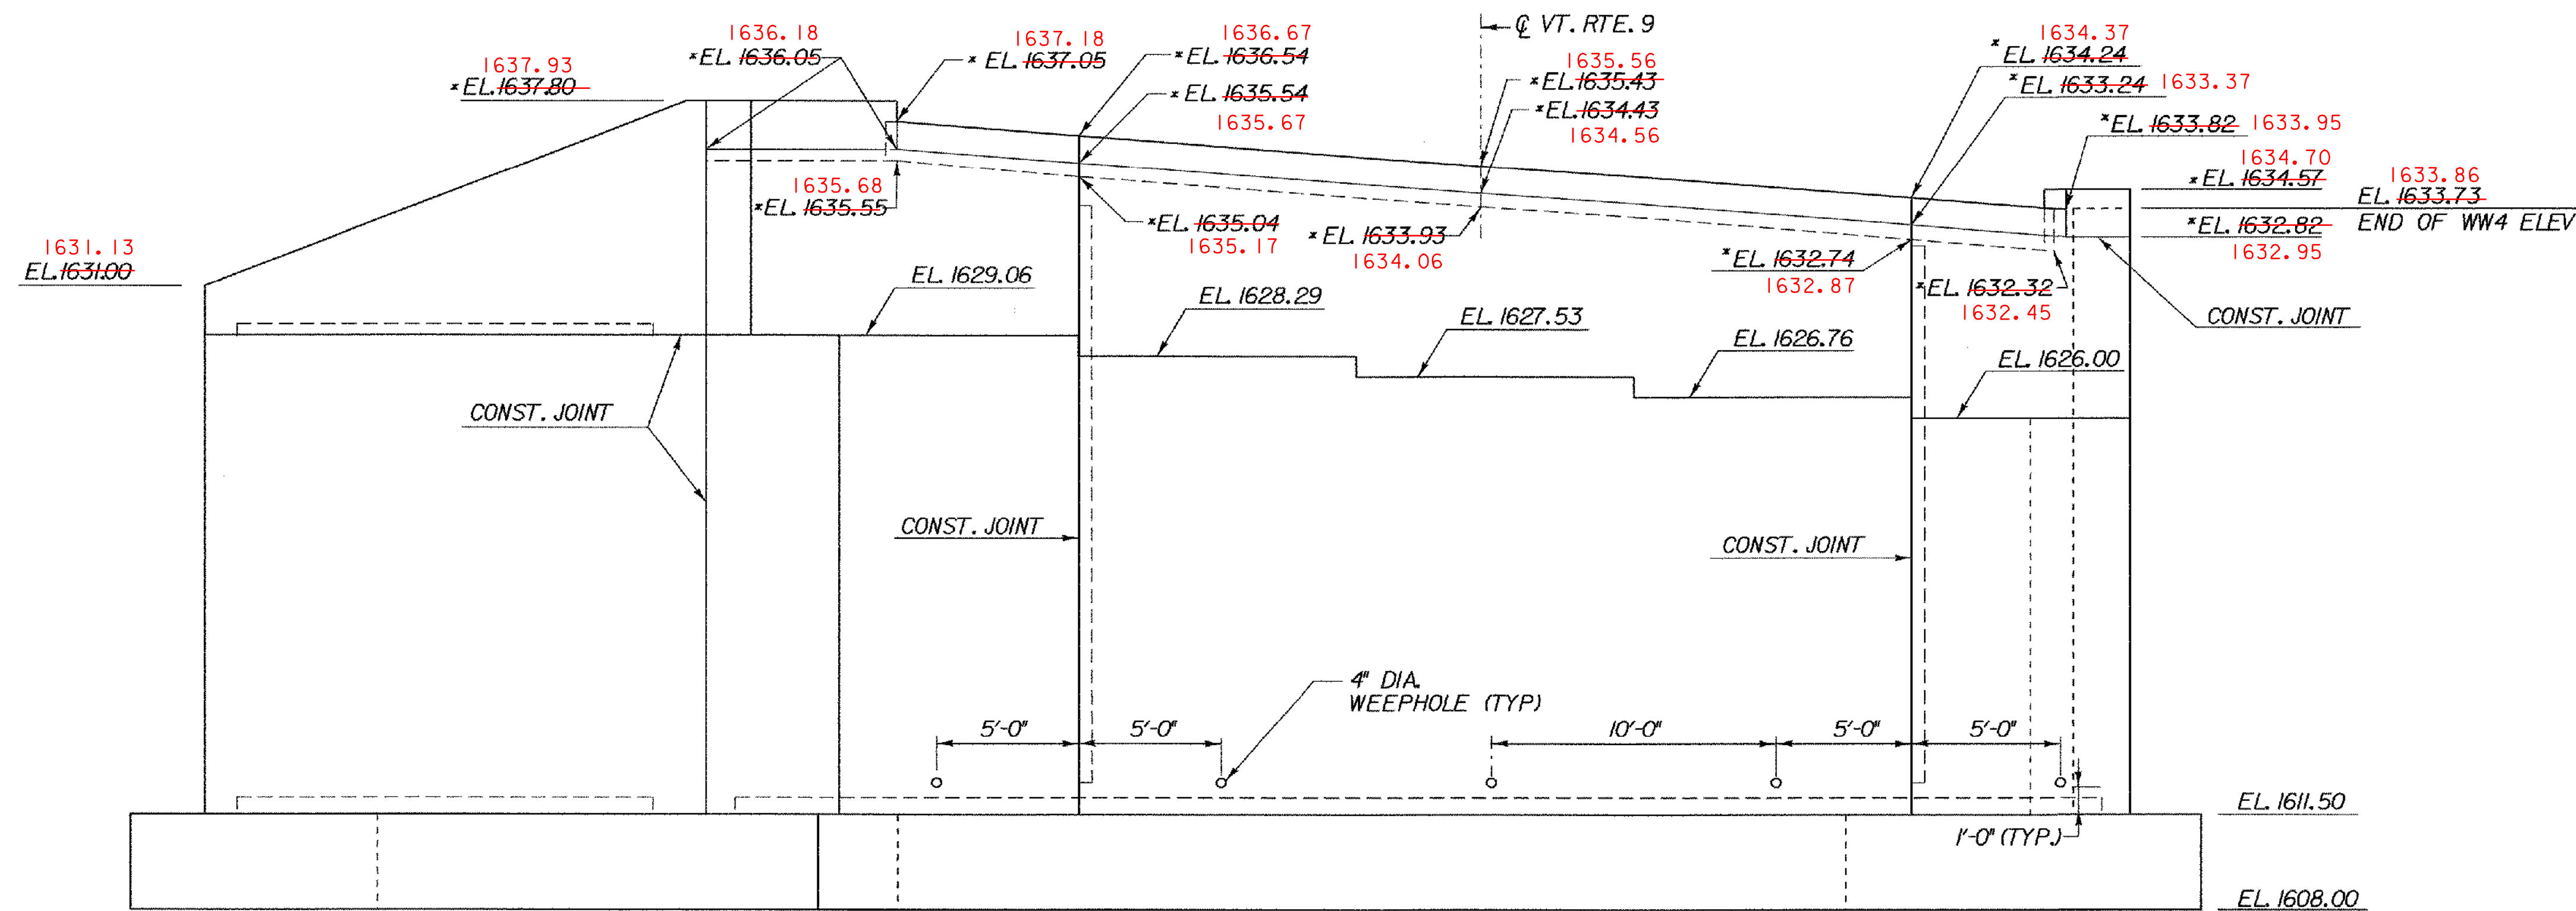

**ABUTMENT 2 ELEVATION - BR 25A**

SCALE 1/4" = 1'-0"  
 1 0 2 4 6

\* ELEVATIONS ARE APPROXIMATE, USED FOR ESTIMATING PURPOSES ONLY. ALL TOP OF BACKWALL ELEVATIONS WILL BE DETERMINED AFTER STRUCTURAL STEEL IS SET.

SHEET NAME: <b>ABUTMENT 2 REDESIGN ELEVATION</b>		
PROJECT NAME: <b>SEARSBURG</b>	HIGHWAY NO.: <b>ROUTE 9</b>	BRIDGE NO.: <b>25A</b>
PROJECT NUMBER: <b>NH F 010-1(18)</b>	OVER: <b>THE DEERFIELD RIVER</b>	
FILE NAME: /str4/78d096/25 abut2.dgn	PLOT DATE: <b>14-FEB-2003</b>	
PROJECT MANAGER: <b>R.WHITCOMB</b>	DRAWN BY: <b>J.GILMORE</b>	
DESIGNED BY: <b>CH&amp;A LLP</b>	IPARM NAME: <b>br328</b>	
BRIDGE SHEET NUMBER: <b>BR328</b>	SHEET <b>192</b> OF <b>435</b>	