



WINGWALL ELEVATION CORRECTIONS
 REFLECT A RAISING OF BRIDGE DECK
 0.19 FT (INCREASED HAUNCH TO
 MAINTAIN MINIMUM.)

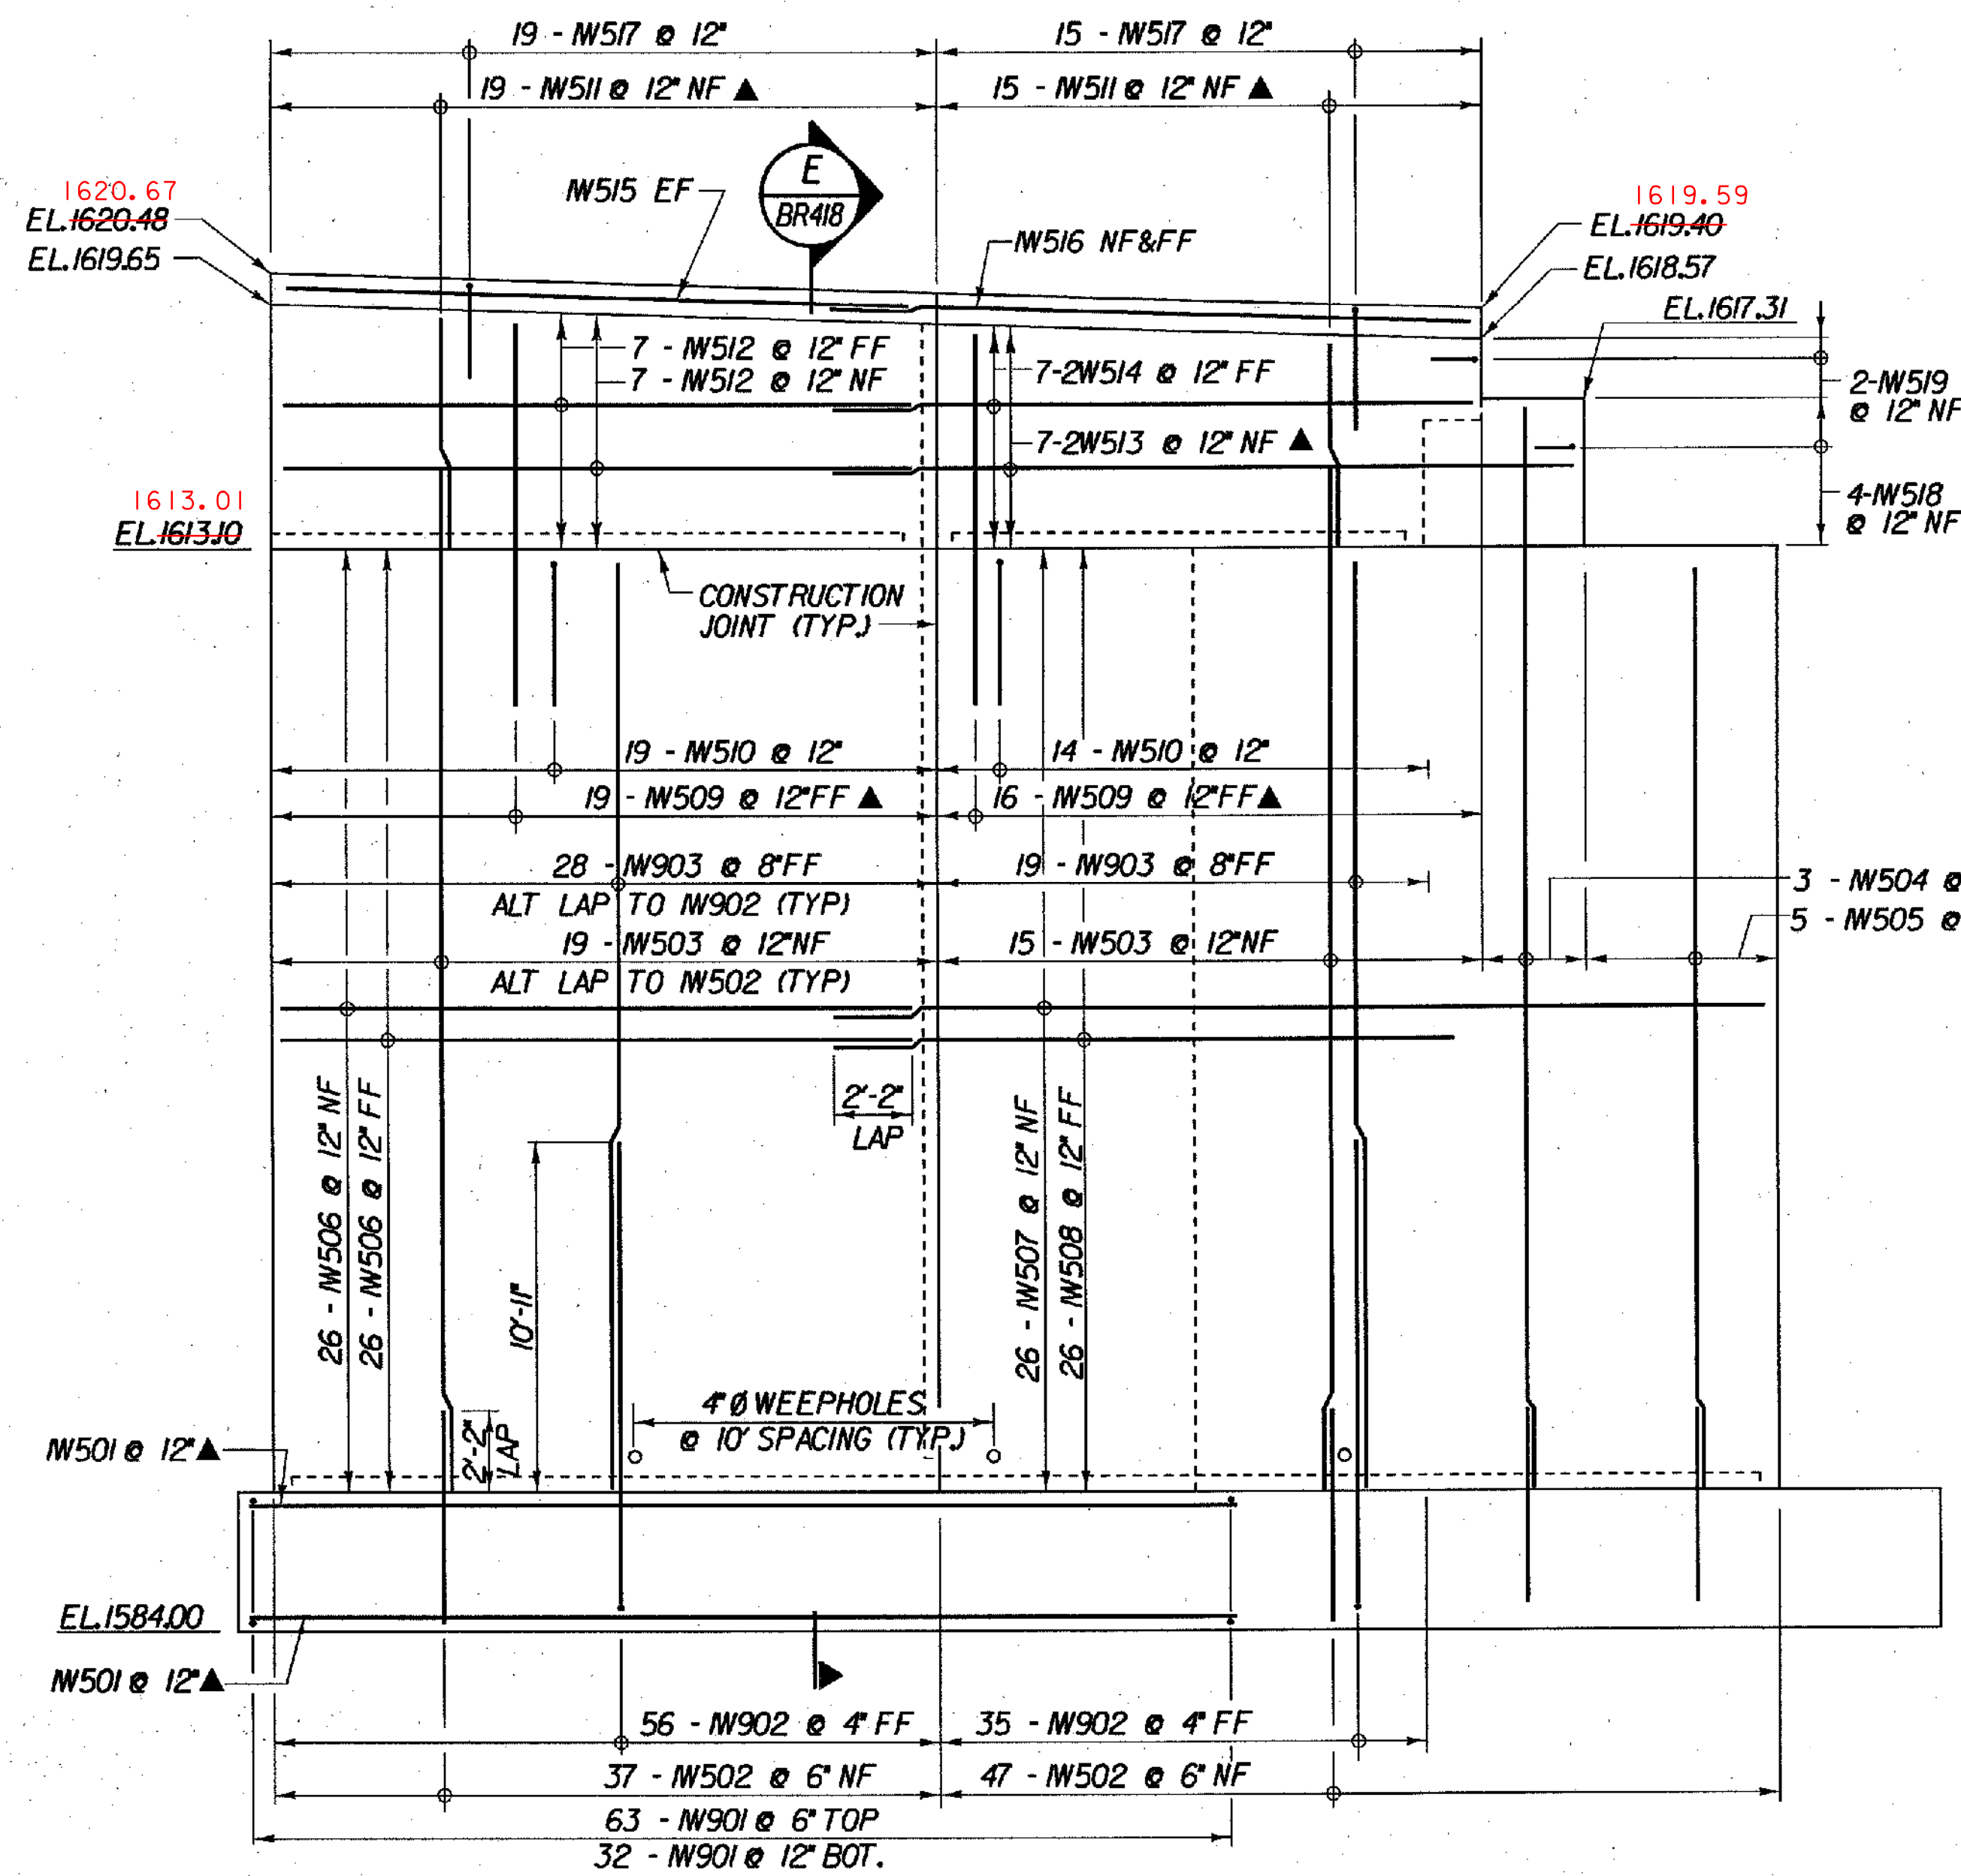

ELEVATION - WINGWALL 1

SCALE 1/4" = 1'-0"
 1 0 2 4 6

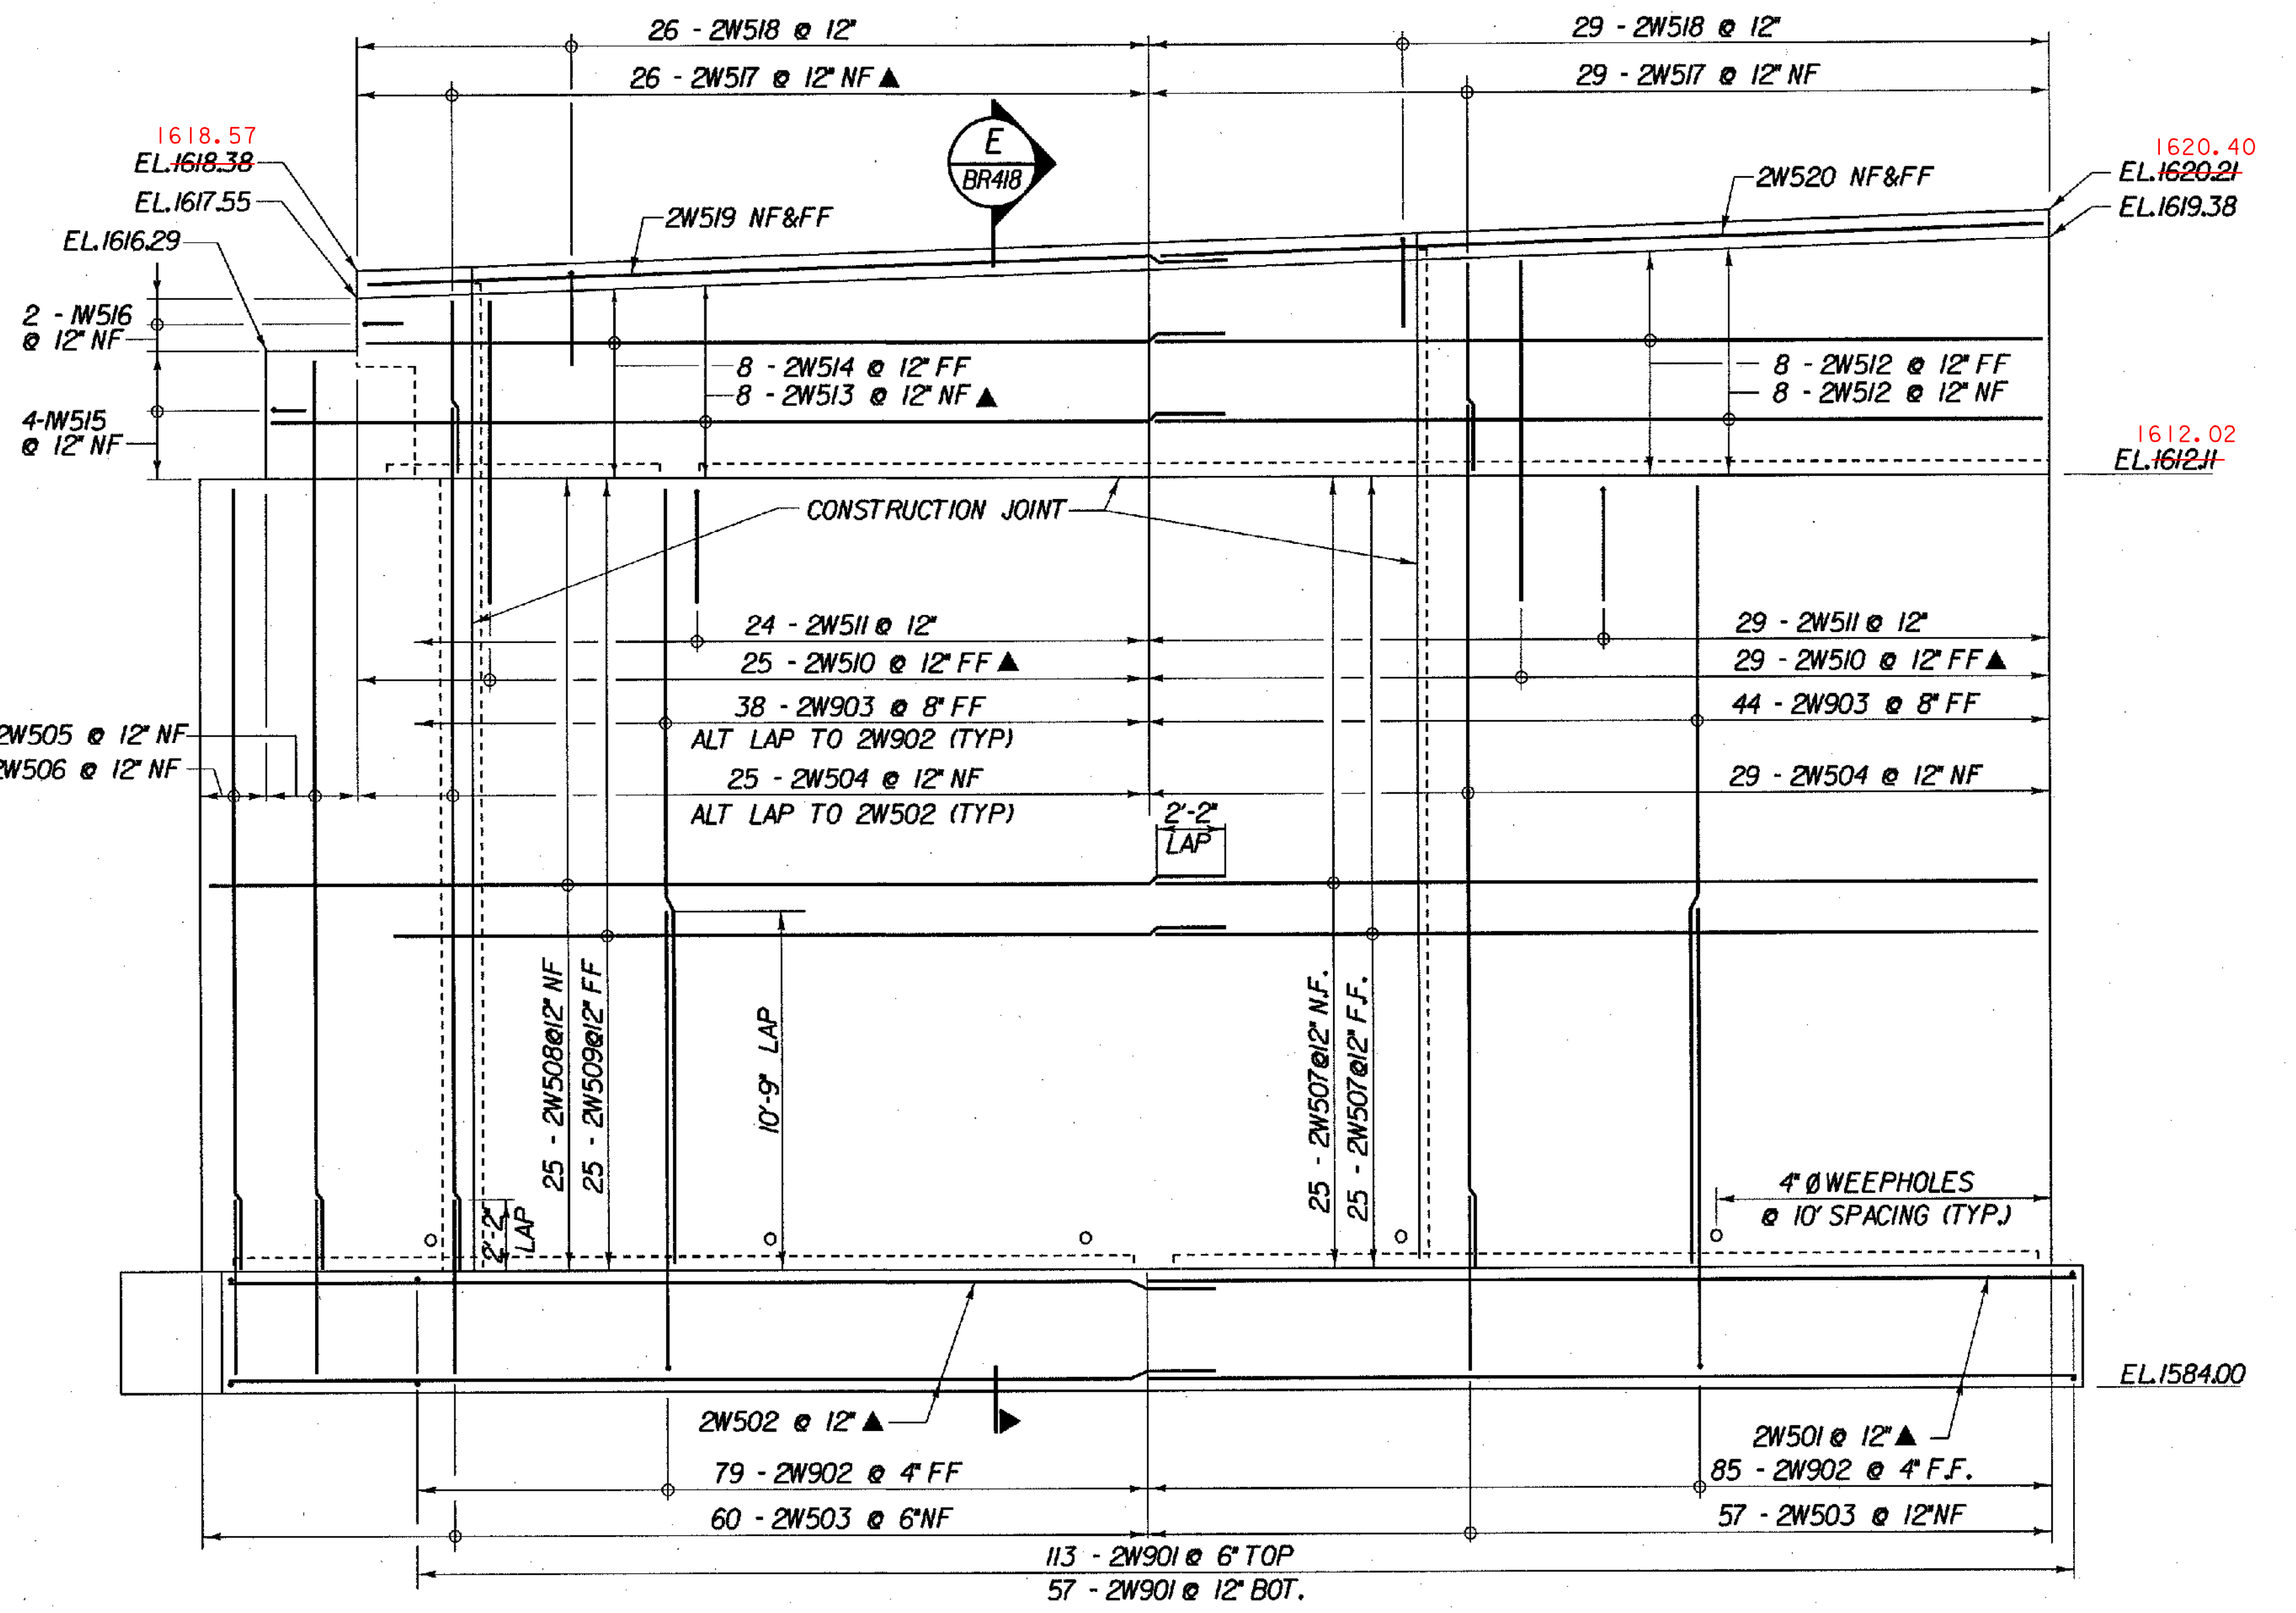

ELEVATION - WINGWALL 2

SCALE 1/4" = 1'-0"
 1 0 2 4 6

KEY:

- NF - NEAR FACE
- FF - FAR FACE
- EF - EACH FACE
- ▲ - BARS TO BE CUT IN FIELD
- ◆ - FIELD BEND
- * ELEVATIONS APPLY AT NEAR FACE OF BACKWALL
- 3" CLR. UNLESS OTHERWISE SPECIFIED ON THE PLANS.

STATE OF VERMONT
 AGENCY OF TRANSPORTATION

Town of	SEARSBURG	Bridge No.	25B
Highway No.	VT. RTE. 9	Log Sta.	
		Surv. Sta.	
VT. RTE. 9 OVER DEERFIELD RIVER			
ABUTMENT I WINGWALL ELEVATIONS			
Designed By	D. VIENI	Drawn by	J. LAGONE
Checked By	M. OLSTAD	Date	2/2002
		Bridge Design Supervisor	M. OLSTAD
		Date	2/2002
PROJECT	SEARSBURG - WILMINGTON	PROJECT NO.	NHF 010-K181
I.G.C. Info.			
Bridge Sheet No.	BR417	Sheet	223 OF 435

CHA CLOUGH, HARBOUR & ASSOCIATES LLP
 ENGINEERS, SURVEYORS, PLANNERS & LANDSCAPE ARCHITECTS
 11 WINNERS CIRCLE ALBANY, NEW YORK, 12205