



SECTION 2

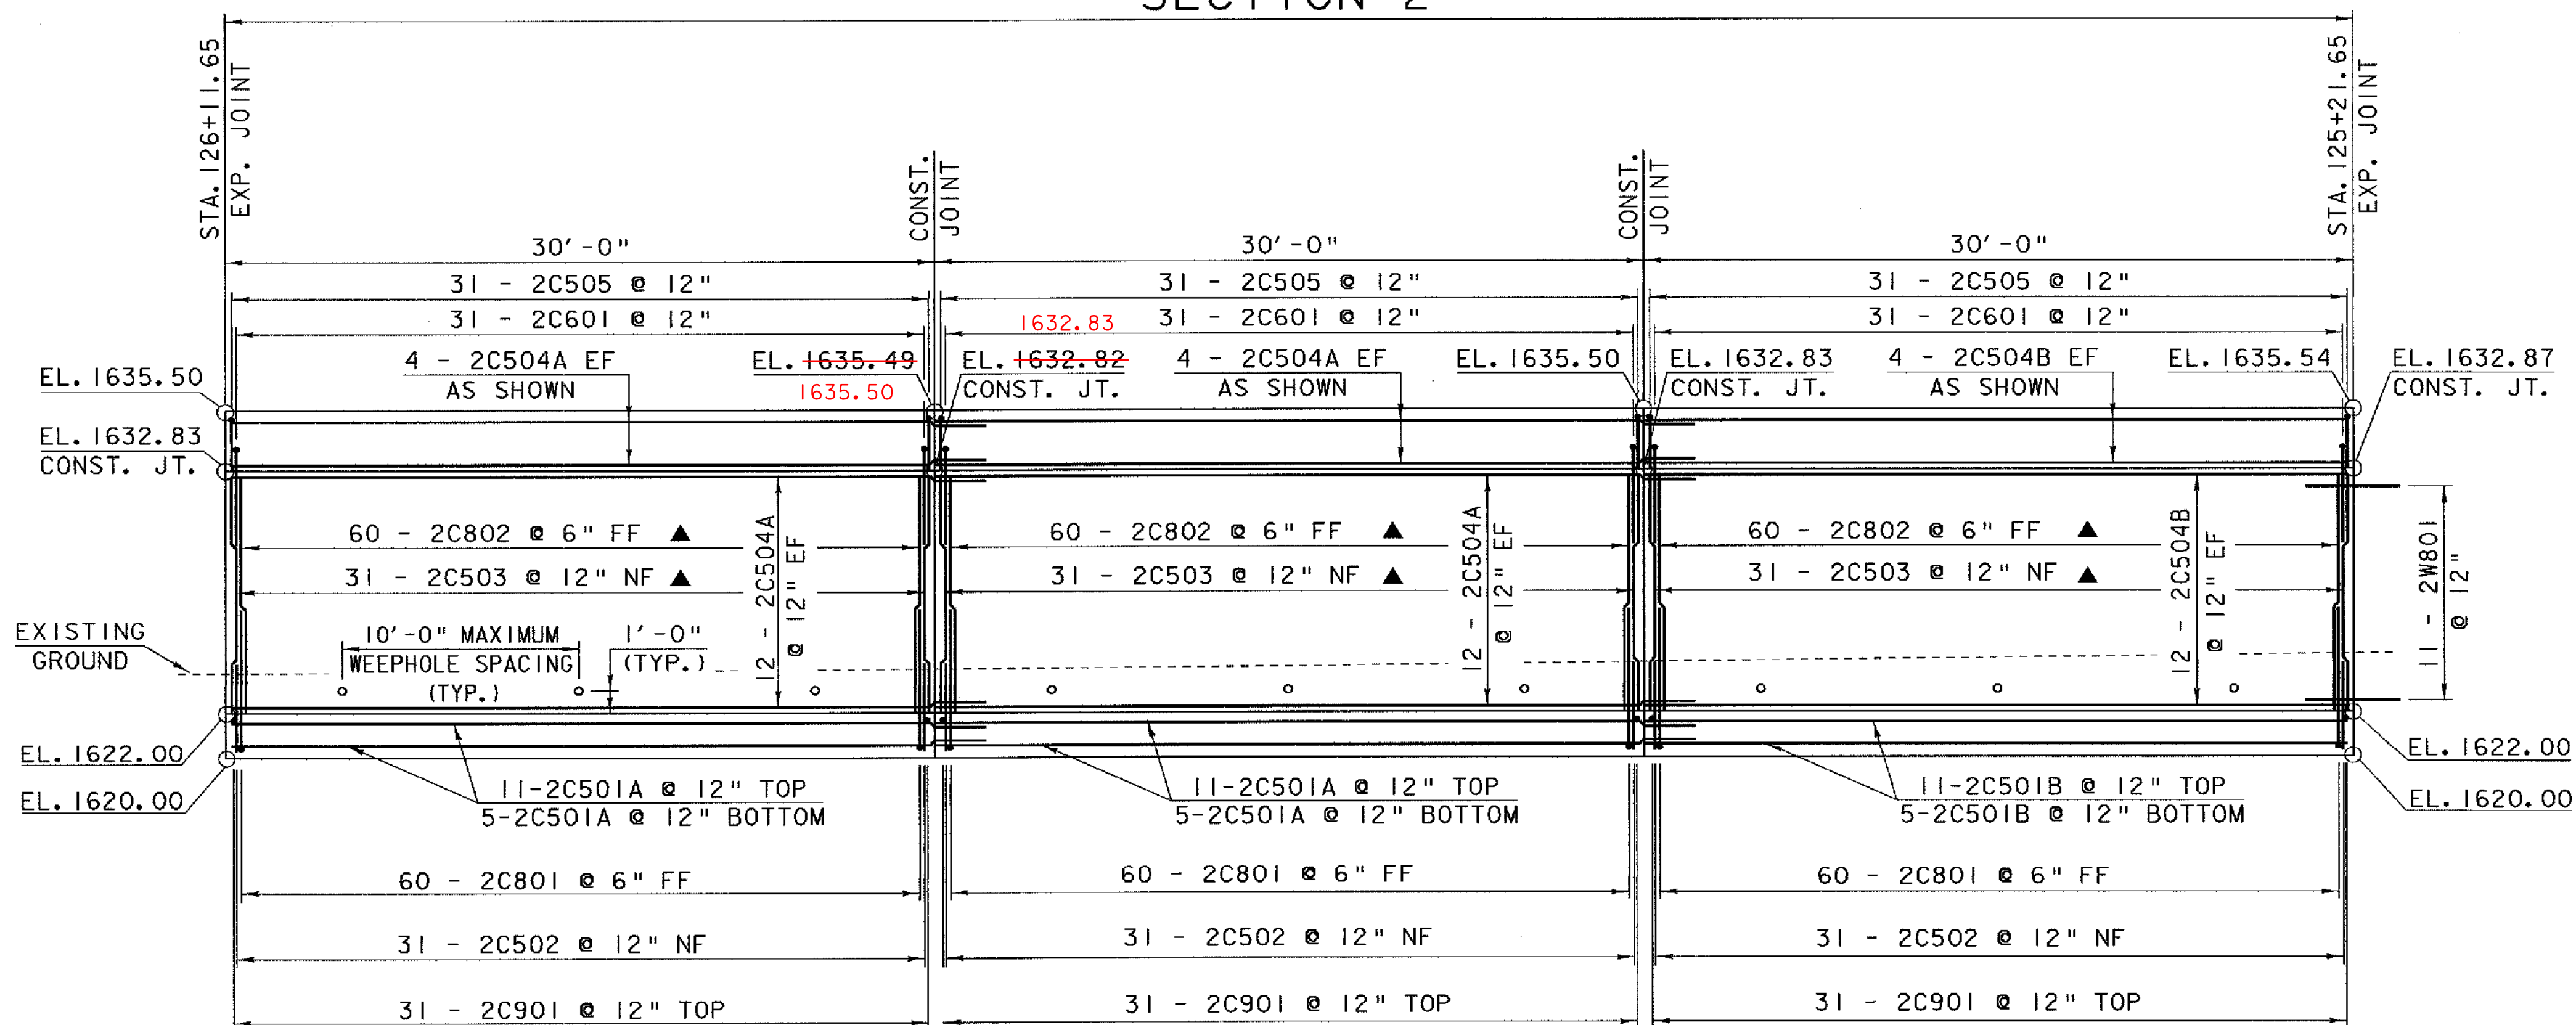

ELEVATION

SCALE: 1" = 5'

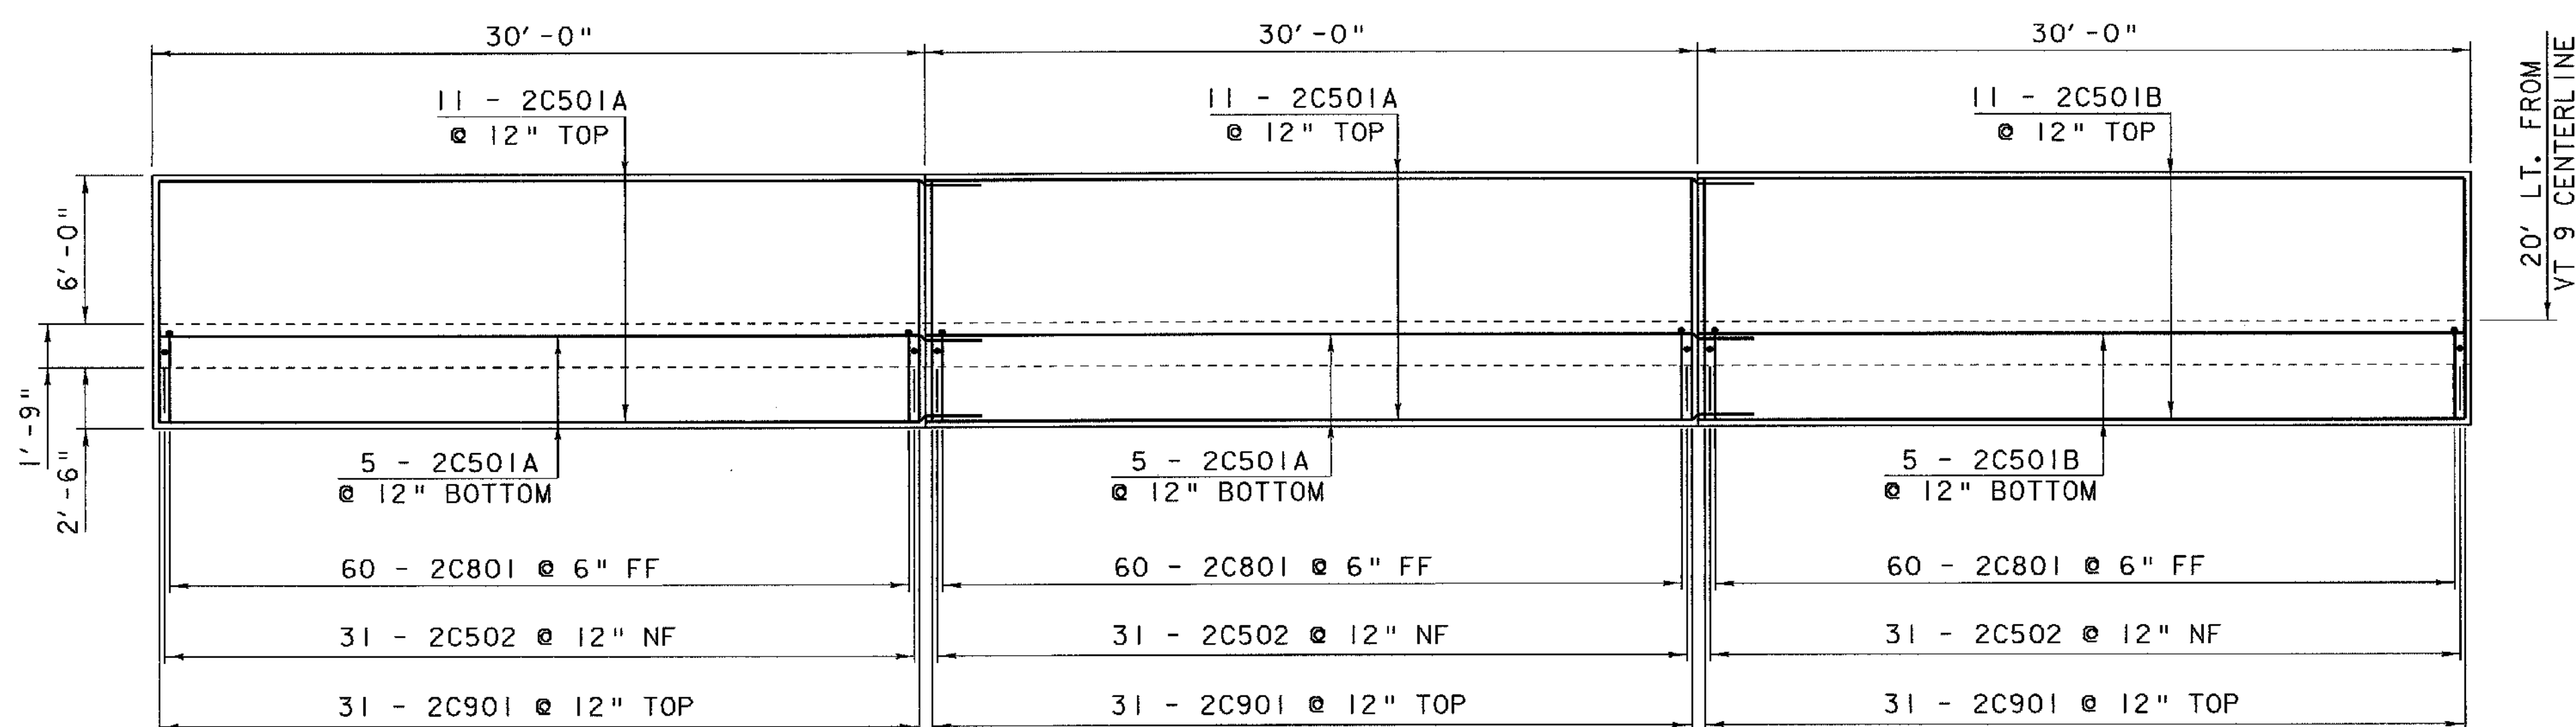

FOOTING PLAN

SCALE: 1" = 5'

SECTION	DESIGN
2	C

NOTE:

- NF = NEAR FACE
- FF = FAR FACE
- EF = EACH FACE
- ▲ = CUT TO FIT IN FIELD
- 3" CLR. UNLESS OTHERWISE NOTED
- 2'-2" BAR LAP UNLESS OTHERWISE NOTED

STATE OF VERMONT AGENCY OF TRANSPORTATION	
Town of SEARSBURG-WILMINGTON	Bridge No.
Highway No. VT 9	Log Sta.
	Surv. Sta.
CATAMOUNT TRAIL WALL	
PLAN AND ELEVATION SECTION 2	
Designed By J. LACROIX	Drawn By J. LACROIX
Checked By G. ROY	Bridge Design Supervisor R. R. WHITCOMB
Date 2/02	Date 2/02
PROJECT SEARSBURG-WILMINGTON	PROJECT NO. NHF 010-1 (18)
I.G.C. Info. 78d096\Structures\sd096wal.dgn	sd096wa2.i
Bridge Sheet No. BR504	Sheet 243 of 435