



SECTION 5

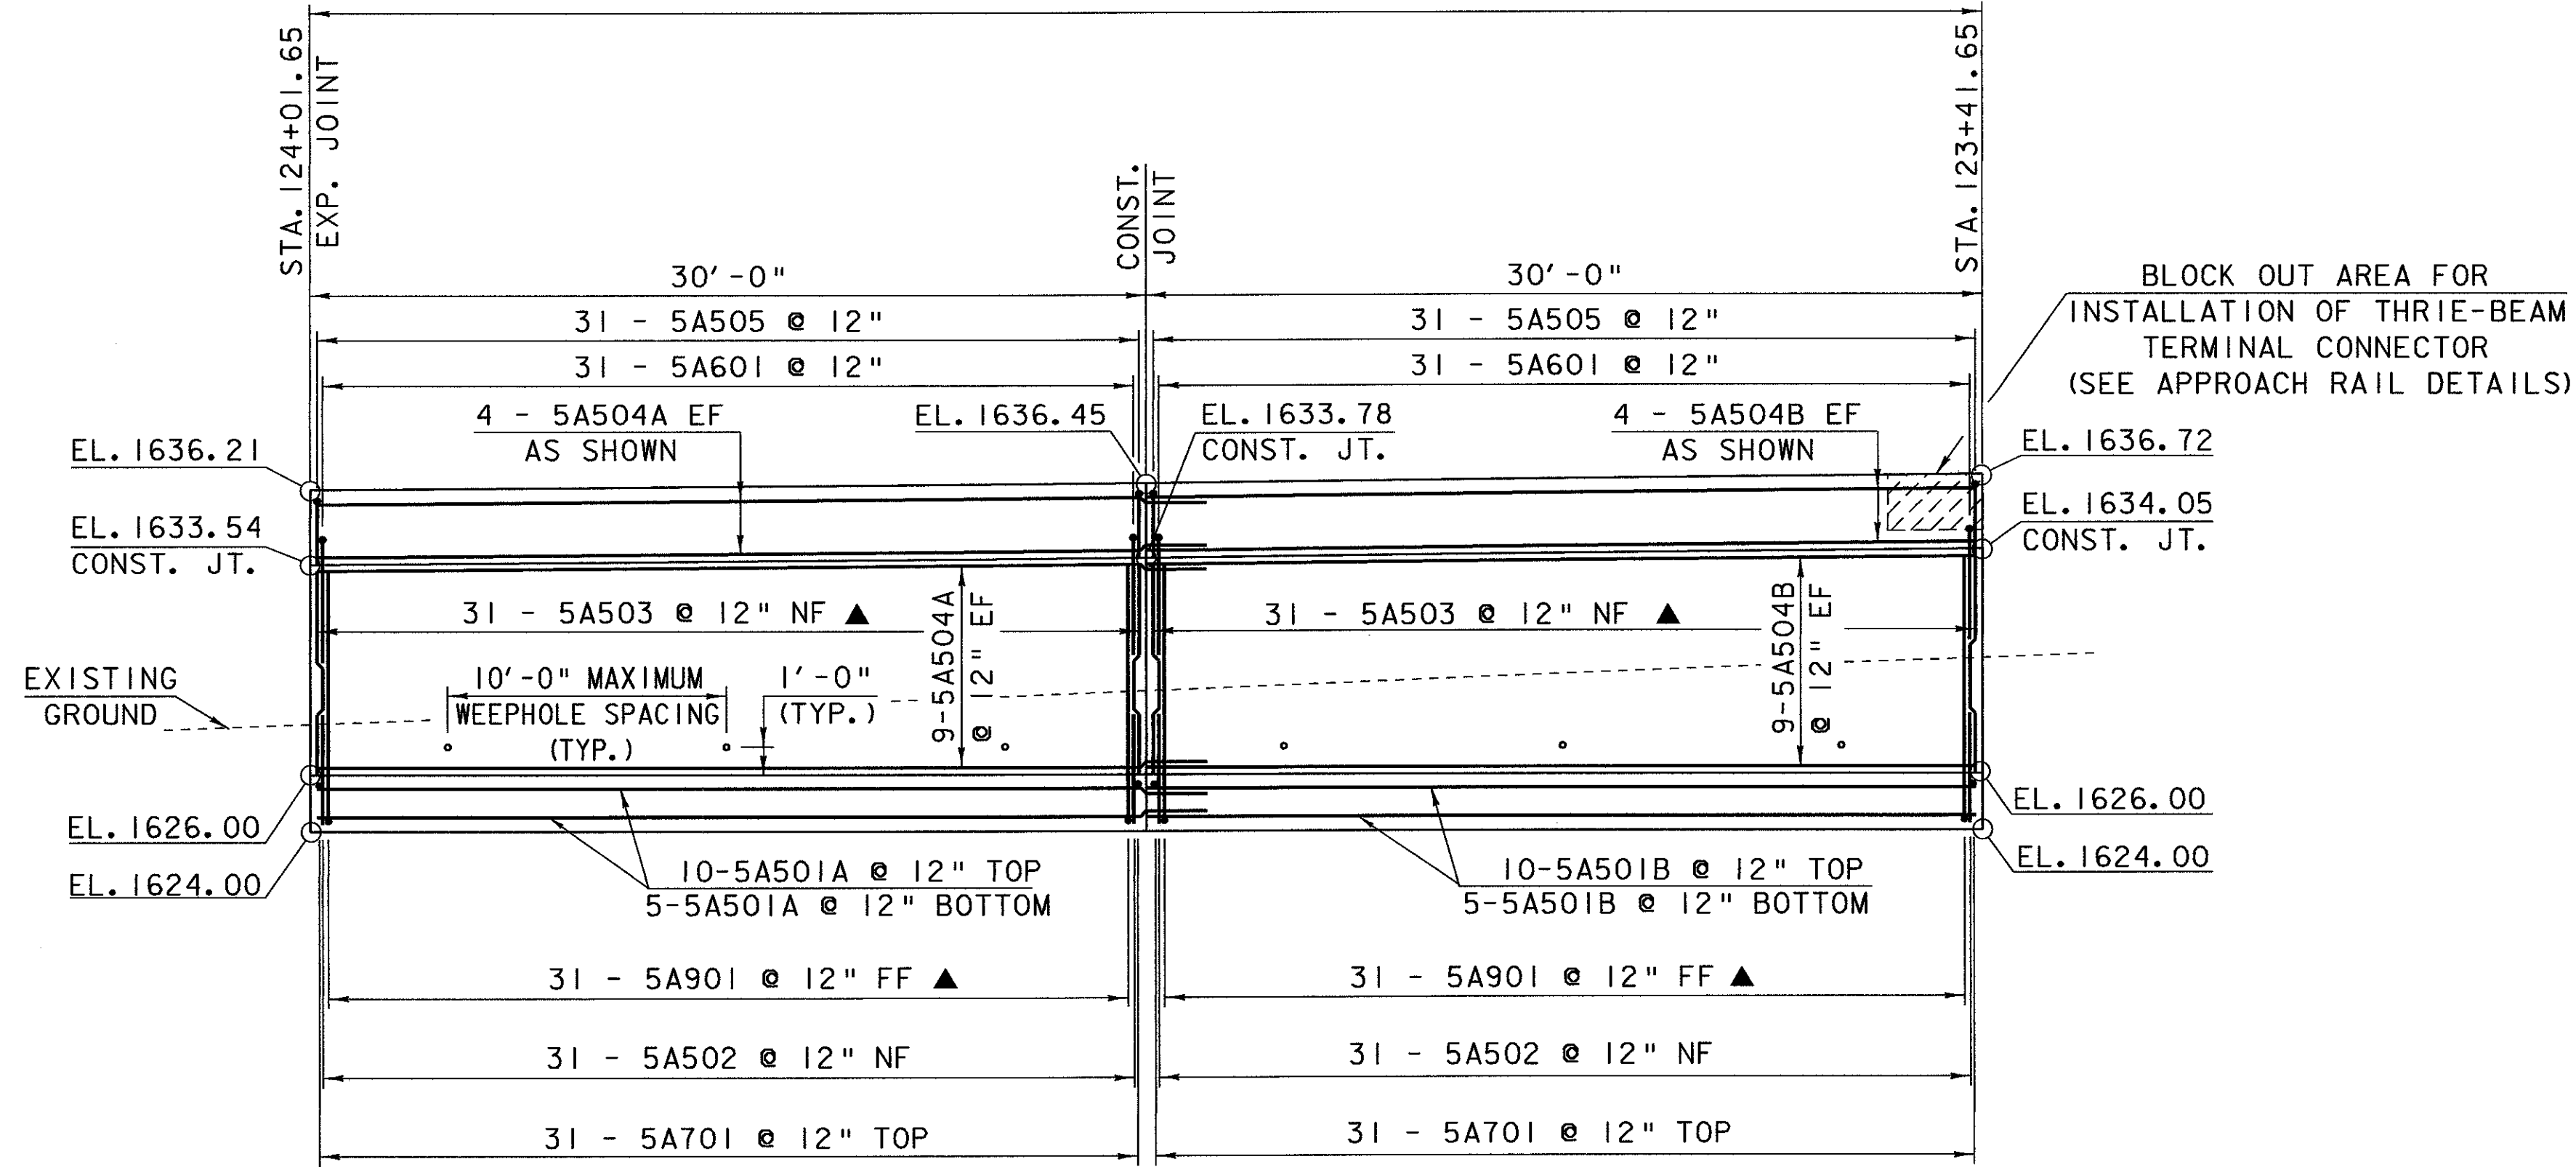

SECTION	DESIGN
5	A

ELEVATION

SCALE: 1" = 5'-0"

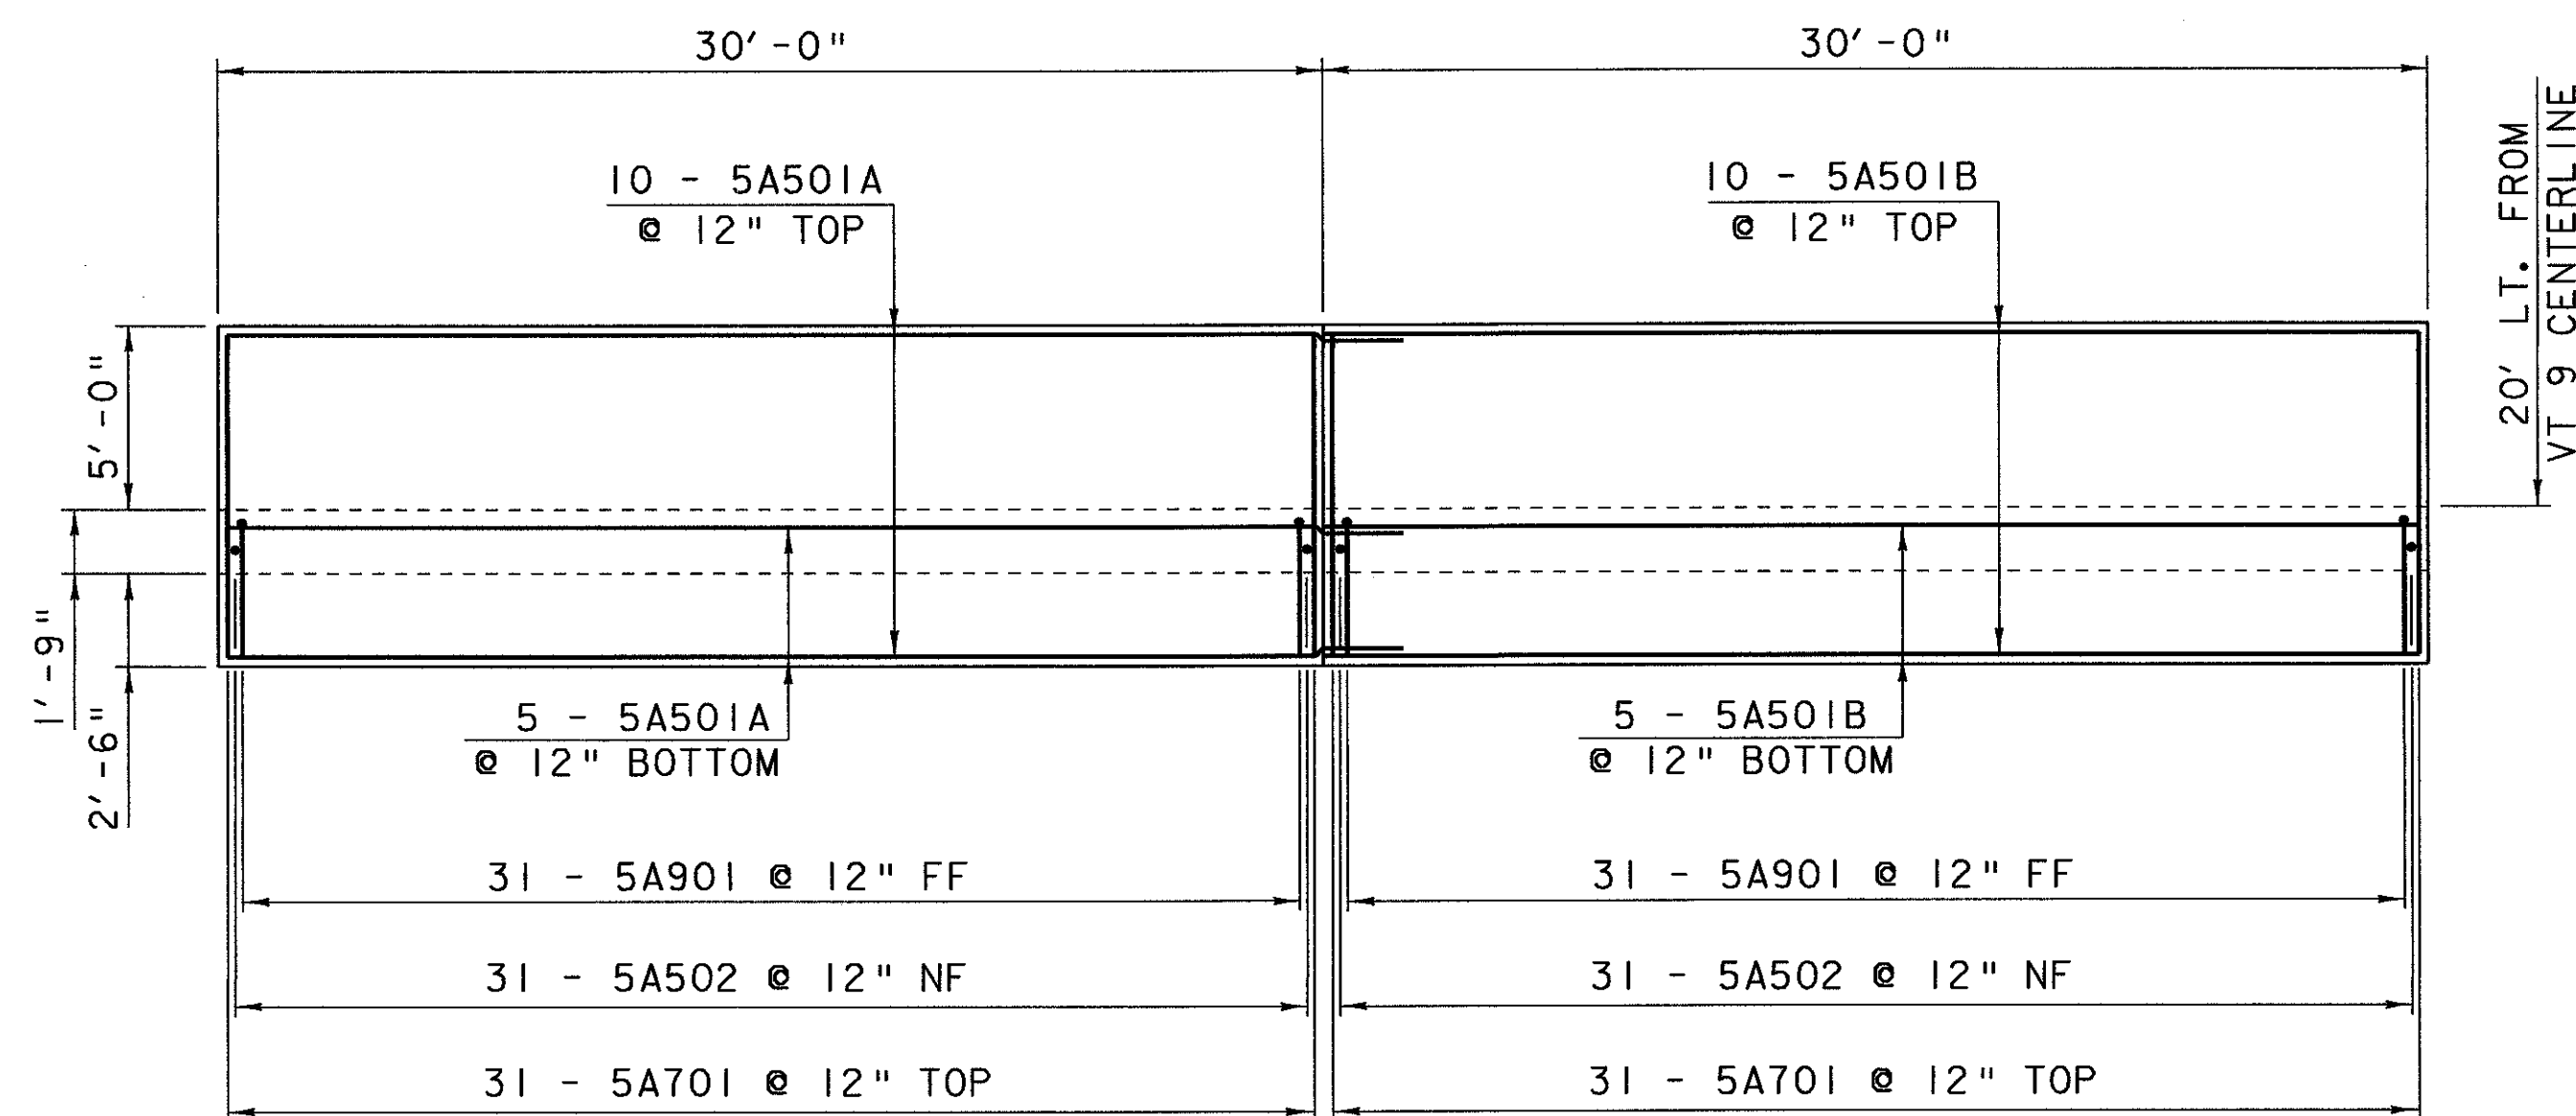

FOOTING PLAN

SCALE: 1" = 5'-0"

NOTE:

- NF = NEAR FACE
- FF = FAR FACE
- EF = EACH FACE
- ▲ = CUT TO FIT IN FIELD
- 3" CLR. UNLESS OTHERWISE NOTED
- 2'-2" BAR LAP UNLESS OTHERWISE NOTED

STATE OF VERMONT AGENCY OF TRANSPORTATION

Town of SEARSBURG-WILMINGTON	Bridge No.
Highway No. VT 9	Log Sta.
	Surv. Sta.
CATAMOUNT TRAIL WALL	
PLAN AND ELEVATION SECTION 5	
Designed By J. LACROIX	Drawn By J. LACROIX
Checked By G. ROY Date 2/02	Bridge Design Supervisor R. R. WHITCOMB Date 2/02
PROJECT SEARSBURG-WILMINGTON	PROJECT NO. NHF 010-1 (18)
LG.C. Info. 78d096\Structures\sd096wa1.dgn	sd096wa4.i
Bridge Sheet No. BR506	Sheet 245 of 435