

REV. PC 113+61.81

VT RTE. 9

PROPOSED  
VT RTE.


BRIDGE

S2°11'03.00"W

LEGEND

- TRAFFIC BARRIER -
- BARRLE -

NOTE: TEMPORARY TRAFFIC BARRIER AND BARRELS SHALL BE PLACED FOR CONSTRUCTION PHASES AS DIRECTED BY THE RESIDENT ENGINEER.

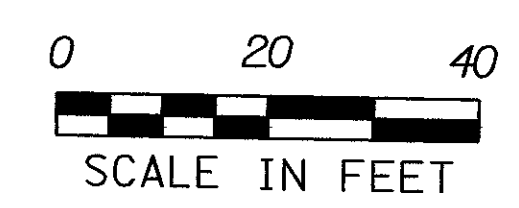

TRAFFIC CONTROL AND CONSTRUCTION PHASE I FROM STAT. 113+50 ~ 118+61.38

PROJECT NAME:	SEARSBURG - WILMINGTON	PLOT DATE:	13-FEB-2002
PROJECT NUMBER:	NHF 010-1(18)	DRAWN BY:	SQUAD B
FILE NAME:	dd096d01	CHECKED BY:	
PROJECT LEADER:	DELLA SANTA	DESIGN FILE NAME:	780096/DESIGN/DET09.DGN
DESIGNED BY:		SHEET	26 OF 435