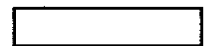

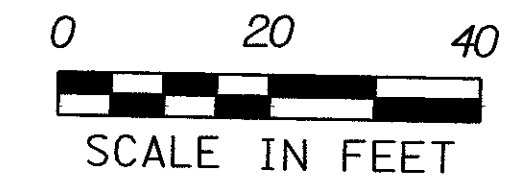


LEGEND
 TRAFFIC BARRIER - 
 BARRLE - 

NOTE: TEMPORARY TRAFFIC BARRIER AND BARRELS SHALL BE PLACED FOR CONSTRUCTION PHASES AS DIRECTED BY THE RESIDENT ENGINEER.



TRAFFIC CONTROL AND CONSTRUCTION PHASE 2 FROM STAT. 113+50 ~ 118+61.38

PROJECT NAME:	SEARSBURG - WILMINGTON	PLOT DATE:	13-FEB-2002
PROJECT NUMBER:	NHF 010-1(18)	DRAWN BY:	SQUAD B
FILE NAME:	dd096d02	DESIGNED BY:	
PROJECT LEADER:	DELLA SANTA	CHECKED BY:	
DESIGN FILE NAME:	780096/DESIGN/Detbor.DGN	SHEET	262 OF 435