


TRAFFIC CONTROL AND CONSTRUCTION PHASE 2 FROM STAT. 121+00 ~ 129+00

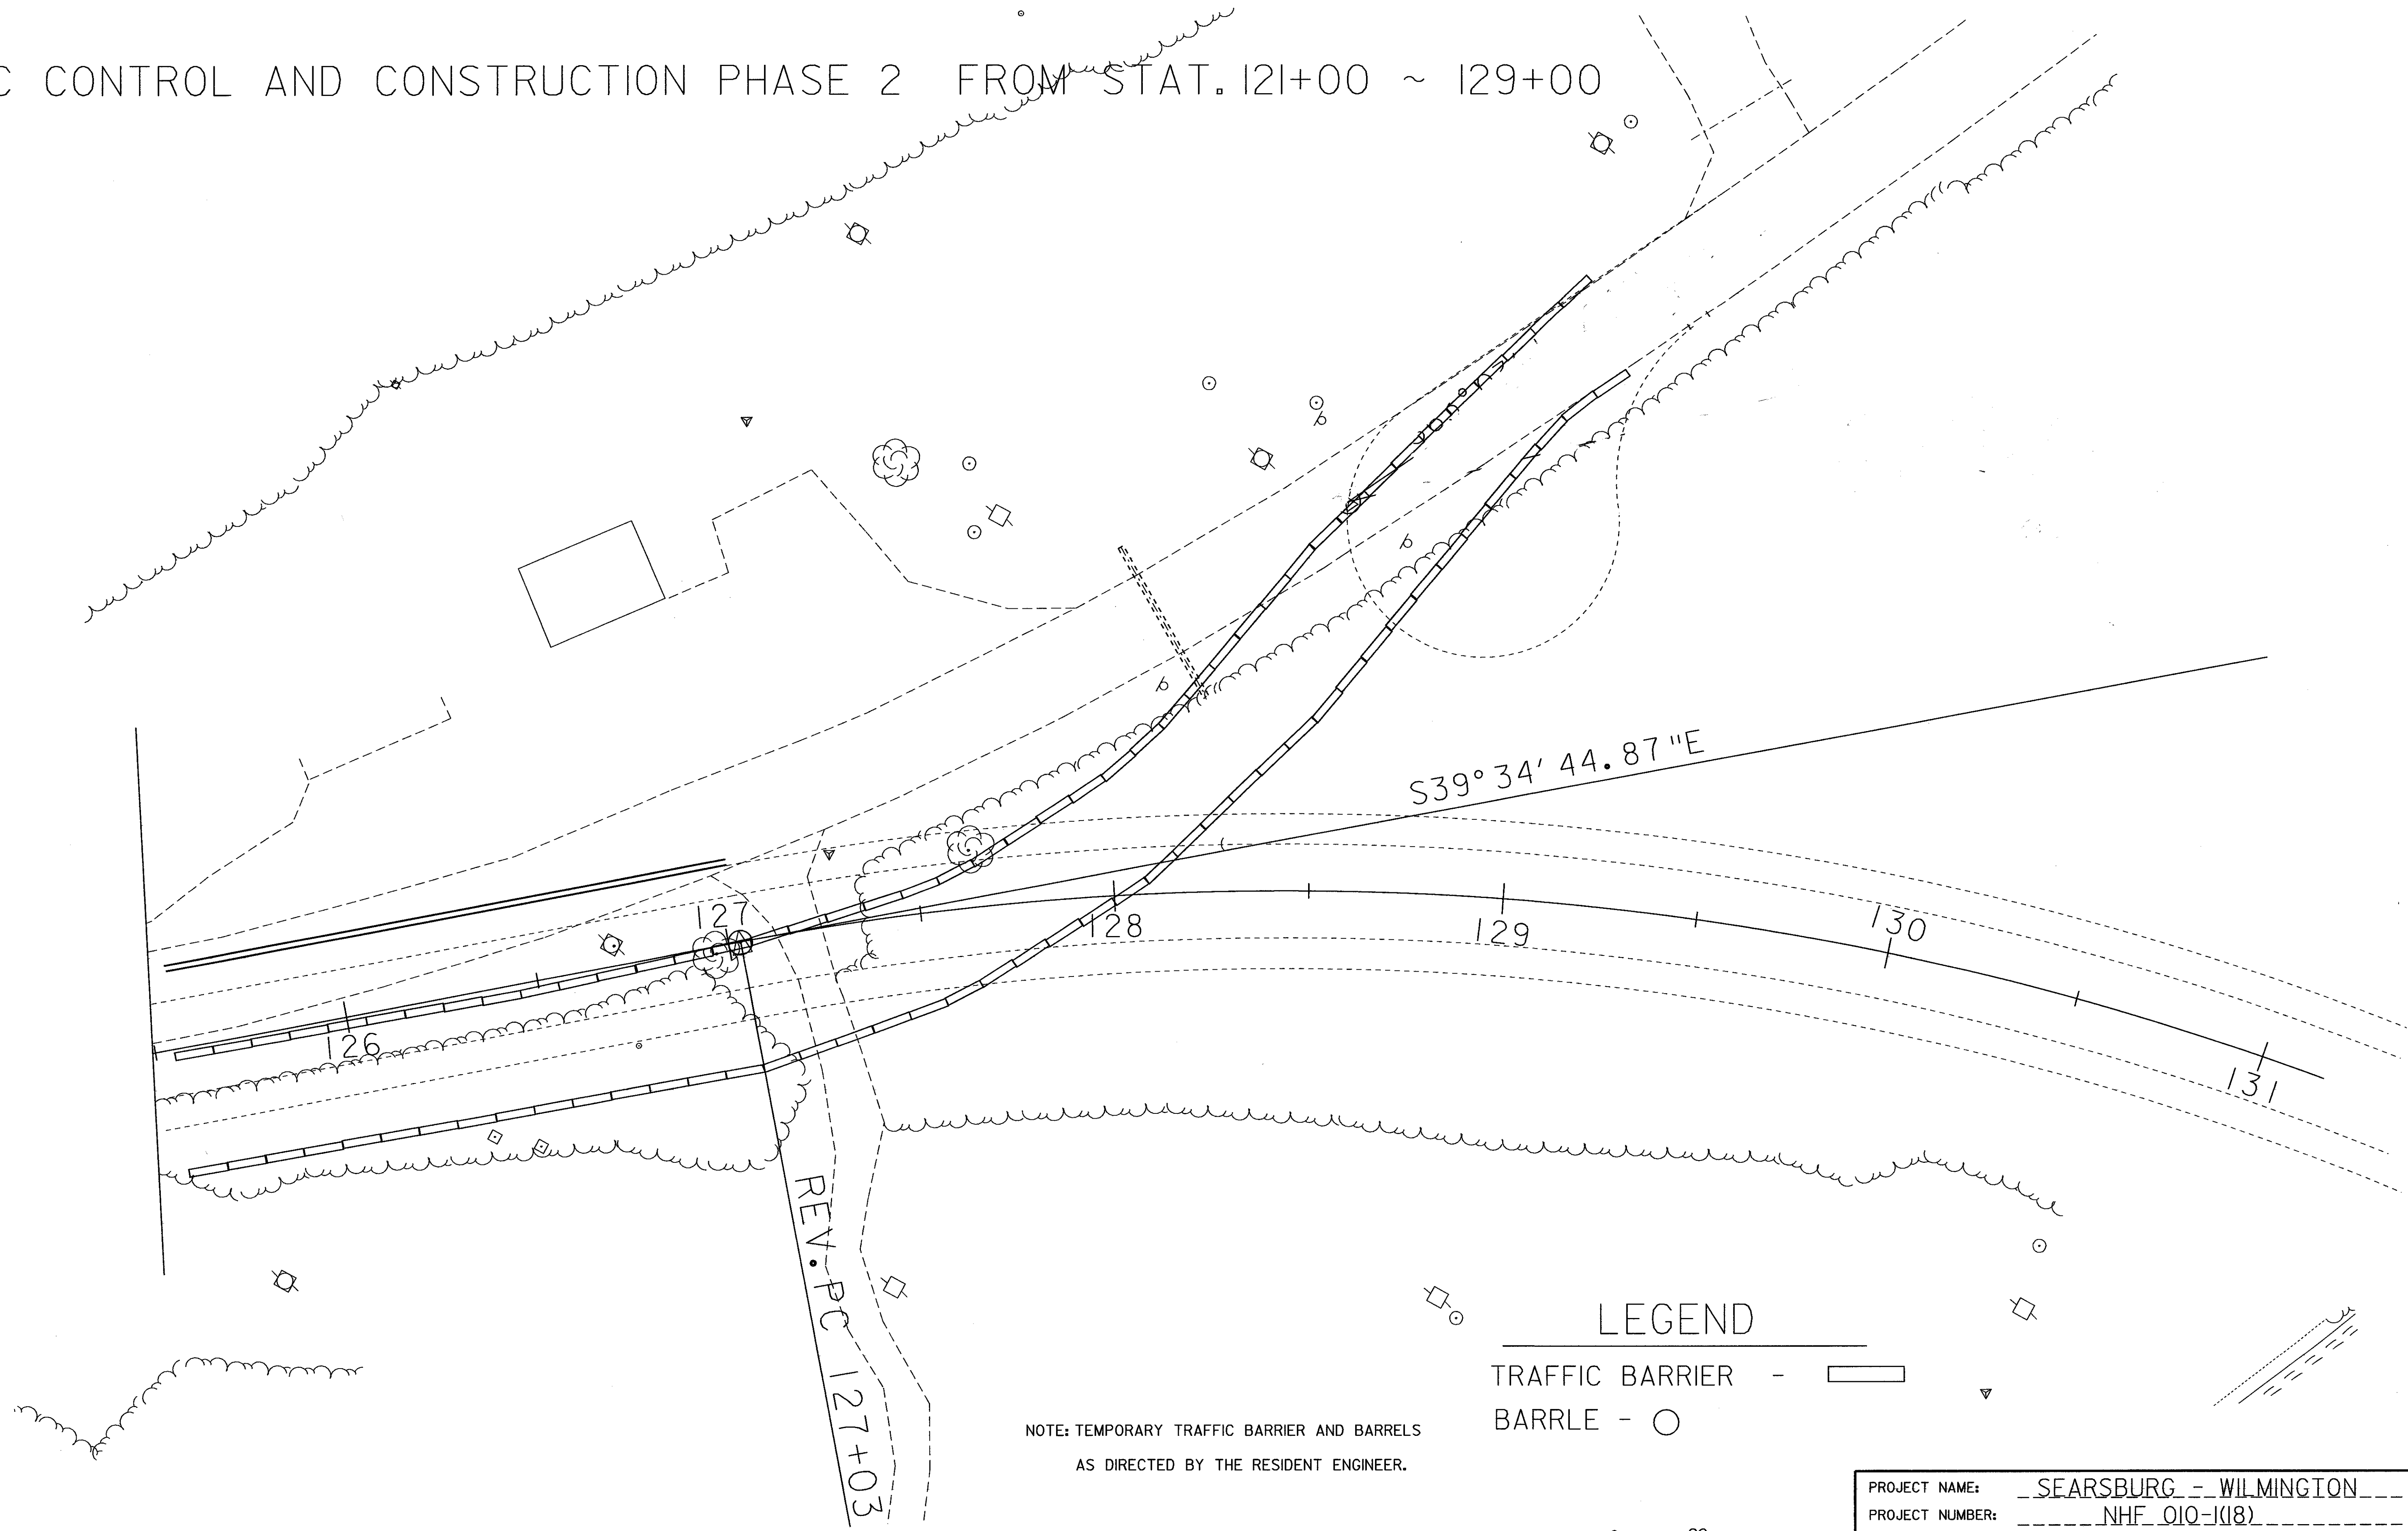


REV. PC 127+03

S39°34'44.87"E

LEGEND

- TRAFFIC BARRIER - [rectangle symbol]
- BARRLE - [circle symbol]

NOTE: TEMPORARY TRAFFIC BARRIER AND BARRELS
AS DIRECTED BY THE RESIDENT ENGINEER.

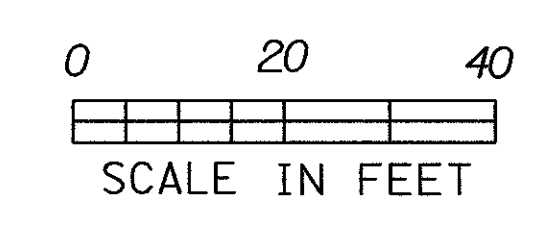

PROJECT NAME: SEARSBURG - WILMINGTON	PLOT DATE: 13-FEB-2002
PROJECT NUMBER: NHF 010-1(18)	DRAWN BY: SQUAD B
FILE NAME: d4096d04	CHECKED BY:
PROJECT LEADER: DELLA SANTA	SHEET 264 OF 435
DESIGNED BY:	
DESIGN FILE NAME: 780096/DESIGN/DET/DET.DGN	