


NOTE:
 DASHED LINE INDICATES SUBSTRUCTURE
 UPSTATION AND/OR DOWNSTATION OF
 SECTION CUT LINE.

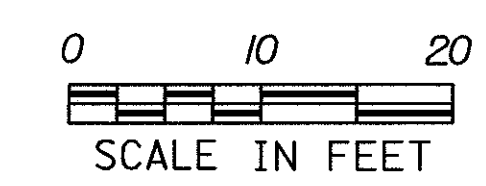

PROJECT NAME:	SEARSBURG - WILMINGTON
PROJECT NUMBER:	NHF 010-1(18)
PLOT FILE NAME:	dd096d09
PROJECT LEADER:	DELLA SANTA
DESIGN FILE NAME:	78D096/DESIGN/Detour.DGN
PLOT DATE:	13-FEB-2002
DRAWN BY:	SQUAD B
SHEET 269 OF 435	