


STA. 145+68 RT ~ 147+28 RT
CONSTRUCT GABION WALL

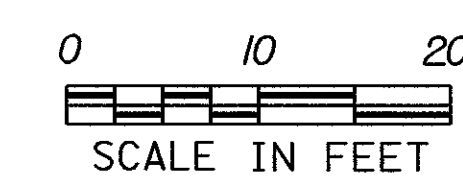

TEMPORARY DETOUR FOR GABION WALLS

PROJECT NAME:	SEARSBURG - WILMINGTON
PROJECT NUMBER:	NHF 010-(18)
PLOT FILE NAME:	DD096X25
PROJECT LEADER:	DELLA SANTA
DESIGN FILE NAME:	78D096/DESIGN/DD096CWRK.DGN
PLOT DATE:	13-NOV-2001
DRAWN BY:	SQUAD B
SHEET 279 OF 435	