


DATE	
BY	
FINAL SURVEY	
SURVEYED	
FLIPPED	
TEMPLATE	
NOTE BOOK	
AREAS CHECKED	
NO.	

DATE	
BY	
ORIGINAL SURVEY	
SURVEYED	
FLIPPED	
TEMPLATE	
NOTE BOOK	
AREAS CHECKED	
NO.	

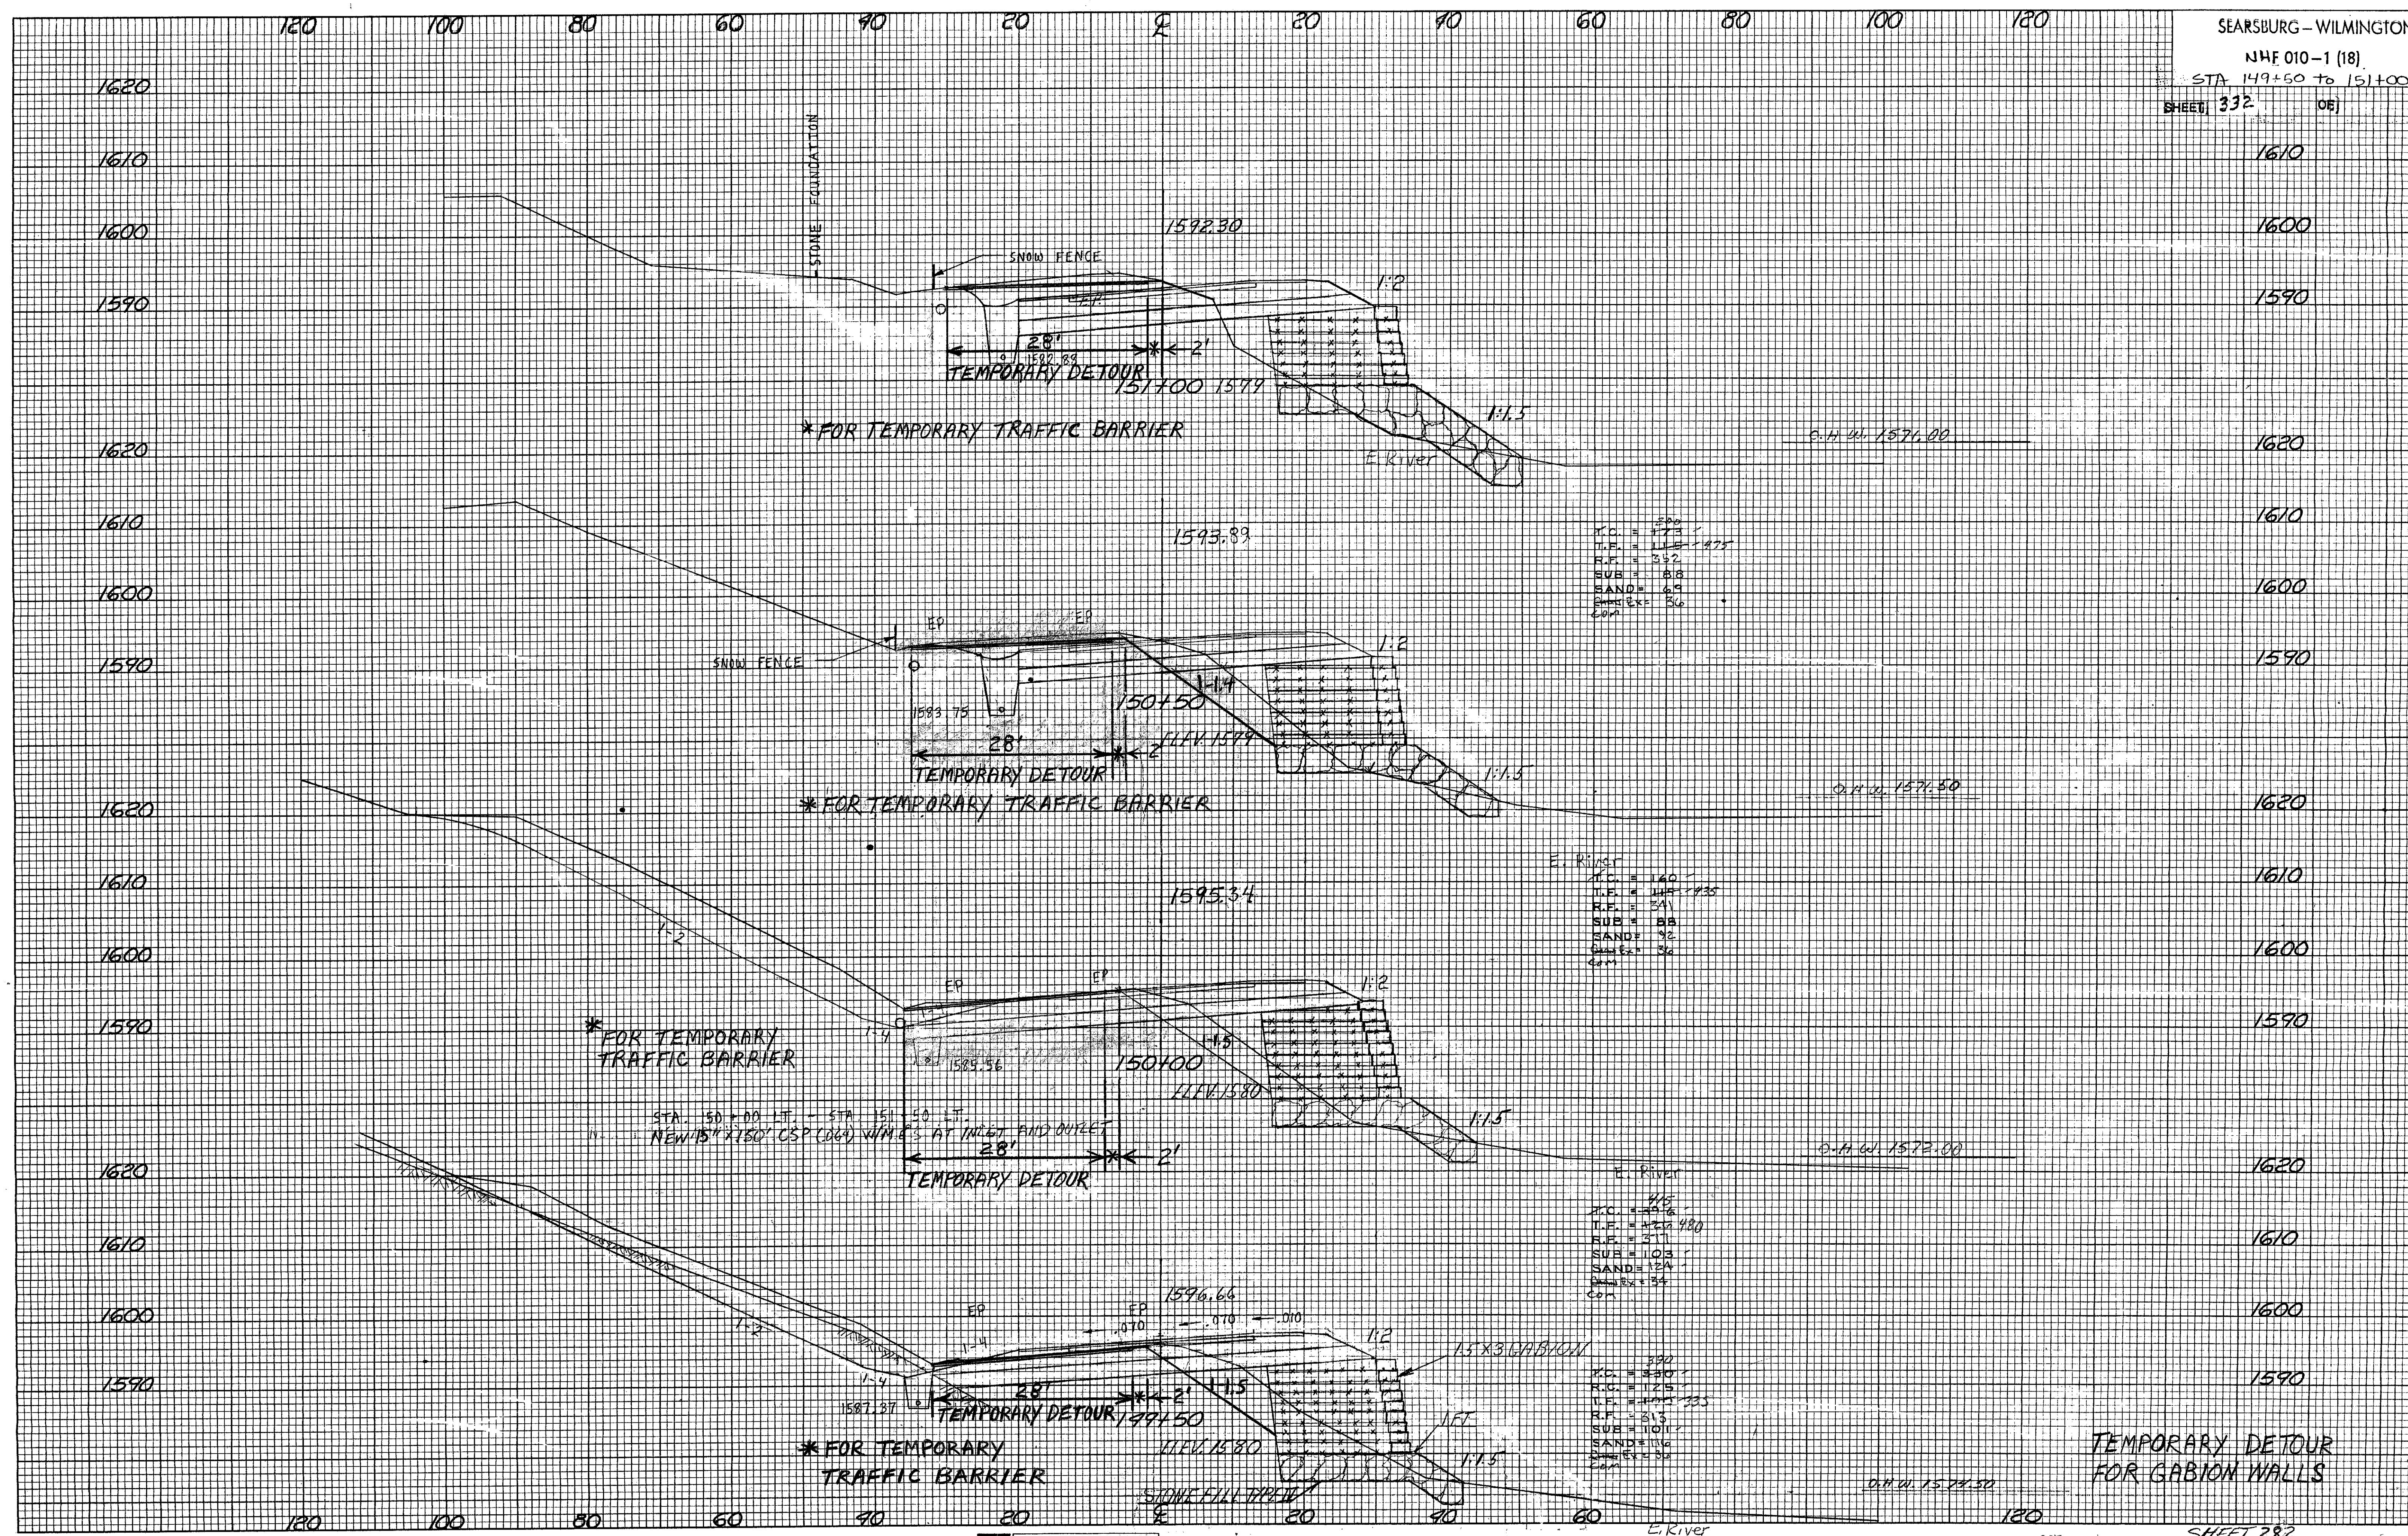

TEMPORARY DETOUR FOR GABION WALLS