


DATE	
BY	
SURVEYED	
PLOTTED	
NOTE BOOK	
AREAS CHECKED	

DATE	
BY	
SURVEYED	
PLOTTED	
NOTE BOOK	
AREAS CHECKED	

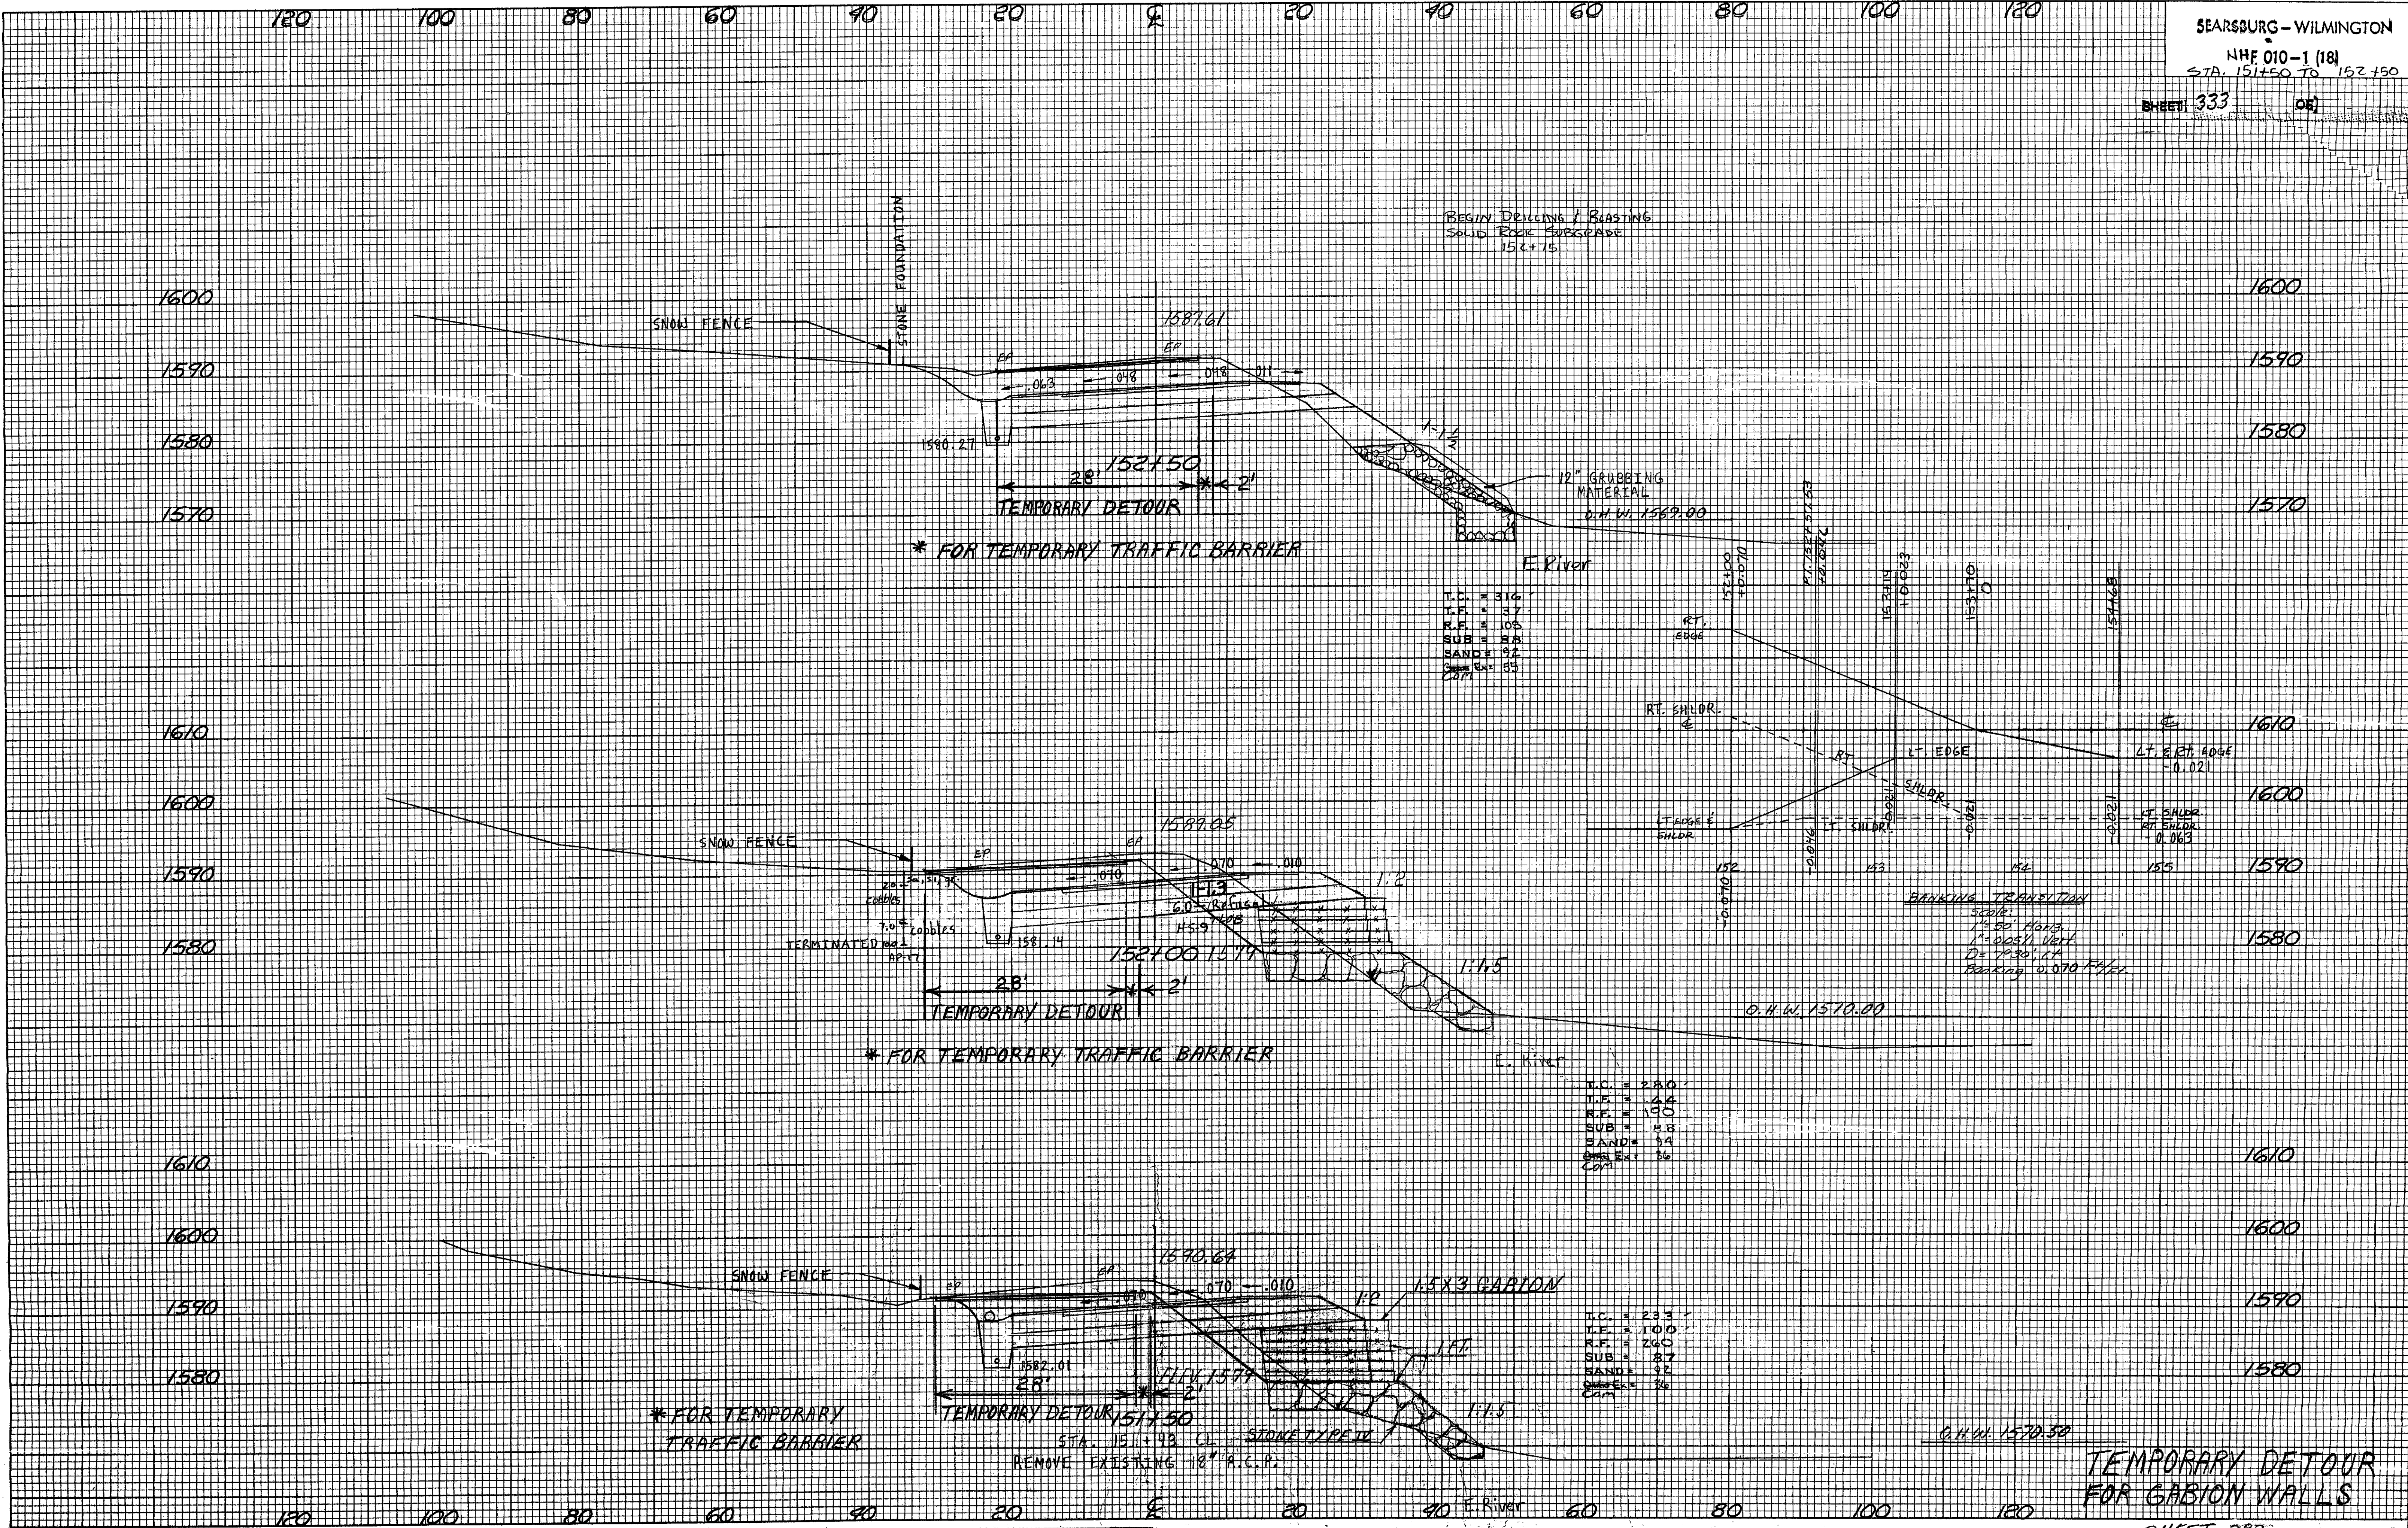

BEGIN DRILLING / BLASTING SOLID ROCK SUBGRADE 152+75

T.C. = 316
 T.F. = 37
 R.F. = 108
 SUB = 88
 SAND = 92
 GRAVEL = 35

T.C. = 280
 T.F. = 44
 R.F. = 170
 SUB = 88
 SAND = 74
 GRAVEL = 36

T.C. = 233
 T.F. = 100
 R.F. = 260
 SUB = 87
 SAND = 92
 GRAVEL = 36

TEMPORARY DETOUR FOR GABION WALLS