



GABION WALL
ML STA. 145+68 RT-147+28 RT

SNOW FENCE
"NO DISTURBANCE AREA"
(SEE SPECIAL PROVISIONS)
ML STA. 145+50 RT-148+25 RT


PLAN VIEW

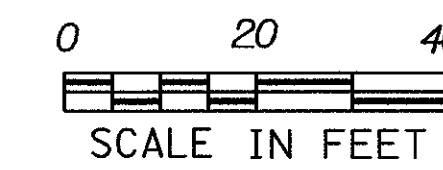

NOTE: NO CONSTRUCTION EQUIPMENT SHALL BE ALLOWED BEYOND THE TOE OF SLOPE LIMIT FROM ML STA. 145+50 RT-148+25 RT.

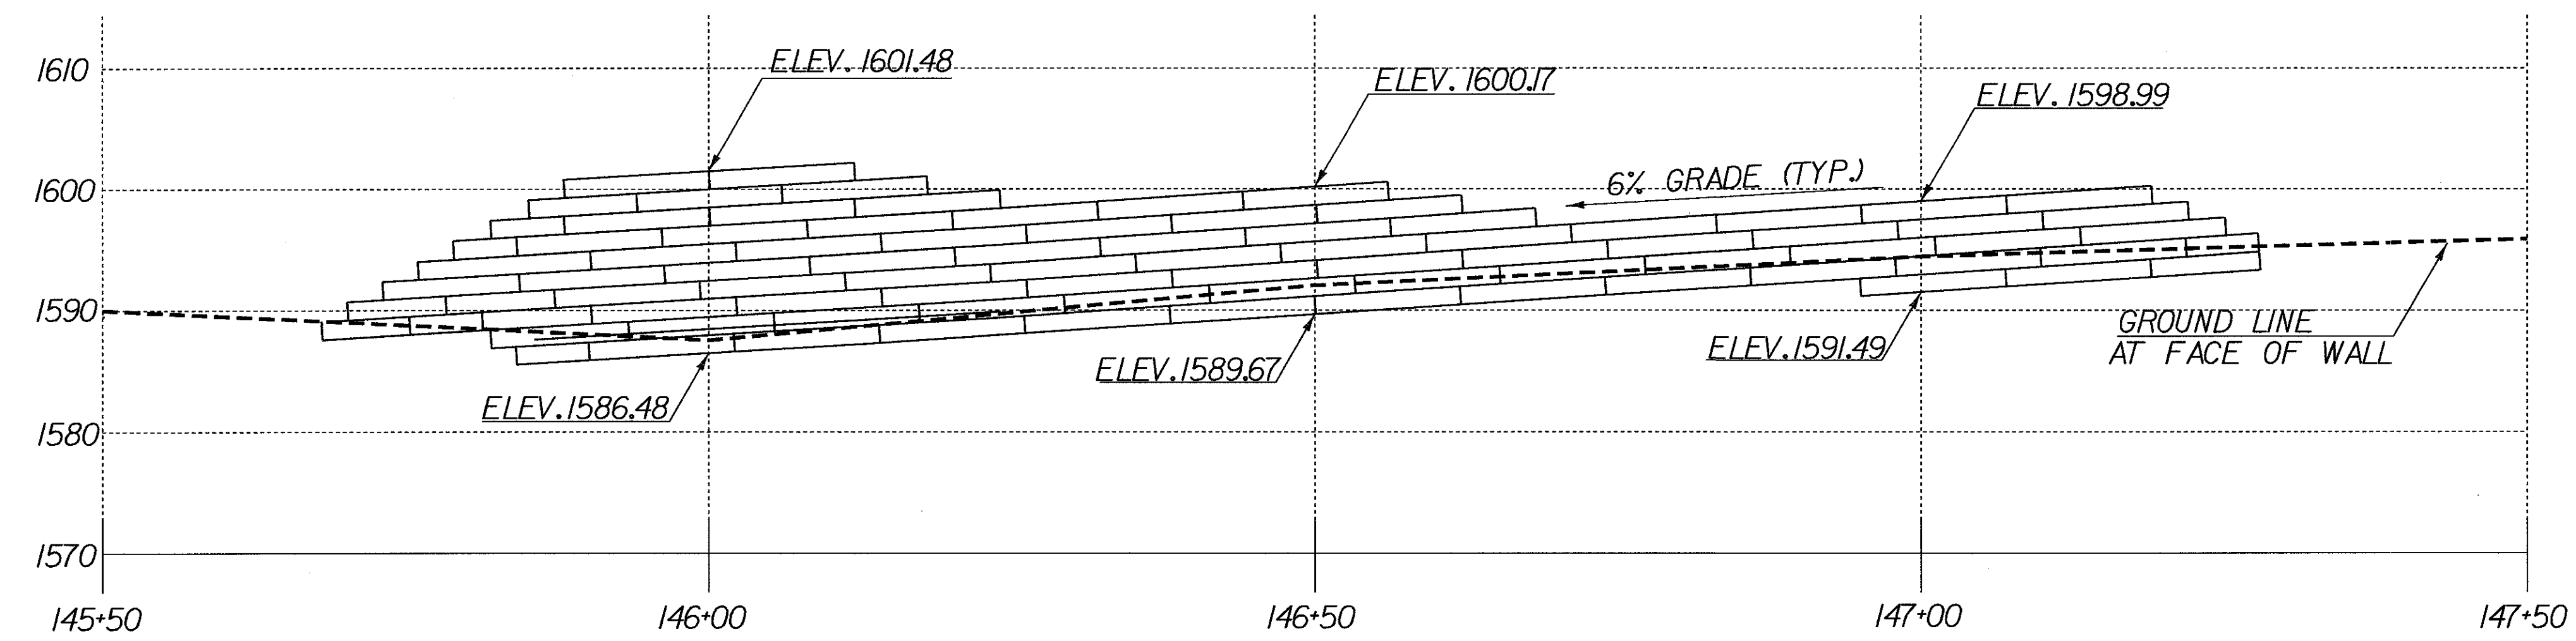

ELEVATION

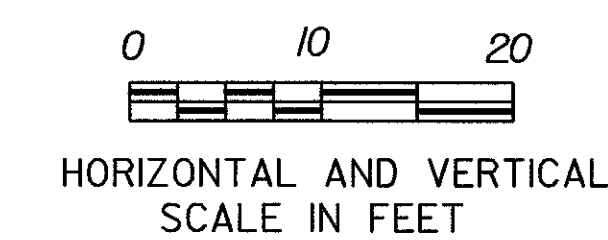

GABION MATERIALS:
SEE SPECIAL PROVISIONS

GABION WALL AT
STA. 145+68 - 147+28 RT.

SURVEYED BY	SQUAD B	DATE	8-4-92
DRAWN BY	DELLA SANTA	DATE	8-4-92
SQUAD LEADER	DELLA SANTA		
DESIGN FILE NO.	/78D096/DESIGN/DD096.DGN		
IPARM FILE	DD096GBI	DATE PLOTTED	14-FEB-2002
PROJ. NAME	SEARSBURG-WILMINGTON		
PROJ. NO.	NHF 010-(18)		
SHEET	284	OF	435 SHEETS