


GABION MATERIALS:
SEE SPECIAL PROVISIONS

ELEVATION

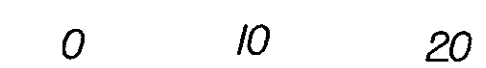

HORIZONTAL AND VERTICAL
SCALE IN FEET

GABION WALL AT
STA. 148+75 - 152+25 RT.

SURVEYED BY	SQUAD B	DATE	8-4-92
DRAWN BY	DELLA SANTA	DATE	8-4-92
SQUAD LEADER			
DESIGN FILE NO.	/78D096/DESIGN/DD096.DGN		
IPARM FILE	DD096GB2	DATE PLOTTED	14-FEB-2002
PROJ. NAME	SEARSBURG-WILMINGTON		
PROJ. NO.	NHF 010-(18)		
SHEET	285	OF	435 SHEETS