


THIS SHEET IS FOR WETLANDS AND RARE AND ENDANGERED SPECIES ONLY

DATE: _____
 DRAWN BY: _____
 CHECKED BY: _____
 PLAN
 SURVEYED: _____
 ALIGNED: _____
 NOTE BOOK: _____
 NO. _____

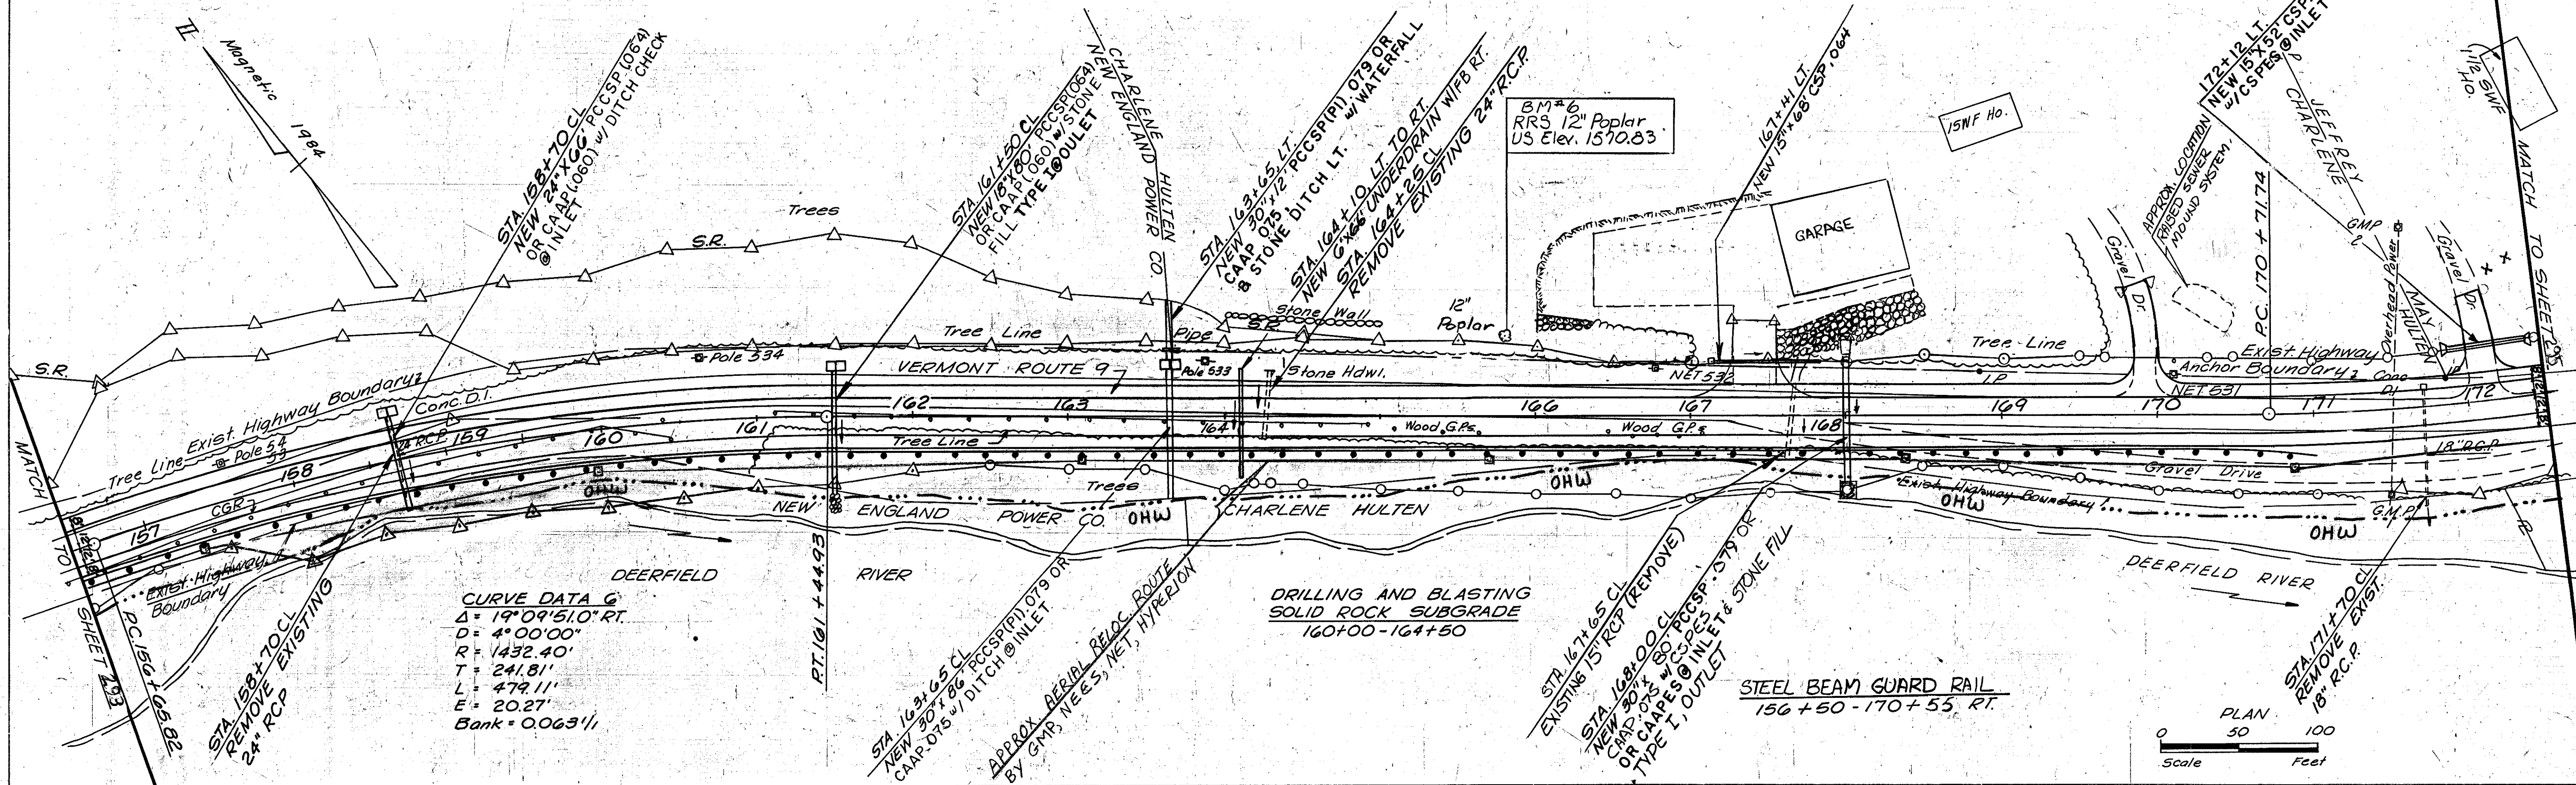

DATE: _____
 DRAWN BY: _____
 CHECKED BY: _____
 PROFILE
 SURVEYED: _____
 GRADE CHECKED: _____
 NOTE BOOK: _____
 NO. _____

